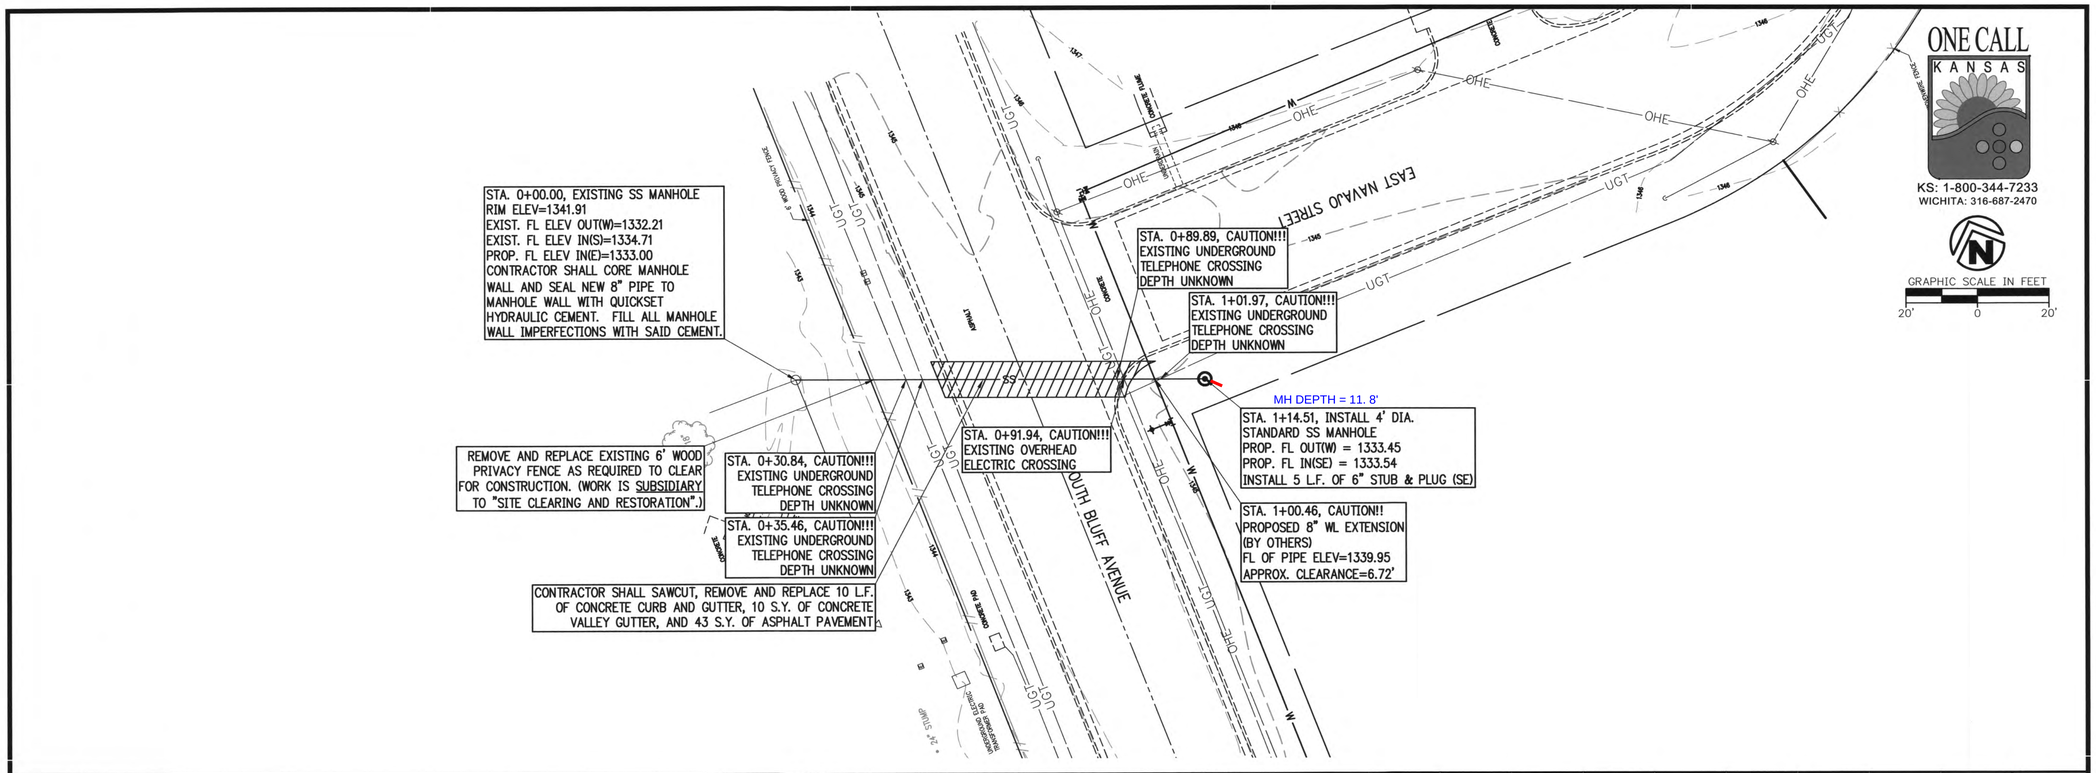

8200 E. 34th St. N., Bldg. #1600, Suite #1603
Wichita, Kansas 67226
Crafton Tull Sparks
architecture | engineering
316.634.6776 1 316.634.6777 1
www.craftontullsparks.com

CERTIFICATE OF AUTHORIZATION:
CA 6-341 EXPIRES 12/31/2009

CITY OF WICHITA
SANITARY SEWER

NAVAJO & BLUFF, 31ST S
Wichita, KS

Key Plan

No.	Description	Date

This document, and the ideas and designs incorporated herein, as an instrument of professional service, is the property of Crafton, Tull, Sparks & Associates, Inc., and is not to be used, in whole or in part, for any other project, without the written authorization of Crafton, Tull, Sparks & Associates, Inc.

PROJECT NO: 083012-00
ISSUE DATE: 01/13/09
CONTACT: J. MOHLER
CHECKED BY: JCM

JASON C. MOHLER
LICENSED
18722
KANSAS
PROFESSIONAL ENGINEER
1/13/09

ISSUED FOR CONSTRUCTION

© 2009 Crafton, Tull, Sparks & Associates, Inc.

SANITARY SEWER P&P

05

DRAWING: G:\083012-00\IND\DWG\05 & 06 P&P.DWG
LAYOUT: 05 P&P LAST SAVED: SA30DAL 1/13/2009 1:28:11 AM
LAYOUT: 05 PLOTTED BY: CRAFTON-JASON 1/13/2009 1:28:11 AM PLOTTED BY: * VALID ON HARD COPY ONLY!