



SEWER SERVICE TABLE

NUMBER	TYPE	LOCATION			STATION\ DIRECTION	FOR INFORMATION ONLY	
		LOT NO.	BLOCK NO.	LINE NO.		APPROXIMATE LENGTH 4" PIPE	VERTICAL
1	8" X 4" Tee Saddle	48	3	1	3+23/Lt.	6.0'	15'
2	8" X 4" Tee Saddle	47	3	1	3+80/Lt.	6.0'	15'
3	8" X 4" Tee Saddle	46	3	1	4+00/Lt.	6.0'	15'
4	8" X 4" Tee Saddle	45	3	1	4+84/Lt.	6.0'	15'
5	8" X 4" Tee Saddle	44	3	1	5+04/Lt.	6.0'	15'
6	8" X 4" Tee Saddle	43	3	1	5+56/Lt.	6.0'	15'

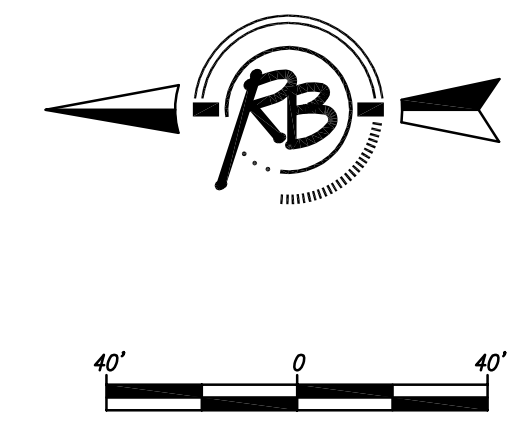


WILLOW CREEK EAST 2ND ADDITION

WILLOW CREEK EAST 2ND ADDITION

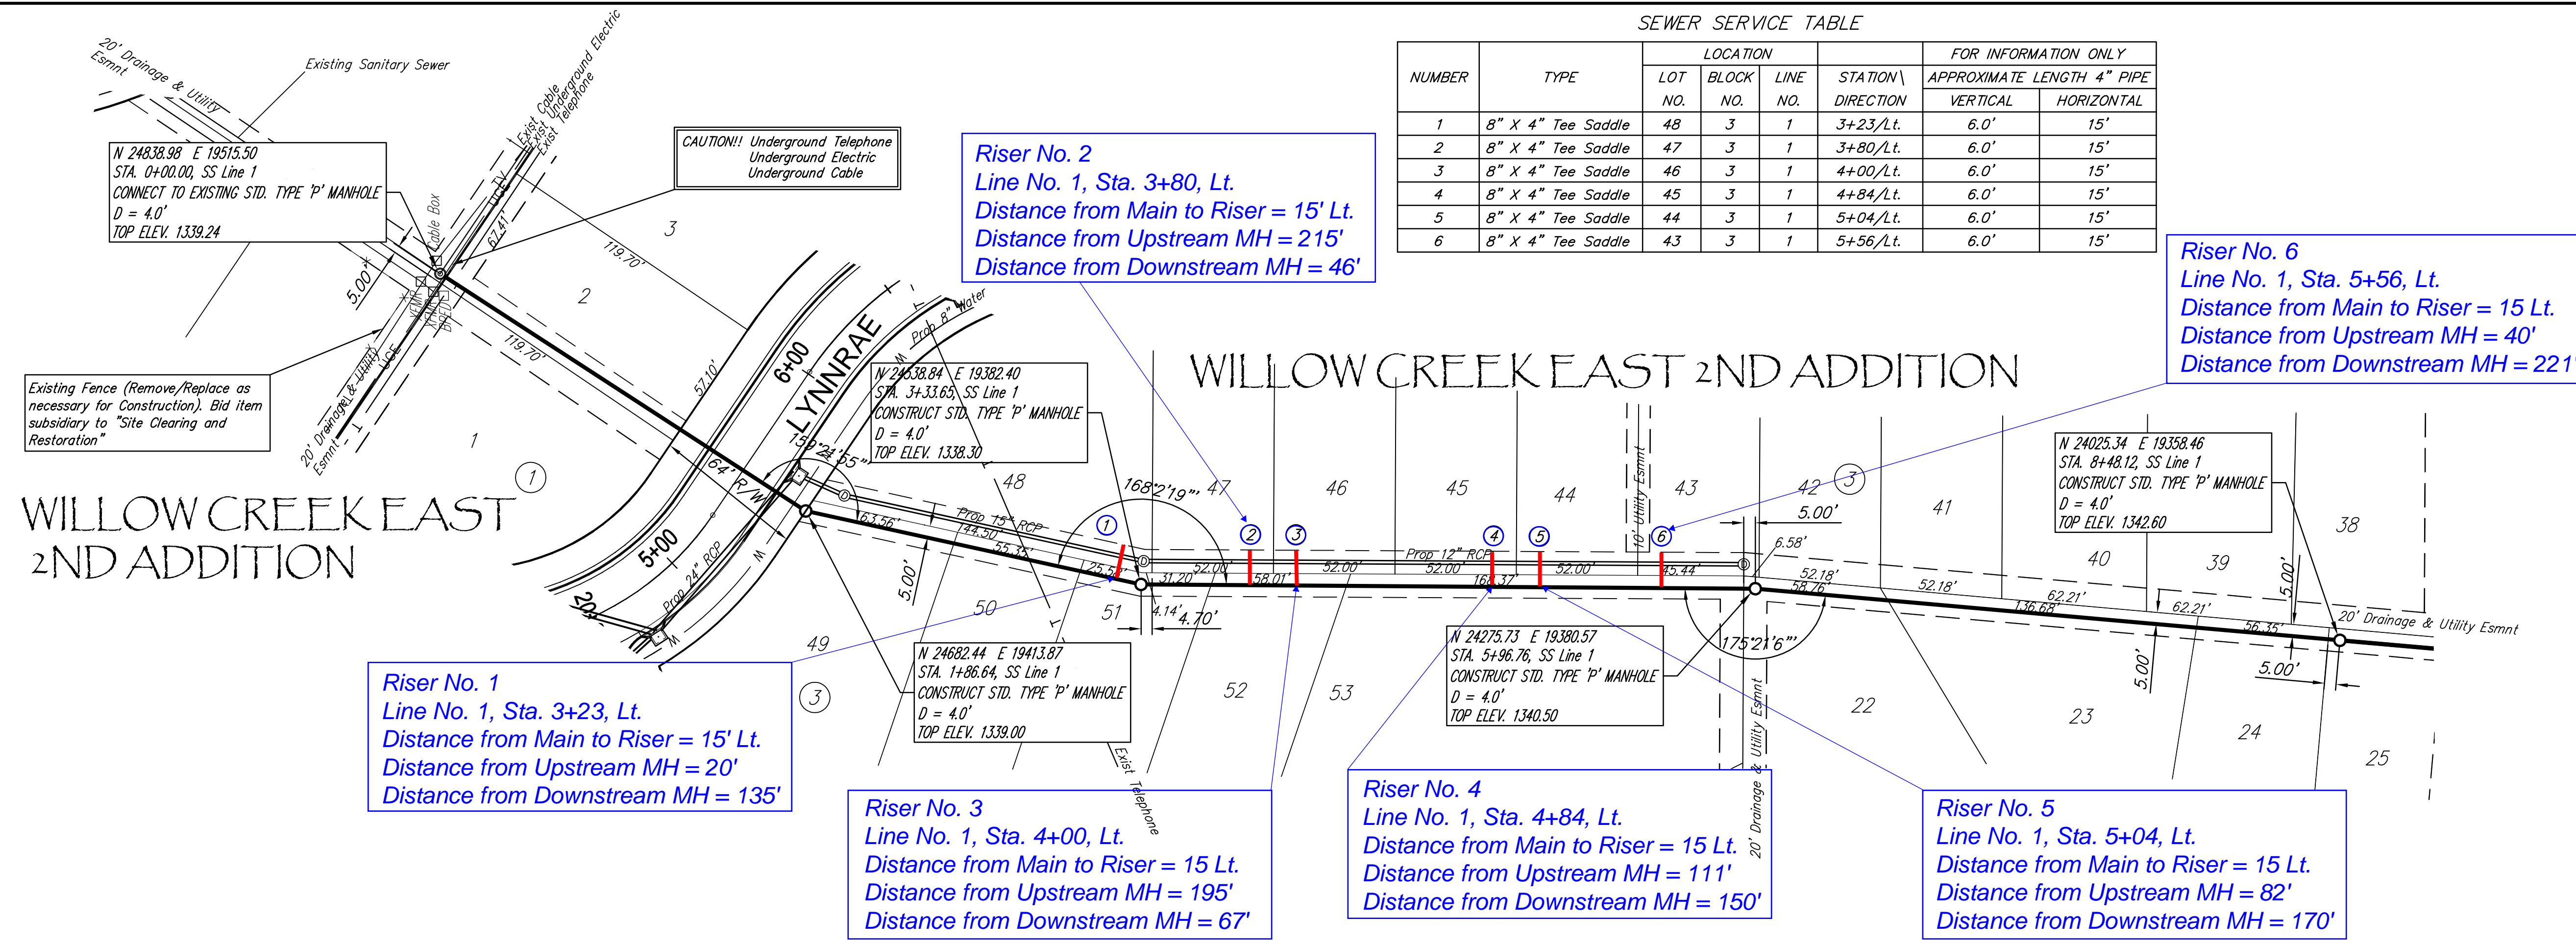

LINE 1

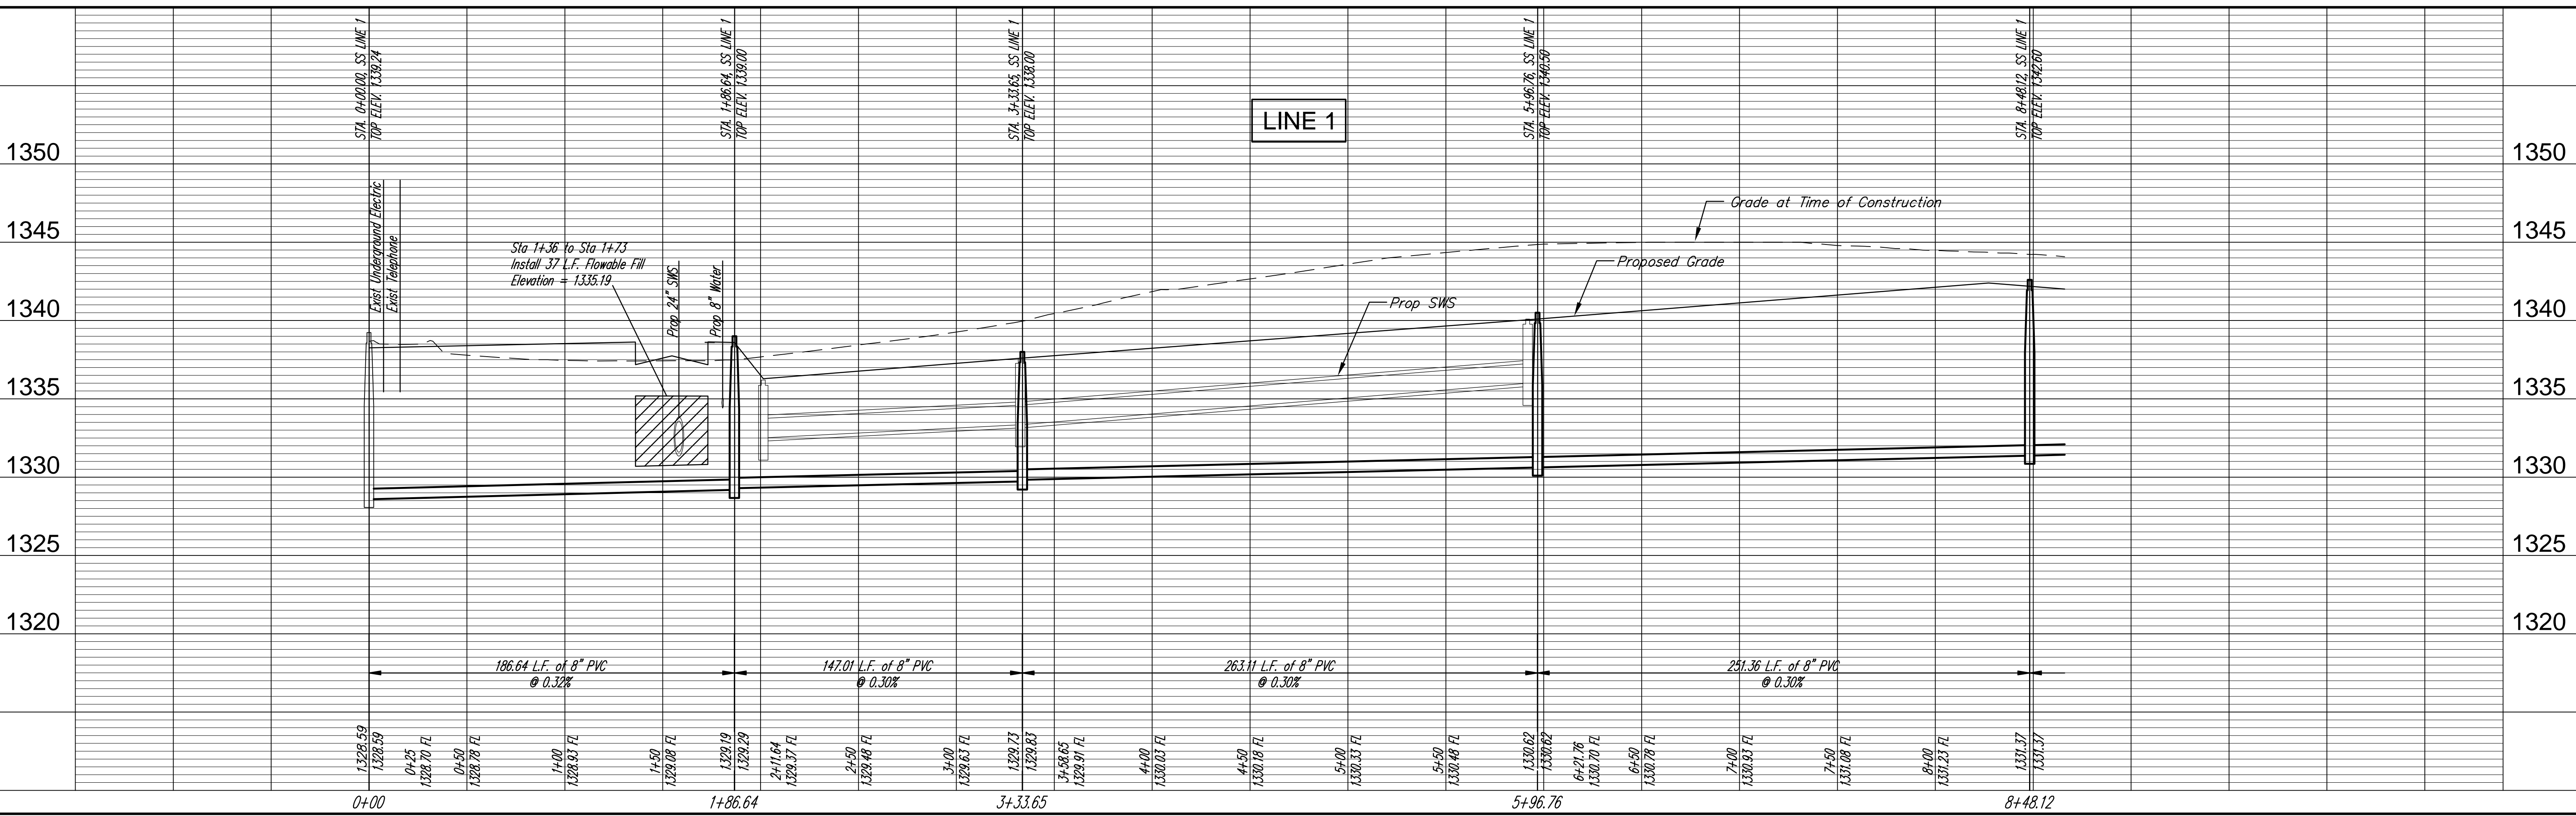

REVISIONS

REVISION	DATE	BY
REVIEW	Feb. 26, 2009	RLS

DESIGN: AML
DRAWN: RLS
PROJECT NUMBER: 468-84553
DRAWING FILE: [Eng Base]

SANITARY SEWER LINE 1
Willow Creek East 2nd Addition
WICHITA KANSAS

RB JOB 3324E
SHEET 2 OF 15

Ruggles & Bohm, P.A.
Engineering, Surveying, Land Planning
