


SEWER SERVICE TABLE

NUMBER	TYPE	LOCATION			STATION \ DIRECTION	FOR INFORMATION ONLY	
		LOT NO.	BLOCK NO.	LINE NO.		APPROXIMATE LENGTH 4" PIPE	VERTICAL
7	8" X 4" Tee Saddle	35	3	1	10+58/Lt.	5.0'	15'
8	8" X 4" Tee Saddle	34	3	1	10+78/Lt.	5.0'	15'
9	8" X 4" Tee Saddle	33	3	1	11+63/Lt.	5.5'	15'
10	8" X 4" Tee Saddle	32	3	1	11+83/Lt.	5.5'	15'

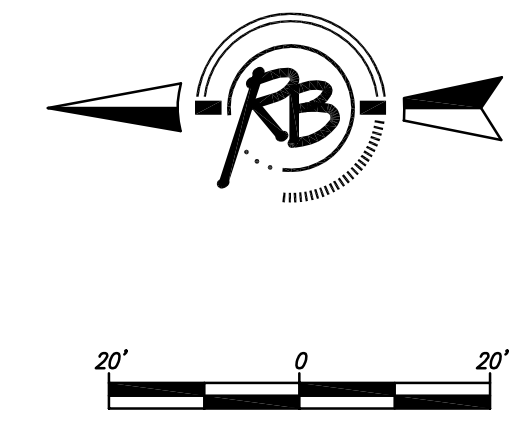



**Riser No. 7**  
Line No. 1, Sta. 10+58, Lt.  
Distance from Main to Riser = 15' Lt.  
Distance from Upstream MH = 181'  
Distance from Downstream MH = 208'

**Riser No. 8**  
Line No. 1, Sta. 10+78, Lt.  
Distance from Main to Riser = 15' Lt.  
Distance from Upstream MH = 167'  
Distance from Downstream MH = 228'

**Riser No. 10**  
Line No. 1, Sta. 11+83, Lt.  
Distance from Main to Riser = 15' Lt.  
Distance from Upstream MH = 62'  
Distance from Downstream MH = 331'

**Riser No. 9**  
Line No. 2, Sta. 0+63.10  
Distance from Upstream MH = 0'  
Distance from Downstream MH = 4'

**Riser No. 9**  
Line No. 1, Sta. 11+63, Lt.  
Distance from Main to Riser = 15' Lt.  
Distance from Upstream MH = 82'  
Distance from Downstream MH = 312'

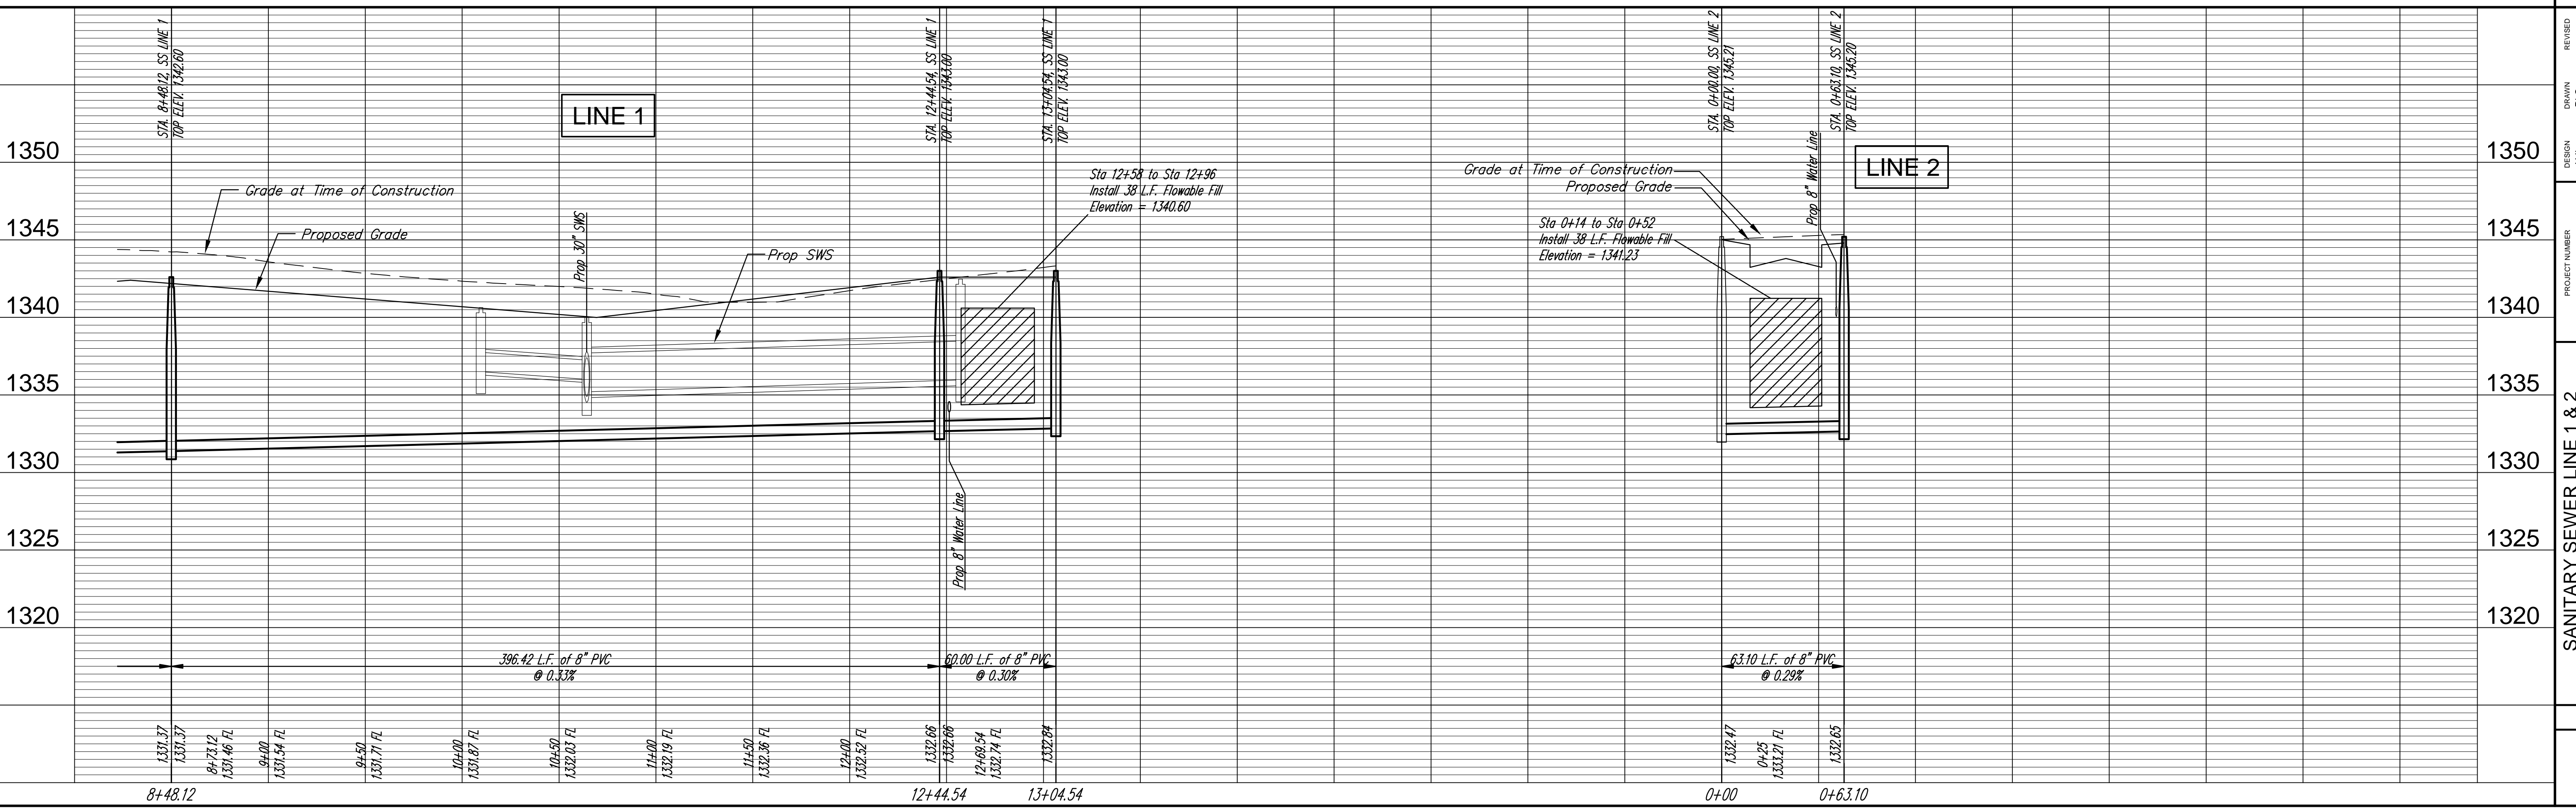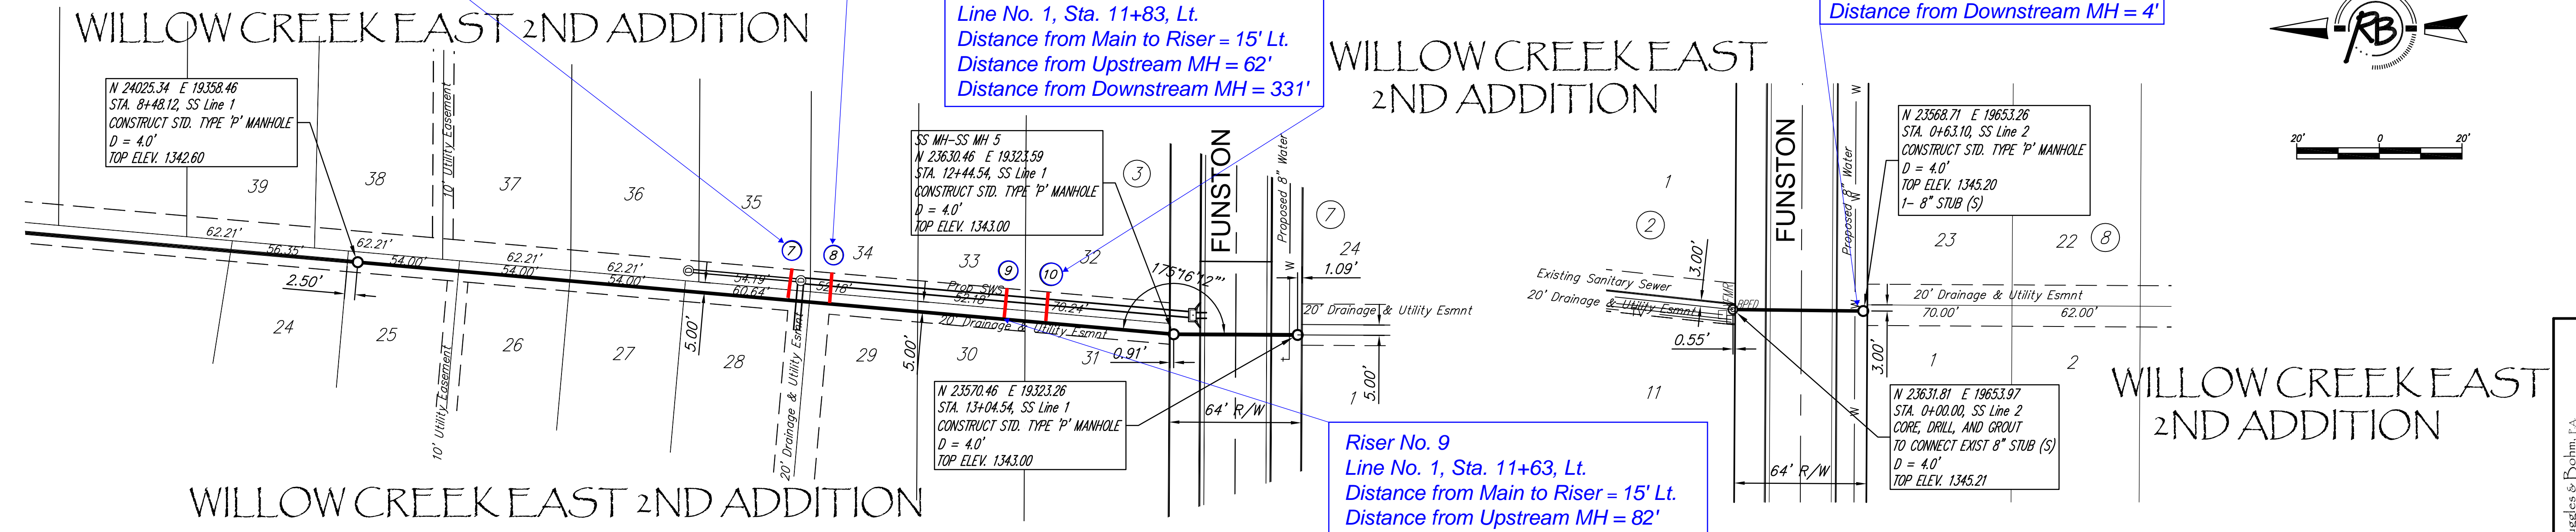

PROJECT NUMBER: 468-84553  
 DRAWING FILE: [Eng Base]  
 DESIGN: AML  
 DRAWN: RLS  
 REVIEWED: RLS  
 DATE: Feb. 26, 2009  
 UTILITY REVIEW  
 SANITARY SEWER LINE 1 & 2  
 Willow Creek East 2nd Addition  
 WICHITA KANSAS  
 RB JOB 3324E  
 SHEET 3 OF 15