BENCHMARK:

BM #2 – Chiseled "+" Located in the Northeast Corner of the Intersection of Wabash and 1st Street North, 30.0' East and 34.8' North of the Centerline of Both.
Elev. = 1295.76 (MSL)

BM #3 – Chiseled "□" Located on the Southeast Curb Return at the Intersection of Douglas and Ida, 41.60' South and 26.5' East of the Centerline of Both.
Elev. = 1295.59 (MSL)

The Contractor shall Remove the Existing Traffic Interconnect System and Manholes as Necessary for the SS Construction. The System Shall be Replaced During the Paving of Wabash.

Note: See Waterline & Profile Sheet #30

SCALE:
1" = 20' HORIZONTAL
1" = 5' VERTICAL

Note: Abandoned 15" SS line as directed by B. Perkins, (8/29/2008)

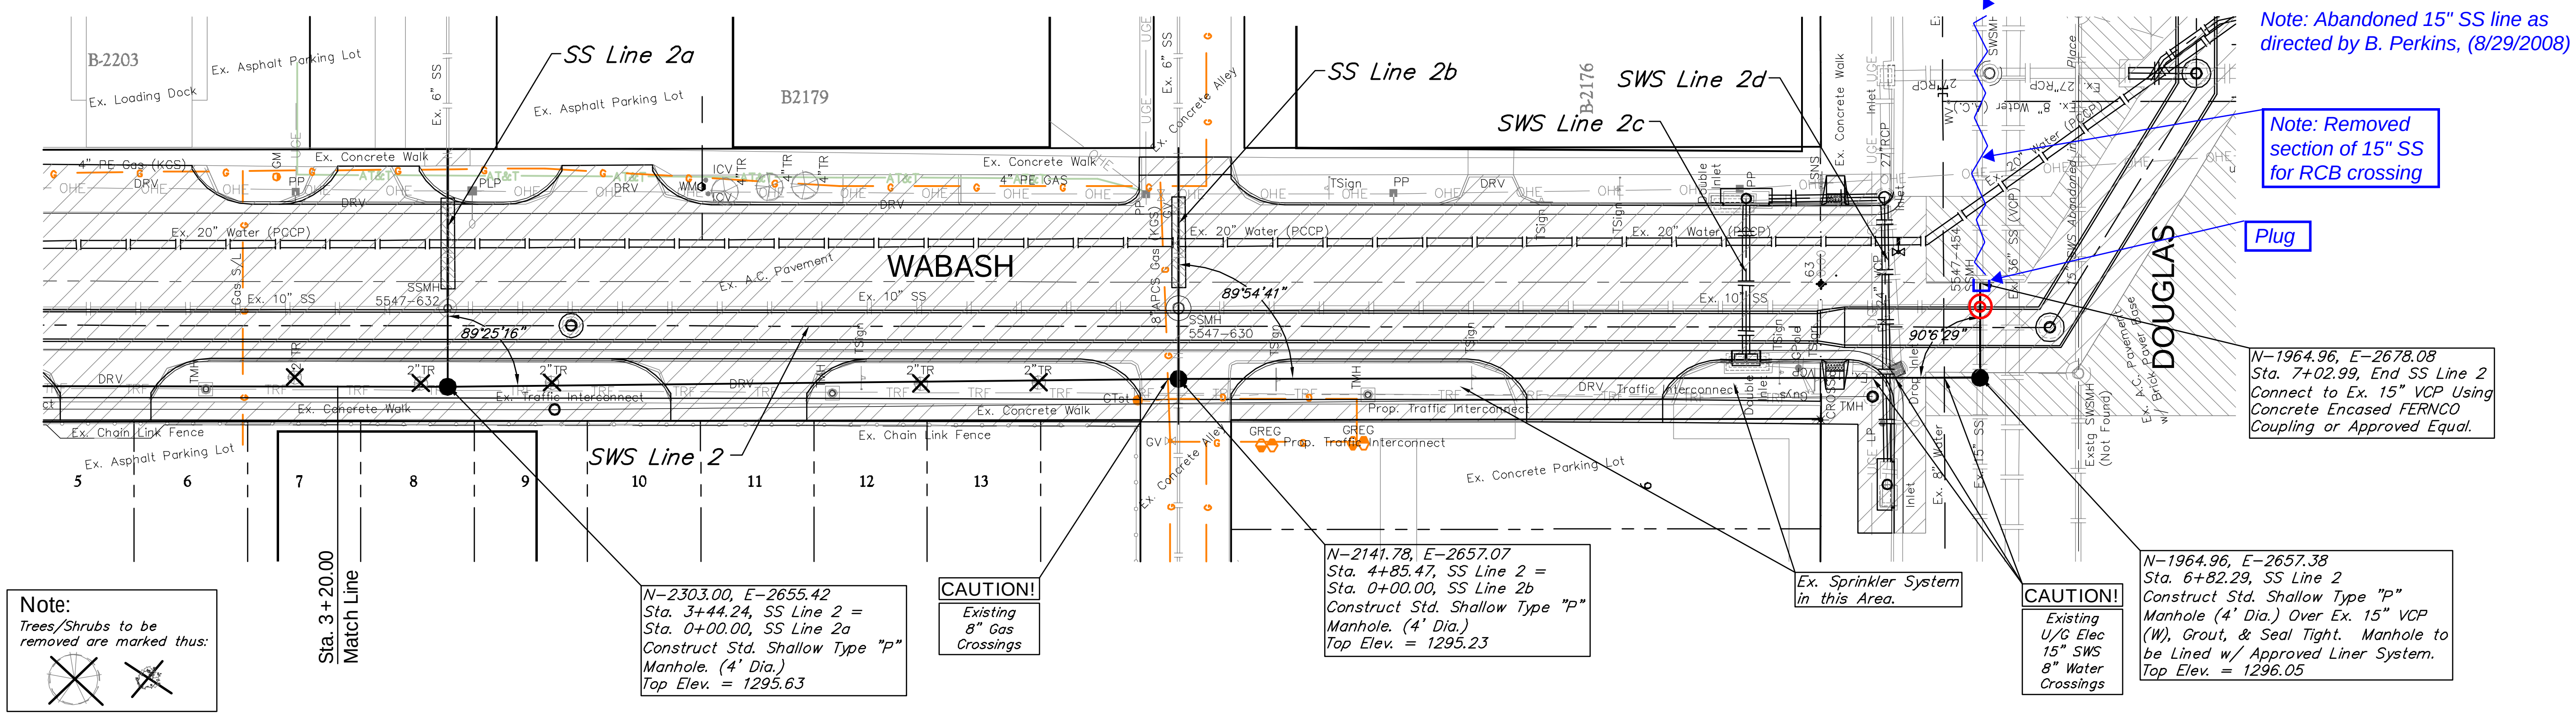

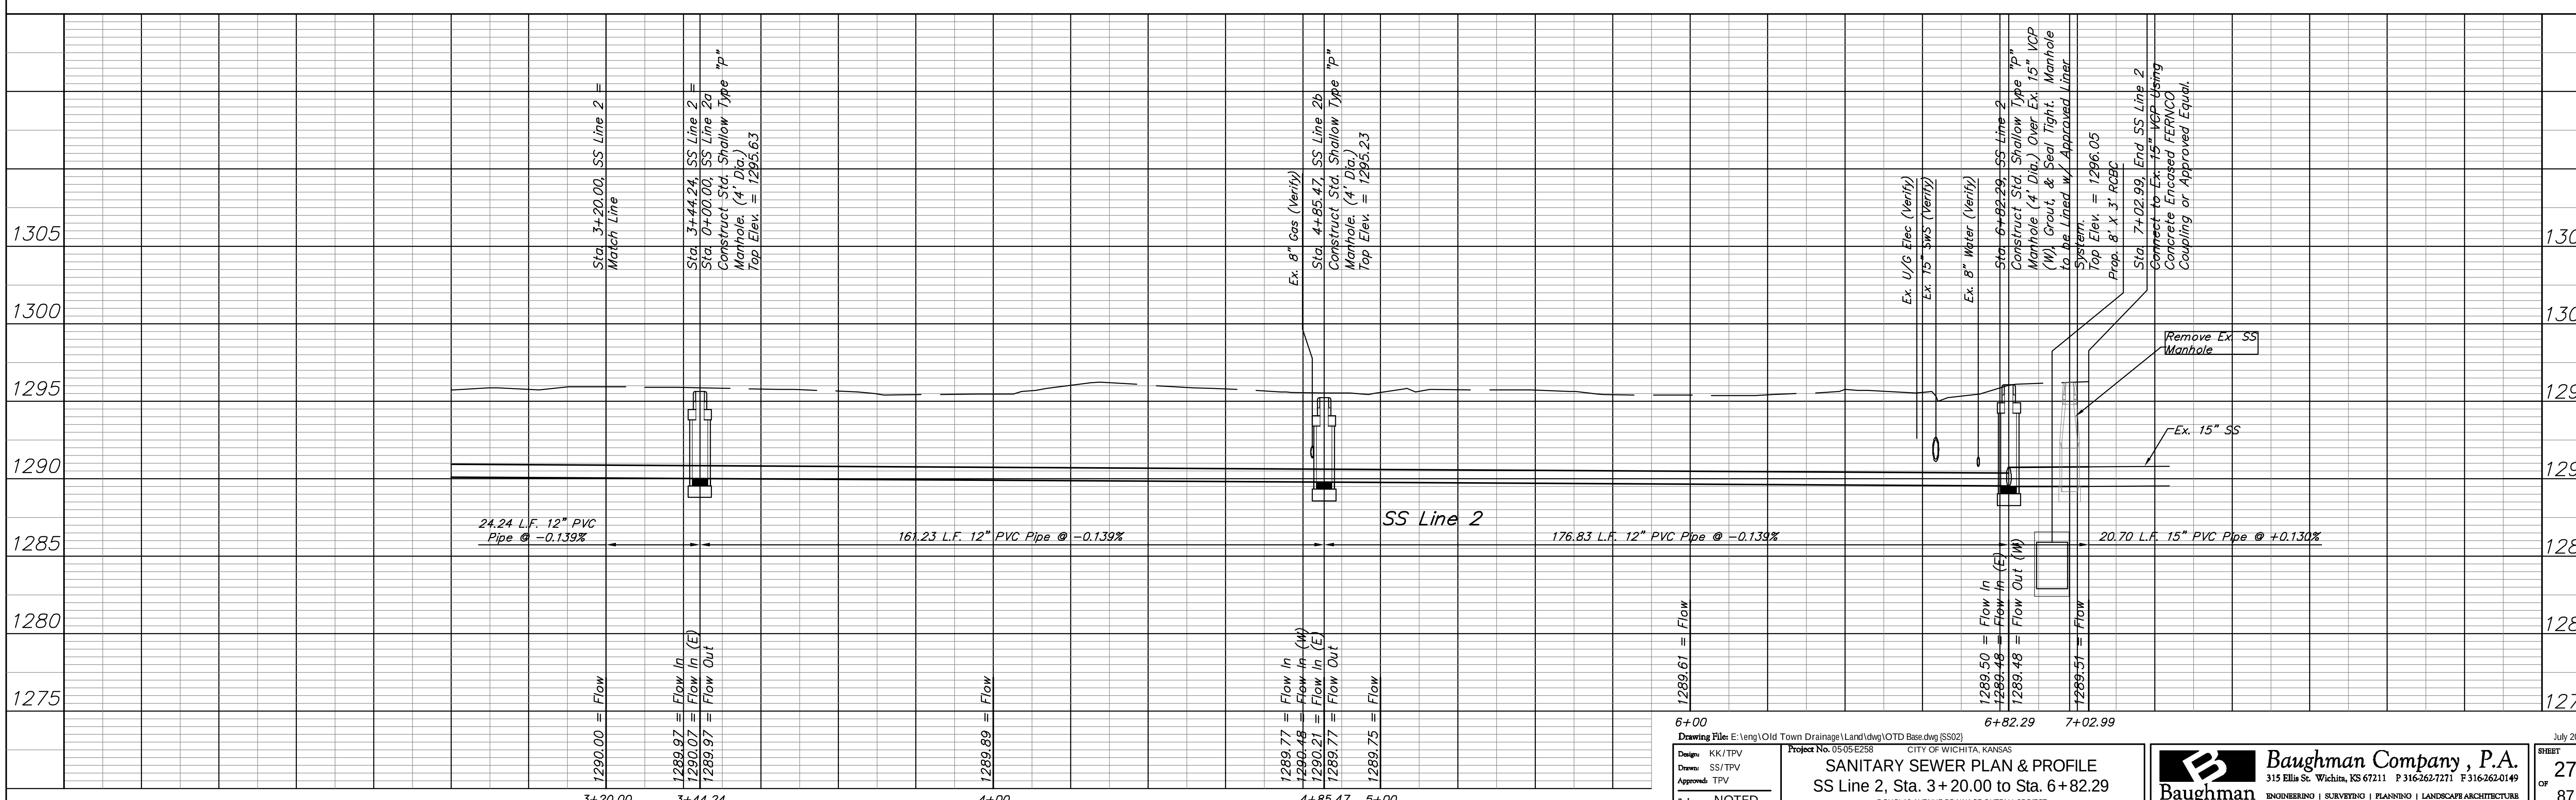

Drawing File: E:\eng\Old Town Drainage\Land\dwg\OTD Base.dwg {SS02}

July 2007

Design:	KK/TPV
Drawn:	SS/TPV
Approved:	TPV
S 1	NOTED

Project No. 05-05-E258 CITY OF WICHITA, KANSAS

SANITARY SEWER PLAN & PROFILE
SS Line 2, Sta. 3+20.00 to Sta. 6+82.29

DOUGLAS AVENUE DRAINAGE OUTFALL PROJECT

Baughman Company, P.A.
315 Ellis St. Wichita, KS 67211 P 316-262-7271 F 316-262-0149
ENGINEERING | SURVEYING | PLANNING | LANDSCAPE ARCHITECTURE