


**MT VERNON STREET AND  
DRAINAGE IMPROVEMENTS  
FROM GREENWAY TO BROADWAY**

**Sanitary Sewer  
Line 3**  
SHEET TITLE 472-84289  
448-90385  
468-84514  
PROJECT NUMBER

DESIGN BY JRA  
DRAWN BY JSB  
CHECKED BY JRA


ISSUED  
May 27, 2008  
REVISED

SHEET NO.  
**74 of 120**

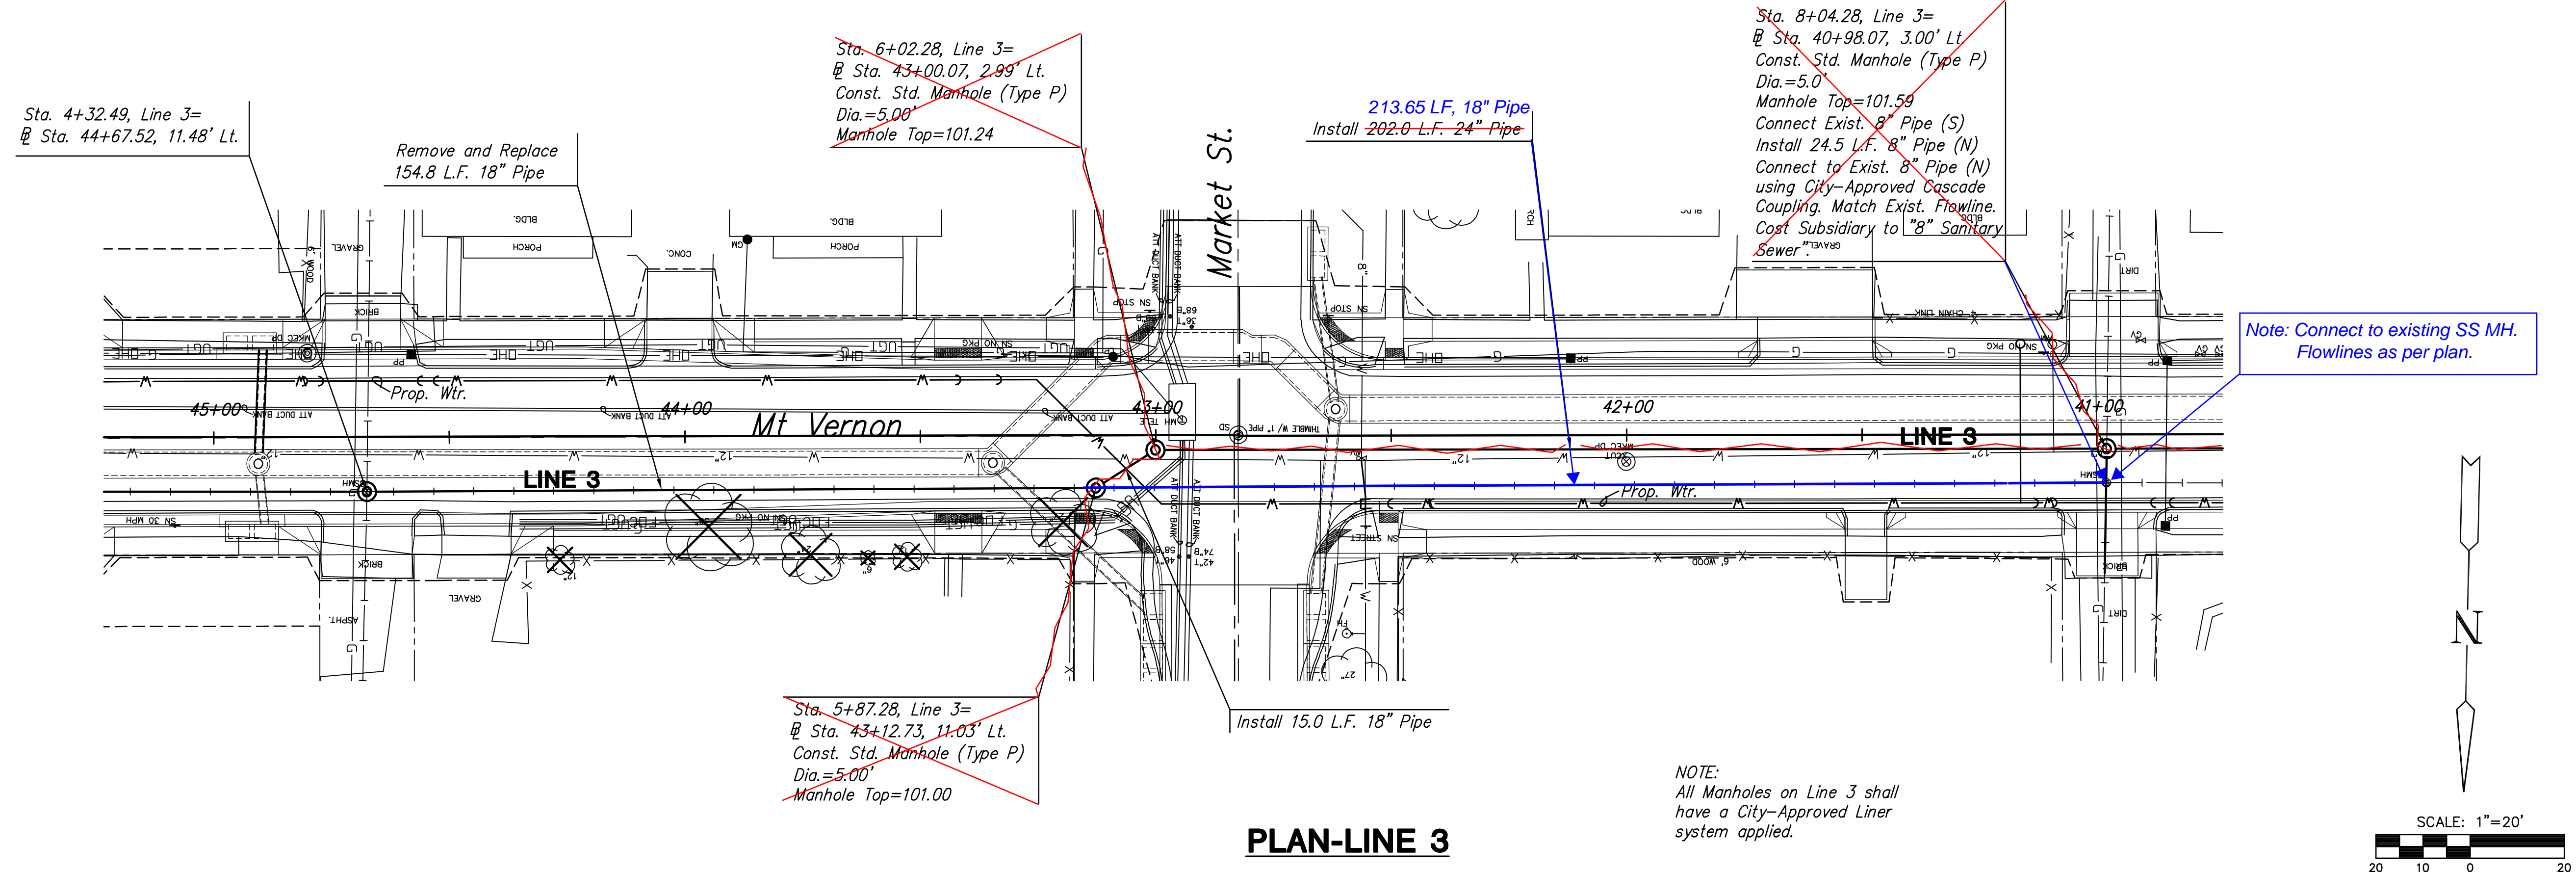

**PROFILE-LINE 3**

SCALE: HORIZ. 1"=20'  
SCALE: VERT. 1"=5'

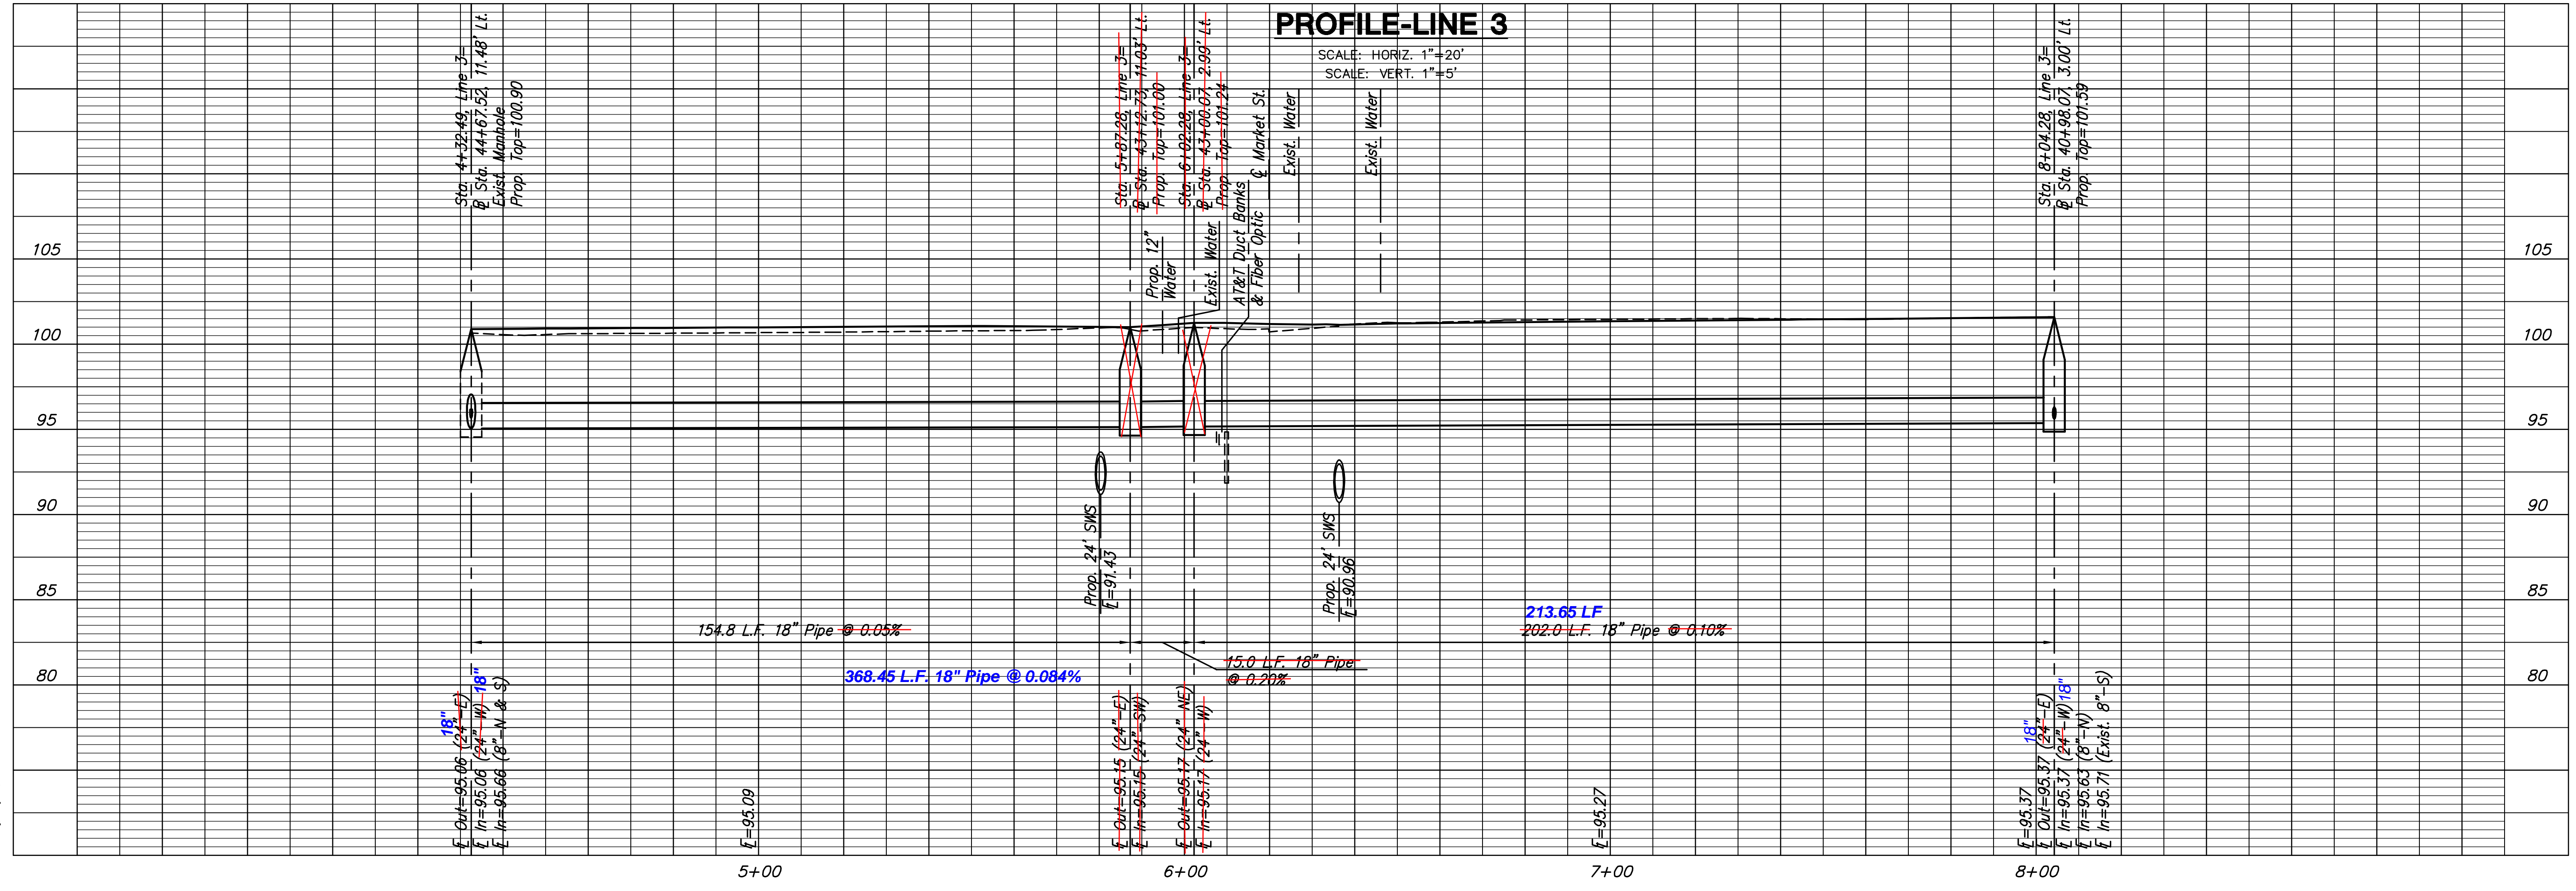

NOTE:  
All Manholes on Line 3 shall  
have a City-Approved Liner  
system applied.

Note: Connect to existing SS MH.  
Flowlines as per plan.

PLOTTED: Thursday, May 27, 2008 @ 04:37PM

J:\CIVIL\05620\DWG\PLAN\05620B04.DWG