

**MT VERNON STREET AND  
DRAINAGE IMPROVEMENTS  
FROM GREENWAY TO BROADWAY**


**Sanitary Sewer  
Line 3**  
SHEET TITLE 472-84289  
448-90385  
468-84514  
PROJECT NUMBER

DESIGN BY JRA  
DRAWN BY JSB  
CHECKED BY JRA


ISSUED  
May 27, 2008  
REVISED

SHEET NO.  
75 of 120

**NOTE:**  
The ground water influent line is a black-colored 8" SDR-11 HDPE pipe with green stripes associated with the City's Gilbert and Mosley project. This pipe contains ground water that is potentially contaminated and contact with the water should be avoided. The elevation of the pipe is based off of available record information and should be confirmed by the contractor at the beginning of construction. Relocation of the pipe around proposed utilities may be required. The contractor shall coordinate work with and around the pipe with the City of Wichita. Contact Doris Leslie with City of Wichita Environmental Services at 268-8359.

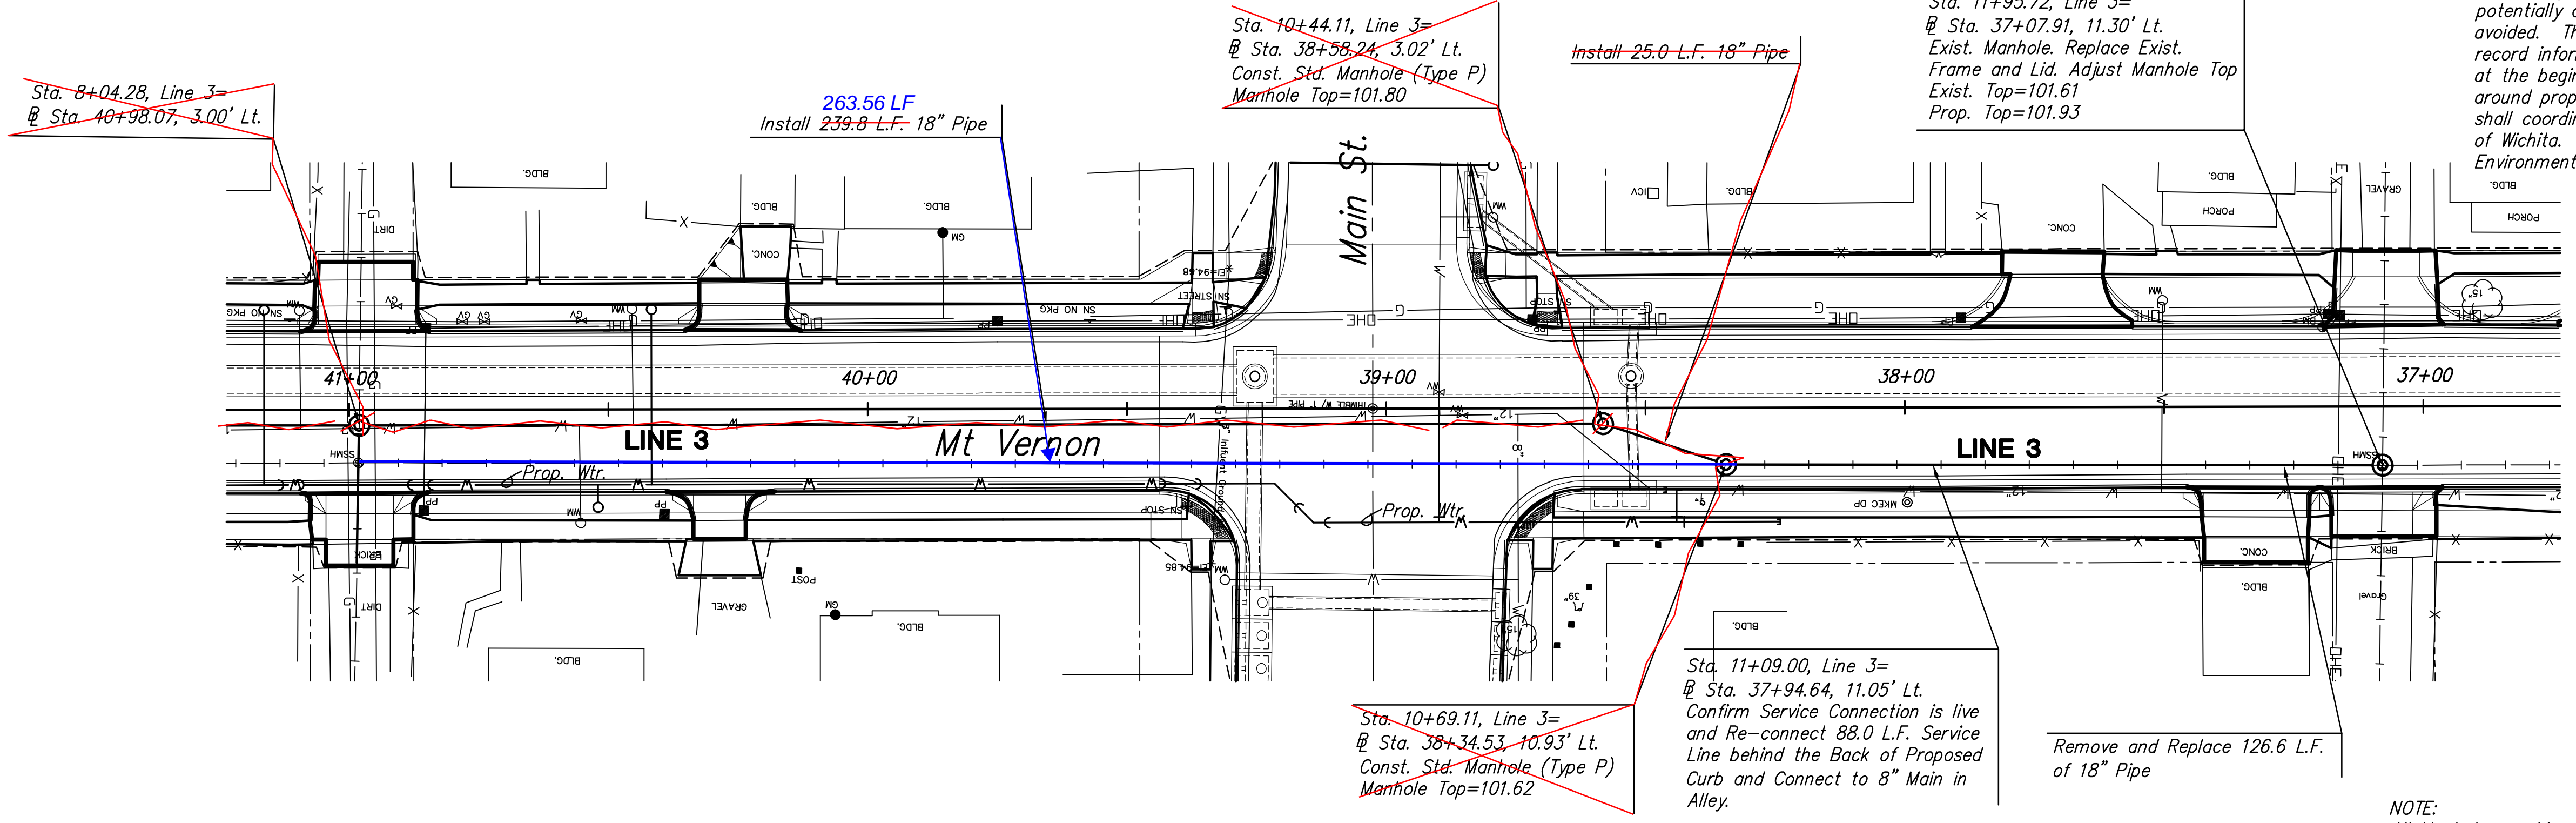

**PLAN-LINE 3**

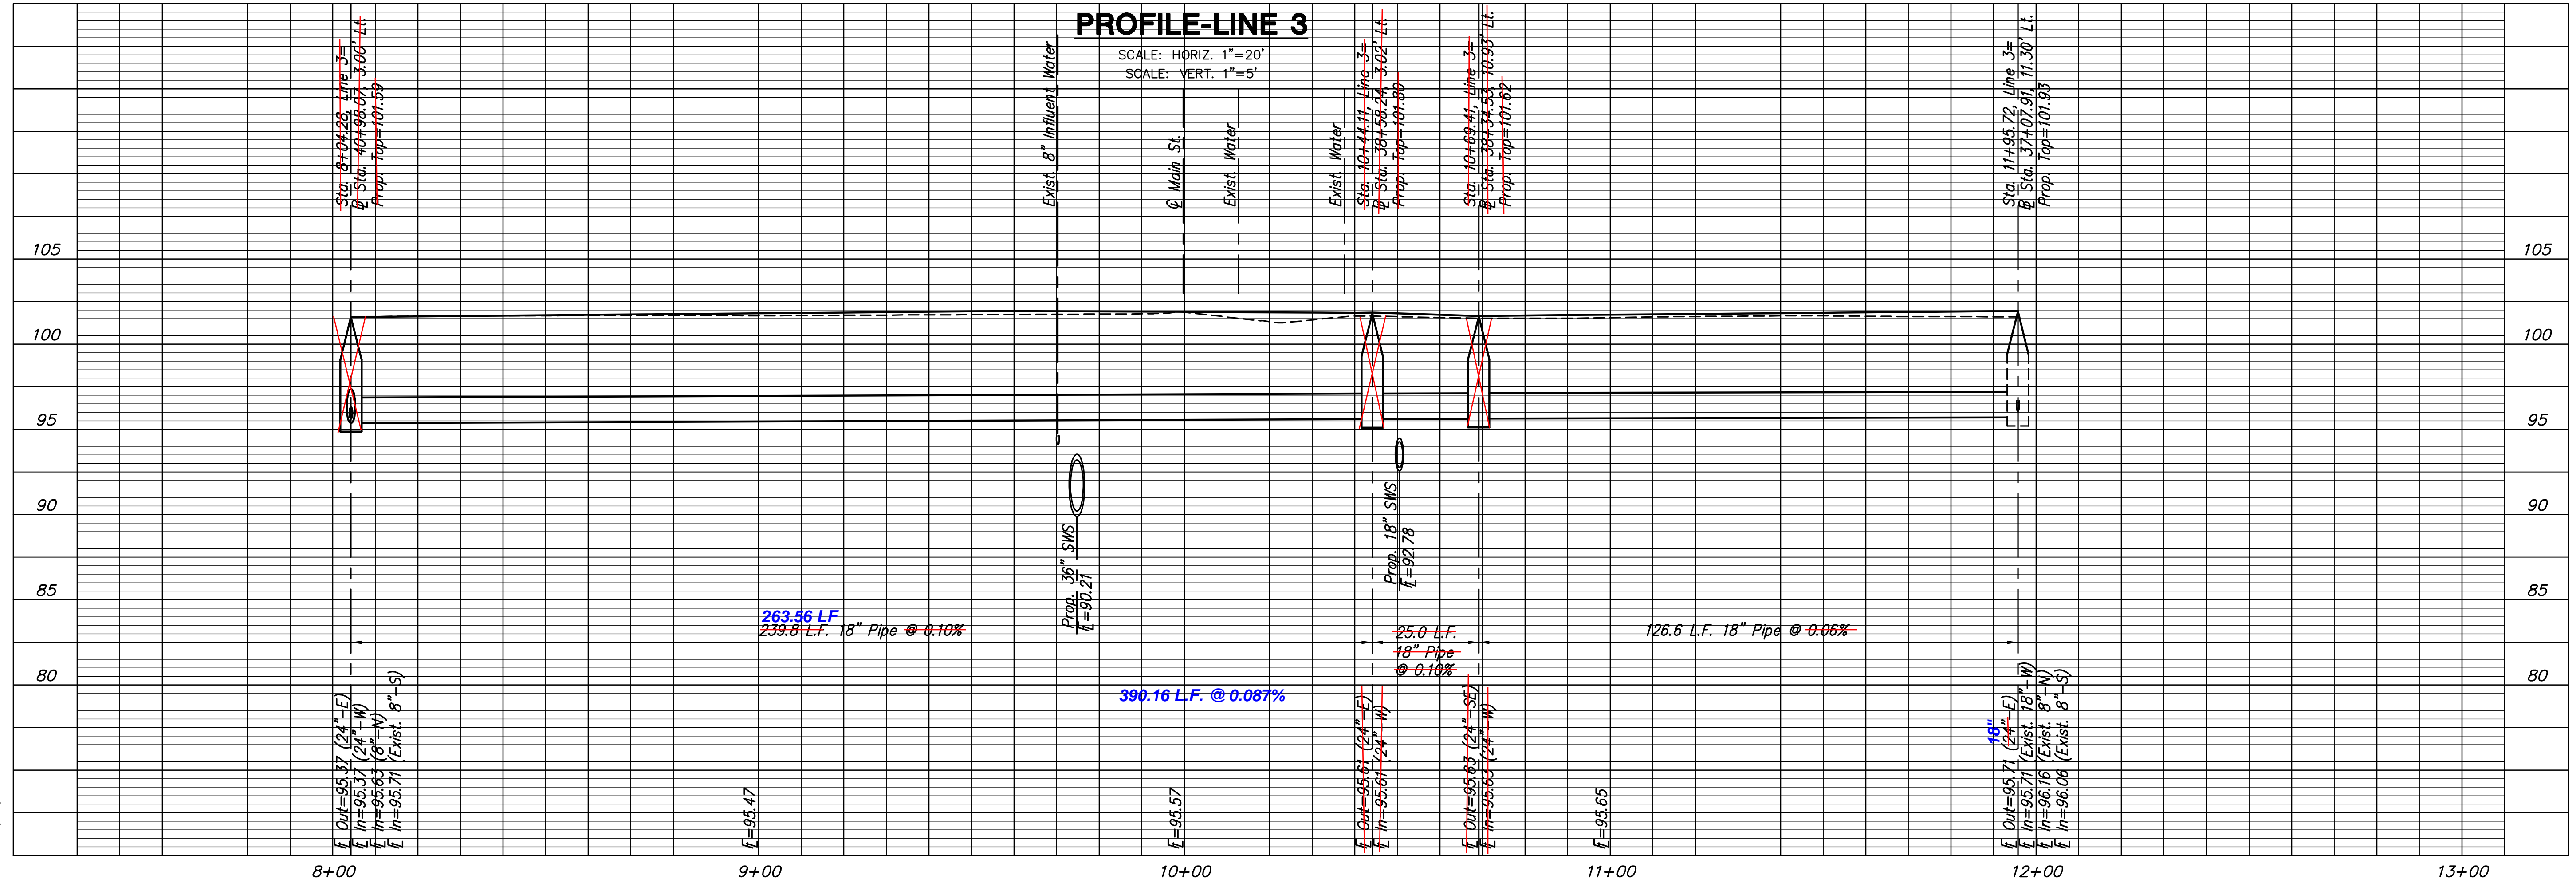

**PROFILE-LINE 3**

PLOTTED: Thursday, May 27, 2008 @ 04:37PM

J:\CIVIL\05620\DWG\SSAN\05620D05.DWG