

**MT VERNON STREET AND
DRAINAGE IMPROVEMENTS
FROM GREENWAY TO BROADWAY**


**Water Main 4
& Main 5**
SHEET TITLE 472-84289
448-90385
468-84514
PROJECT NUMBER

DESIGN BY JRA
DRAWN BY JSB
CHECKED BY JRA


ISSUED July 22, 2008
REVISED
1 July 22, 2008

SHEET NO.
65A of 120


Note:
Contractor to verify location
and elevation of Existing 6"
Water Line & 8" Water Line
prior to construction.

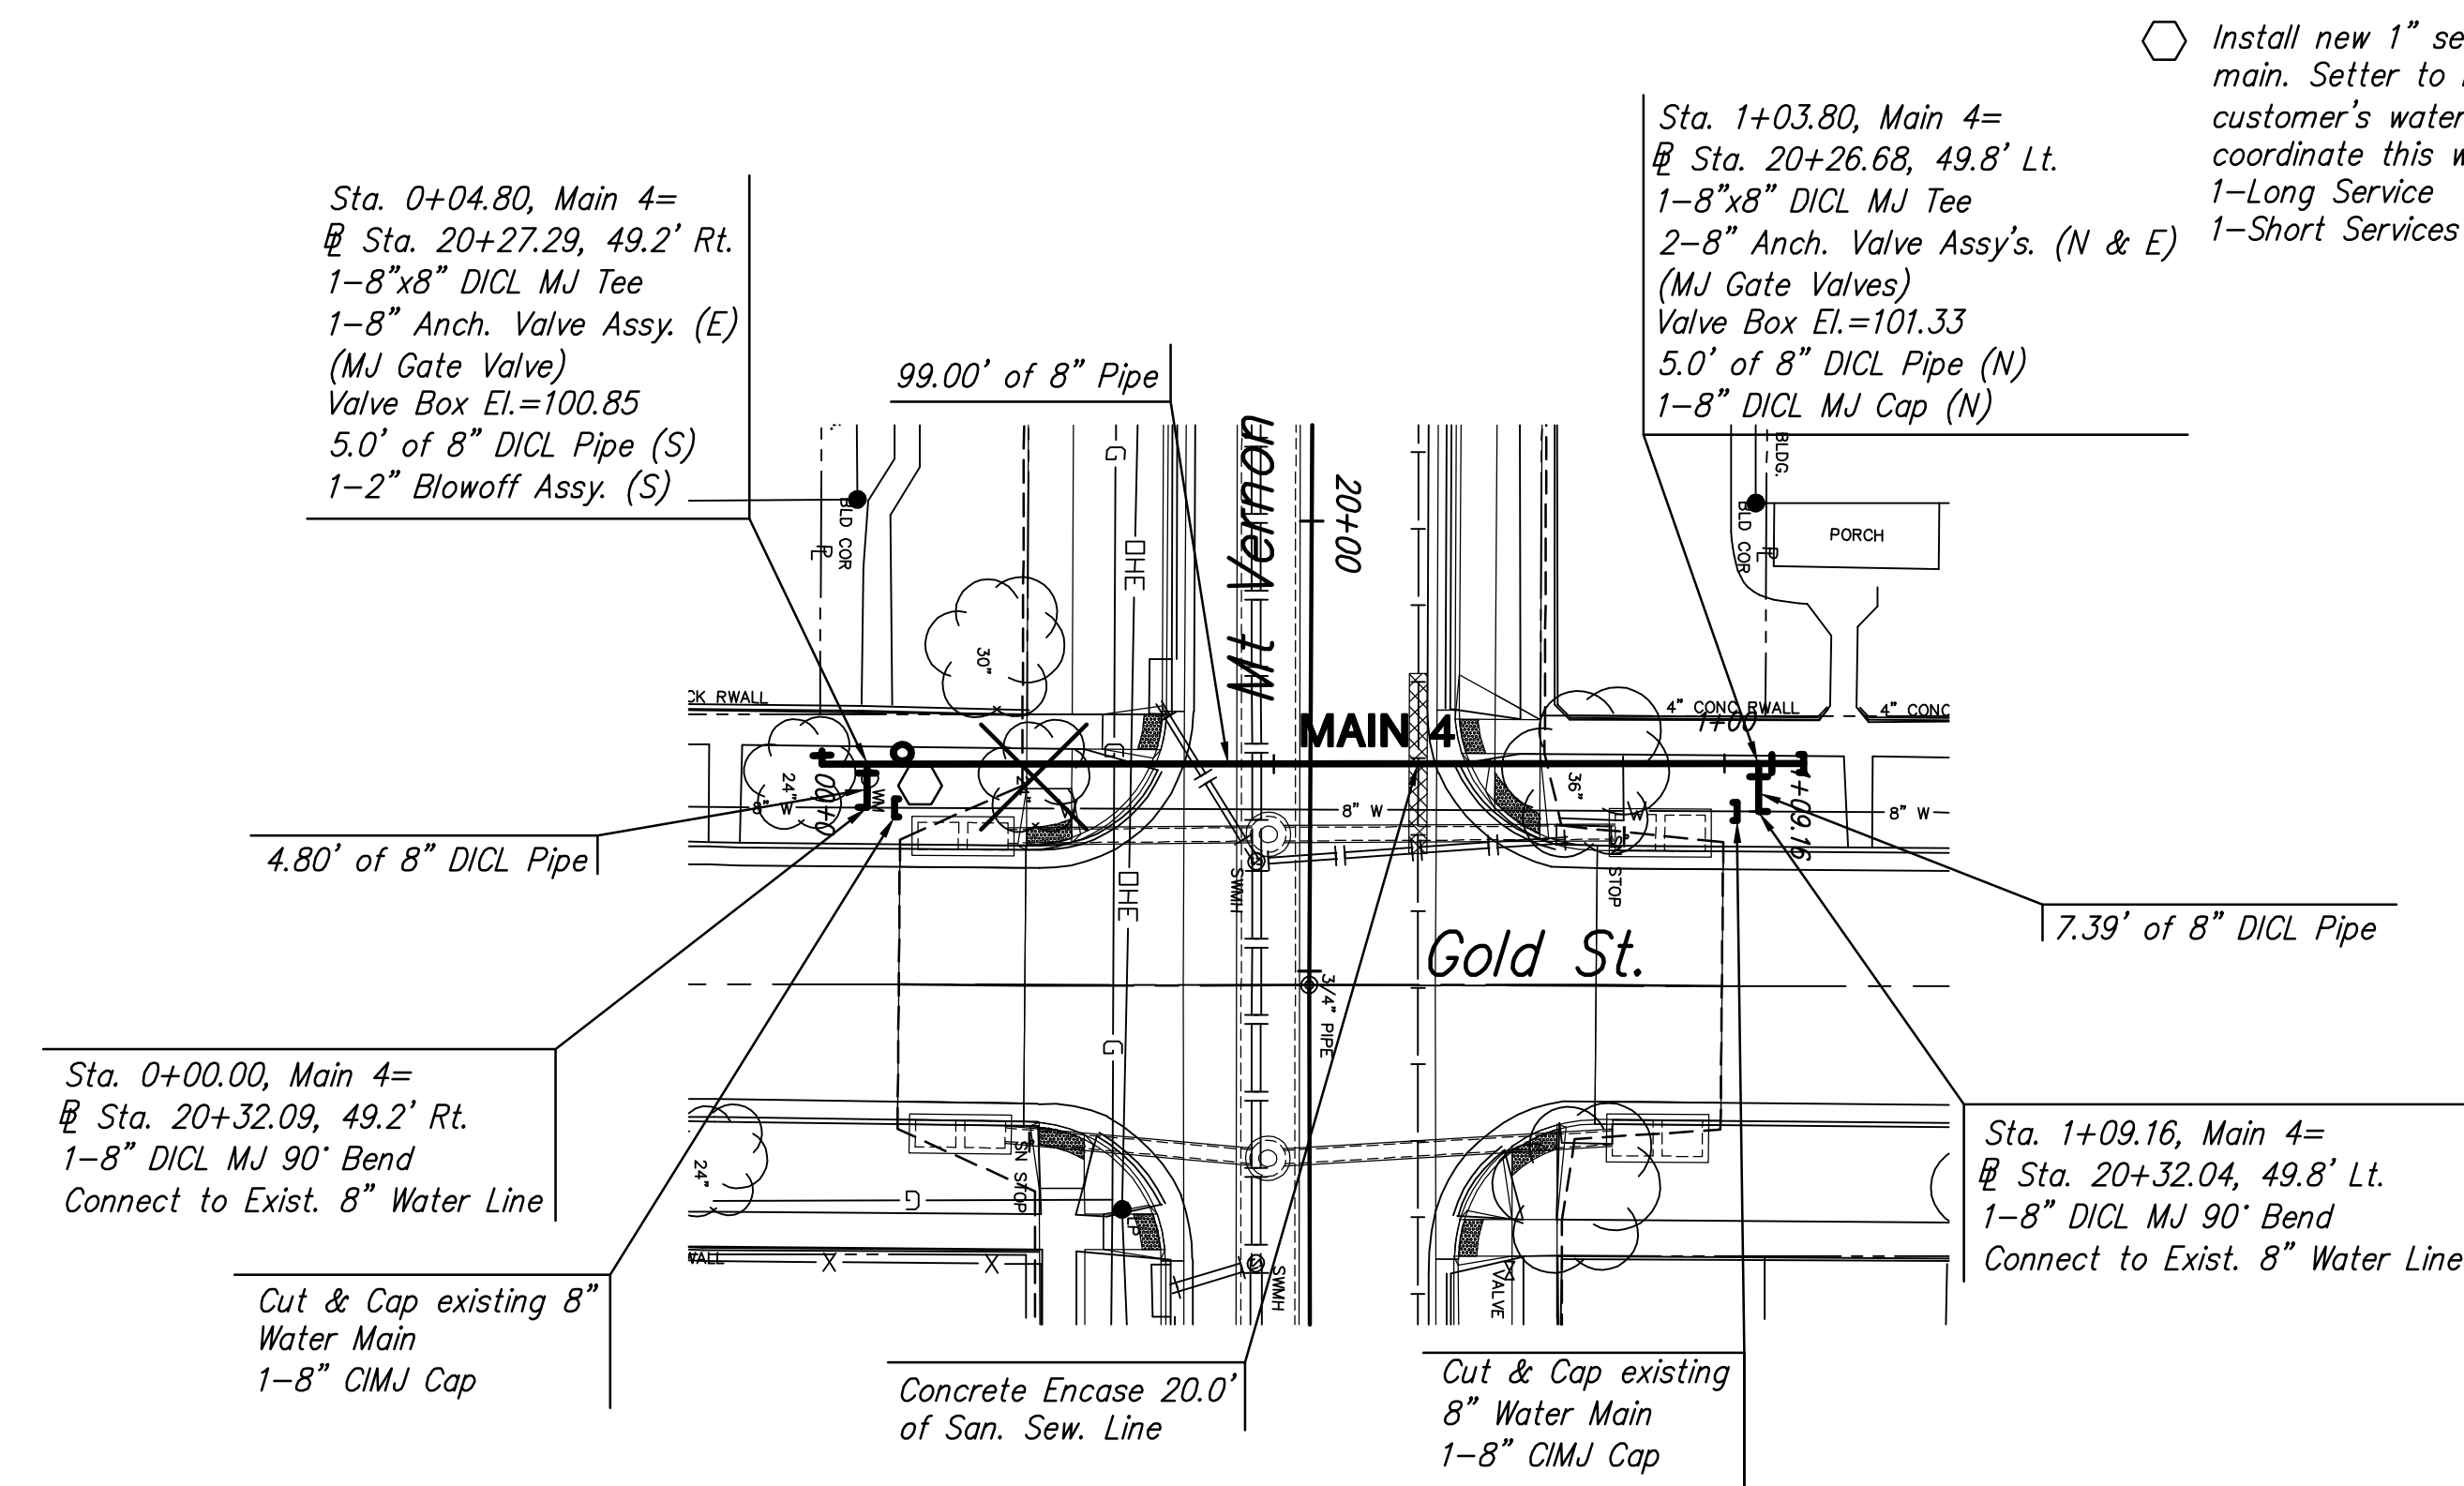

PLAN-MAIN 4

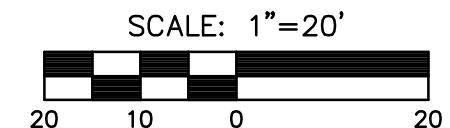

Revised Entire Sheet

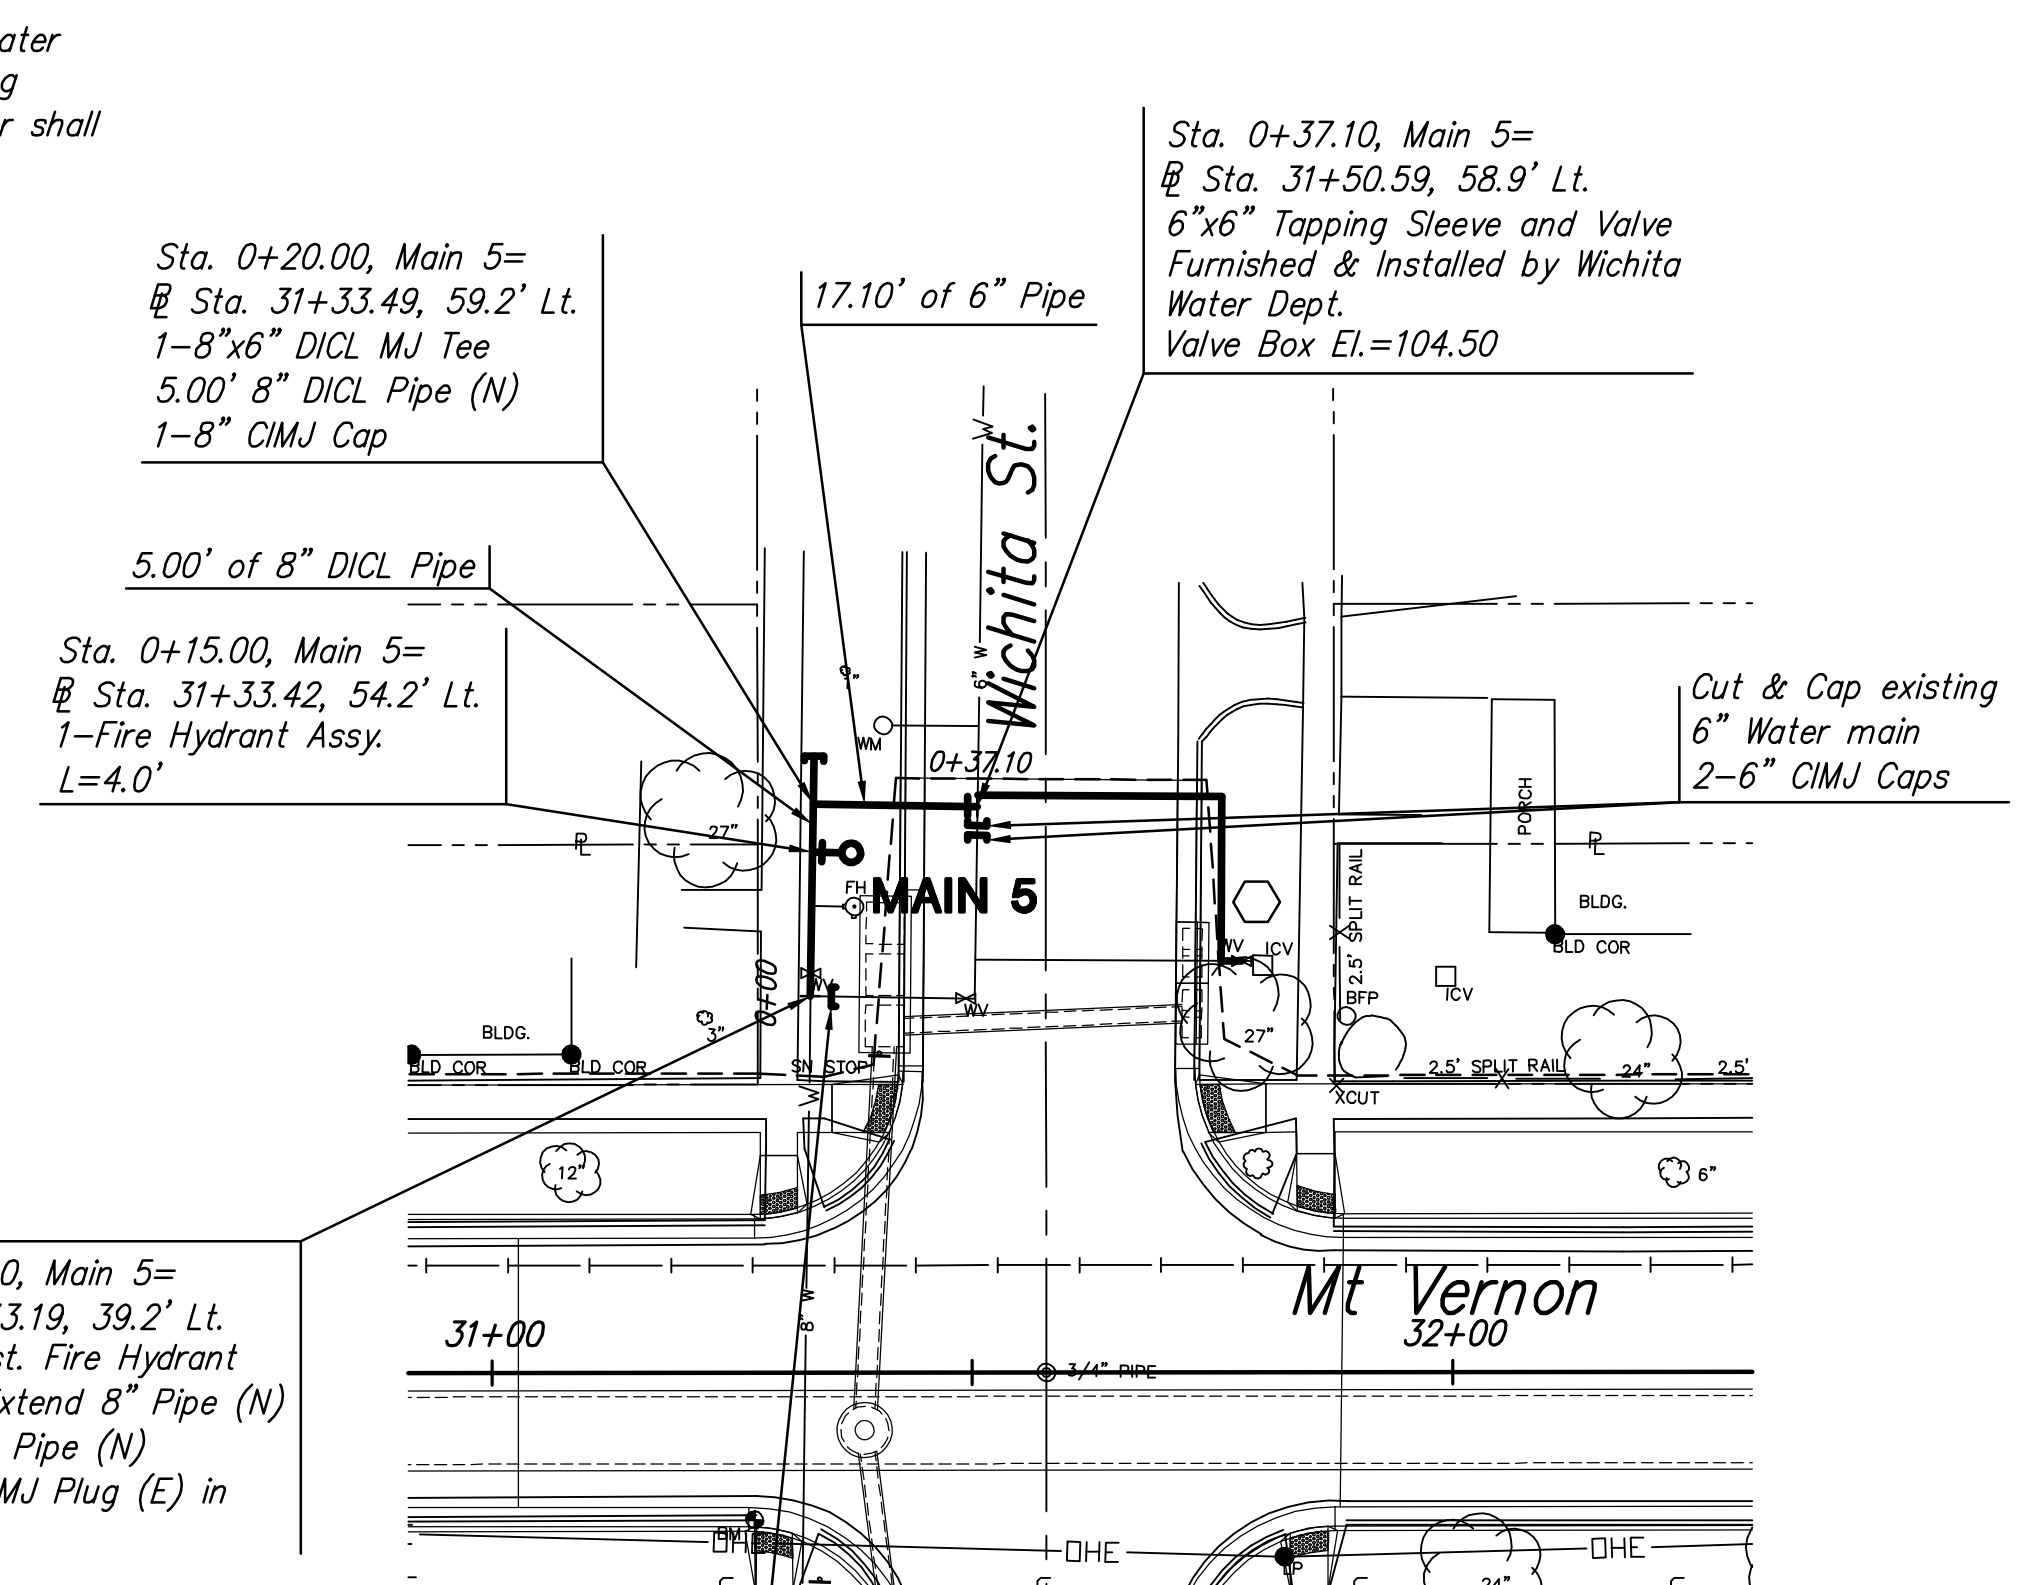


PLAN-MAIN 5



Note:
Contractor to verify location
and elevation of Existing 8"
Water Line prior to
construction.

PROFILE-MAIN 4

SCALE: HORIZ. 1"=20'
SCALE: VERT. 1"=5'

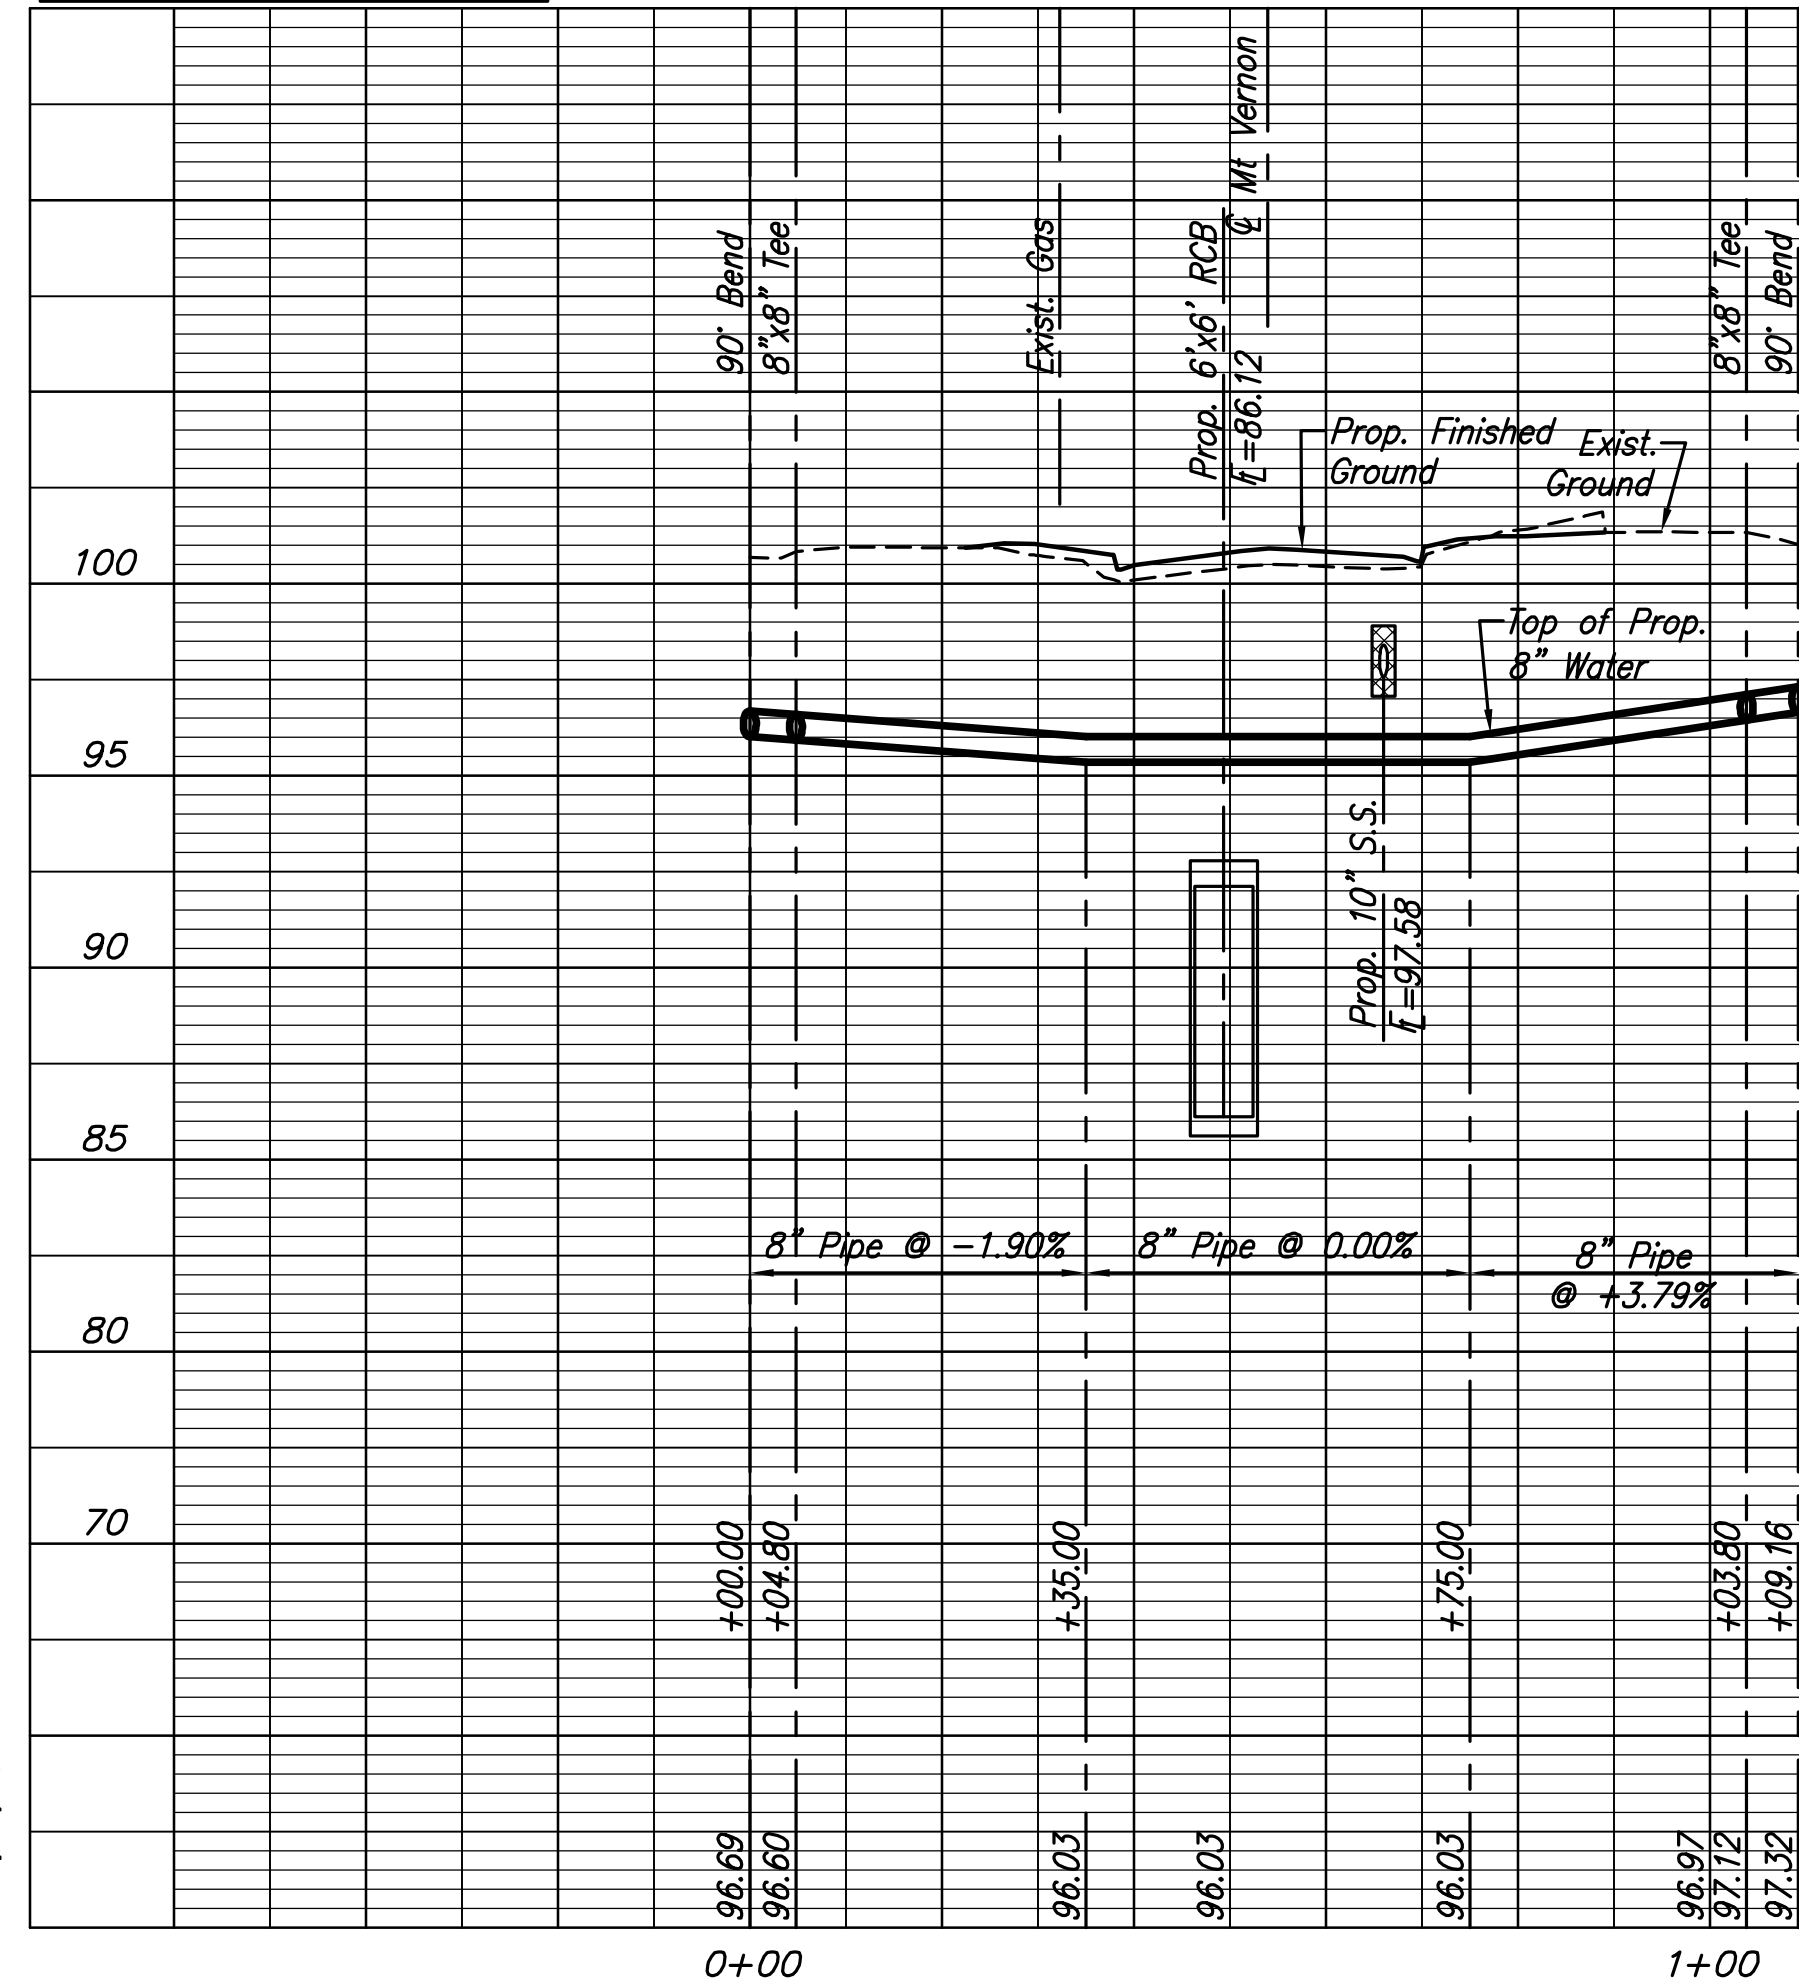

PROFILE-MAIN 5

SCALE: HORIZ. 1"=20'
SCALE: VERT. 1"=5'

