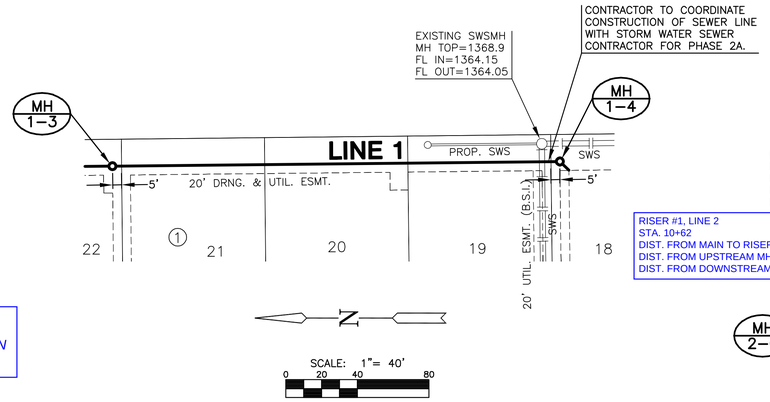

NOTE: SURVEY CREW CHANGED THE GRADE ON LINE 2 BETWEEN MH 10+00 TO MH 12+10.1

NOTE:
CONTRACTOR TO VERIFY THE DEPTH AND LOCATION OF EXISTING UTILITIES PRIOR TO CONSTRUCTION.

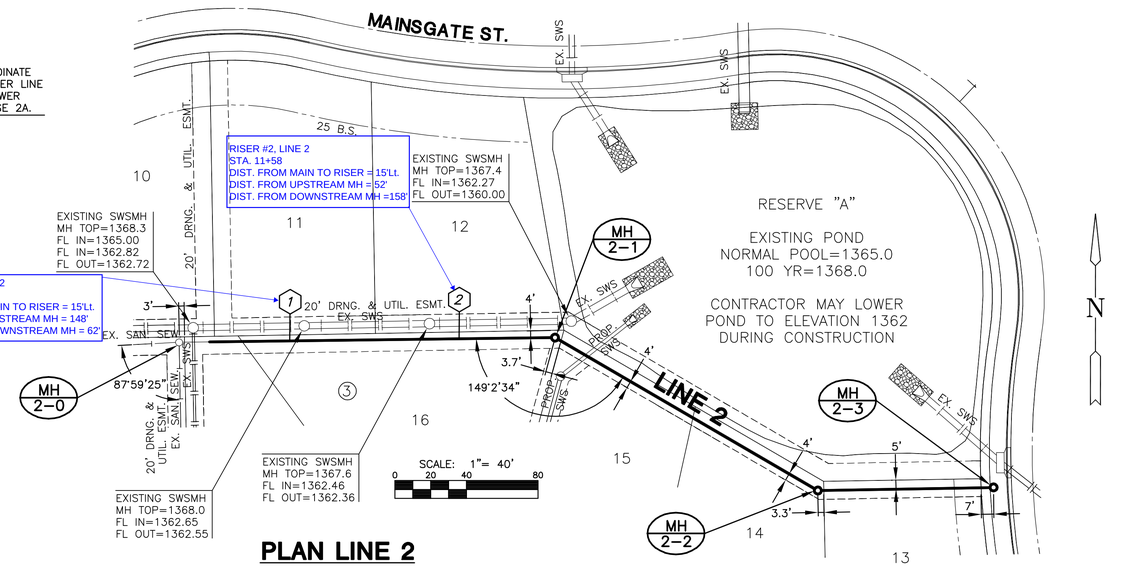

PLAN LINE 1 CONT.

PLAN LINE 2

PROFILE LINE 1 CONT.

SCALE: HORIZ. 1"=40'
SCALE: VERT. 1"=5'

PROFILE LINE 2

SCALE: HORIZ. 1"=40'
SCALE: VERT. 1"=5'

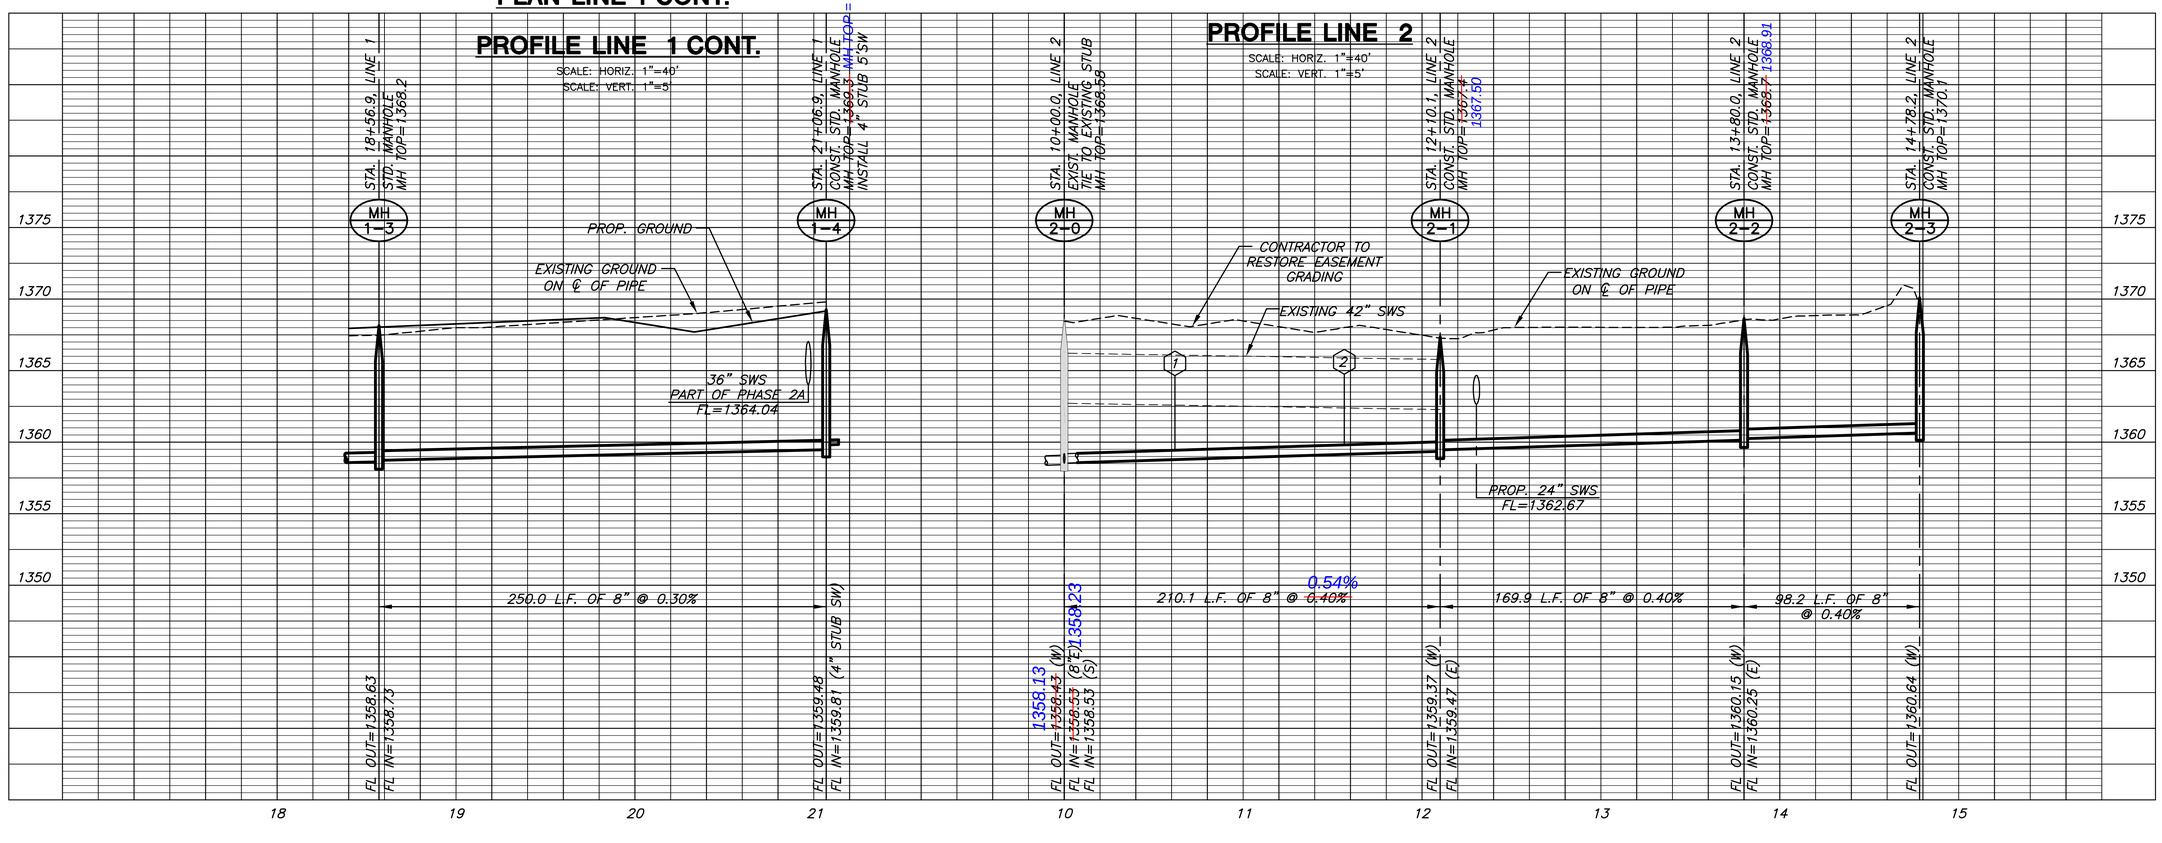

PLOTTED: Tuesday, August 18, 2009 @ 02:39PM

MKEC ENGINEERING CONSULTANTS, INC.
411 N. WEBB ROAD
WICHITA, KS. 67206
316 - 684 - 9600

MONARCH LANDING SECOND ADD.

SANITARY SEWER PLANS FOR PHASE 2 PART B

LINES 1 & 2
SHEET TITLE

468-84433
PROJECT NUMBER

DFL
DESIGN BY

JWC
DRAWN BY

GJA
CHECKED BY

ISSUED
August 2009

REVISED

SHEET NO.
5 of 12

J:\CIVIL\06201\07165\SAN\PHASE2\PHASE2B\07165_B2.DWG