

SEWER SERVICE TABLE

NUMBER	TYPE	LOCATION			STATION\ DIRECTION	FOR INFORMATION ONLY	
		LOT NO.	BLOCK NO.	LINE NO.		APPROXIMATE LENGTH 4" PIPE	VERTICAL
1	8" X 4" Tee Saddle	4	4	1	1+00/Rt.	10.0'	5.0'
2	8" X 4" Tee Saddle	3	4	1	1+80/Rt.	10.0'	5.0'
3	8" X 4" Tee Saddle	2	4	1	2+60/Rt.	10.0'	5.0'
4	8" X 4" Tee Saddle	1	4	1	3+40/Rt.	10.0'	5.0'

NOTE: Vertical Riser Pipe shall be extended to 2' minimum above ground water elevation and 4' maximum below proposed ground elevation.

REMOVE TREES AS NECESSARY FOR CONSTRUCTION. REMOVE & DO NOT REPLACE FENCE AS NECESSARY FOR CONSTRUCTION.

STA. -0+07.65, Sanitary Line 1
N 19983.60 E 17335.80
CONSTRUCT STD. TYPE 'P' MANHOLE OVER EXISTING 8" MAIN
D = 4.0'
TOP ELEV. **+1334.90** **+1335.02**

STA. 0+53.48, Sanitary Line 1
N 19953.98 E 17389.28
CONSTRUCT STD. TYPE 'P' MANHOLE
D = 4.0'
TOP ELEV. **+1335.40** **+1335.56**

Riser #2, Line 1
Sta. 1+80, Rt.
Distance from Main to Riser = 5' Rt.
Distance from Upstream MH = 232'
Distance from Downstream MH = 124'

Riser #4, Line 1
Sta. 3+40, Rt.
Distance from Main to Riser = 5' Rt.
Distance from Upstream MH = 72'
Distance from Downstream MH = 284'


STA. 6+00.00, Sanitary Line 1
N 19766.85 E 17745.74
CONSTRUCT STD. TYPE 'P' MANHOLE
D = 4.0'
TOP ELEV. **+1337.7** **+1337.76**

STA. 10+00.00, Sanitary Line 1
N 19366.85 E 17745.66
CONSTRUCT STD. TYPE 'P' MANHOLE
D = 4.0'
TOP ELEV. **+1334.80**

STA. 4+10.00, Sanitary Line 1
N 19956.85 E 17745.79
CONSTRUCT STD. TYPE 'P' MANHOLE
D = 4.0'
TOP ELEV. **+1336.00** **+1336.02**

Riser #1, Line 1
Sta. 1+00, Rt.
Distance from Main to Riser = 5' Rt.
Distance from Upstream MH = 309'
Distance from Downstream MH = 47'

Riser #3, Line 1
Sta. 2+60, Rt.
Distance from Main to Riser = 5' Rt.
Distance from Upstream MH = 150'
Distance from Downstream MH = 206'

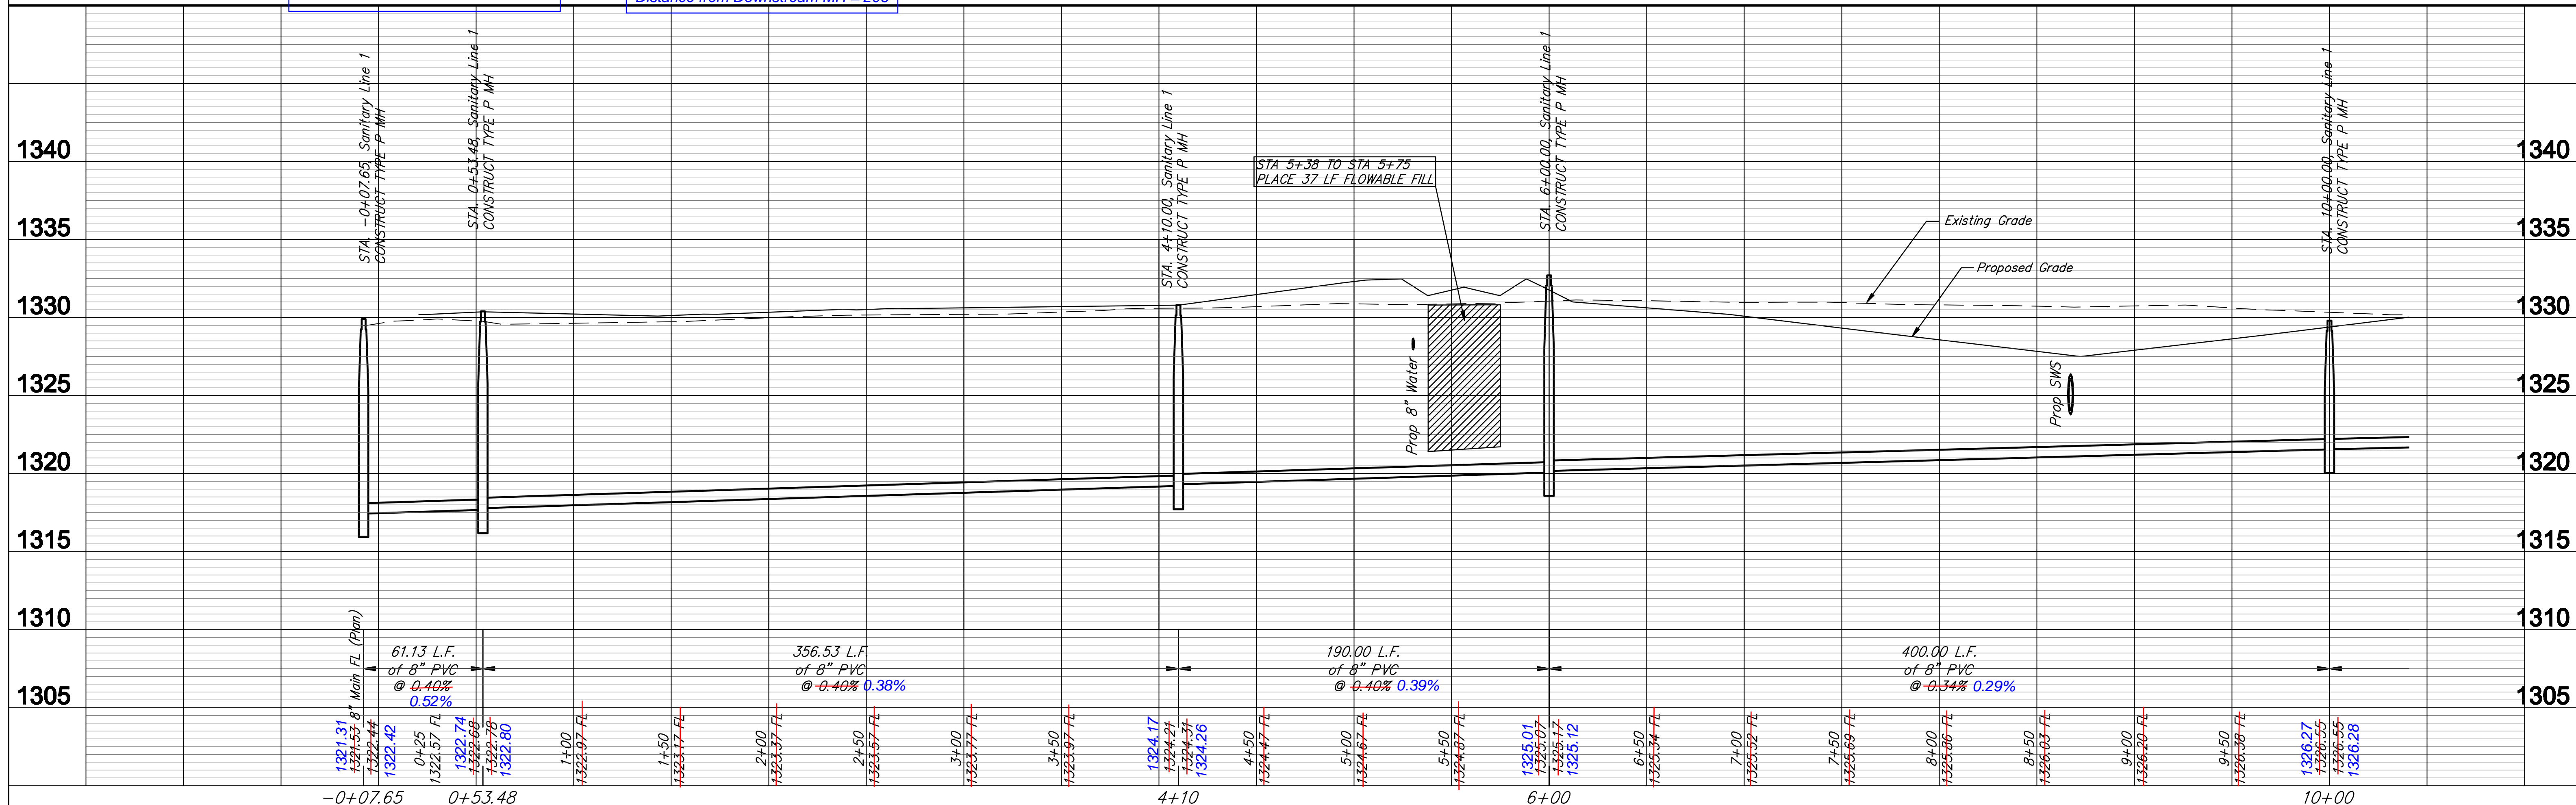


PROJECT NUMBER: 468-84516
 DATE: June 1, 2008
 SHEET: SS ISS Line 1

Sanitary Sewer Line 1
WICHITA, KANSAS

3268E
 2
 11