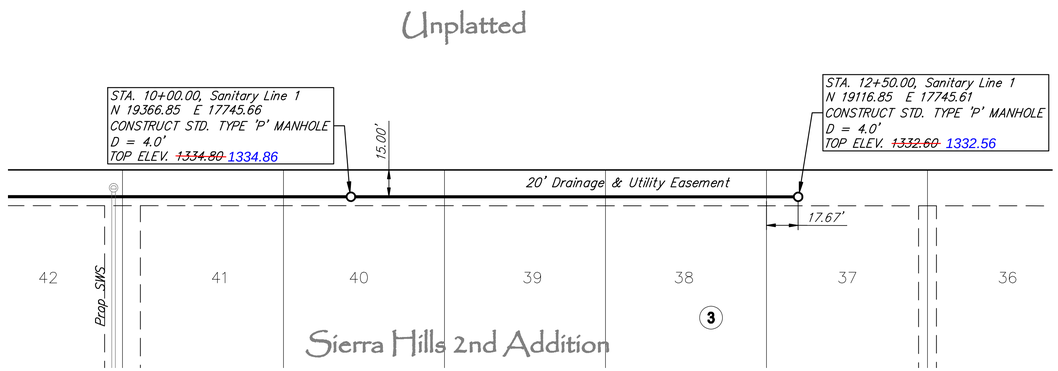

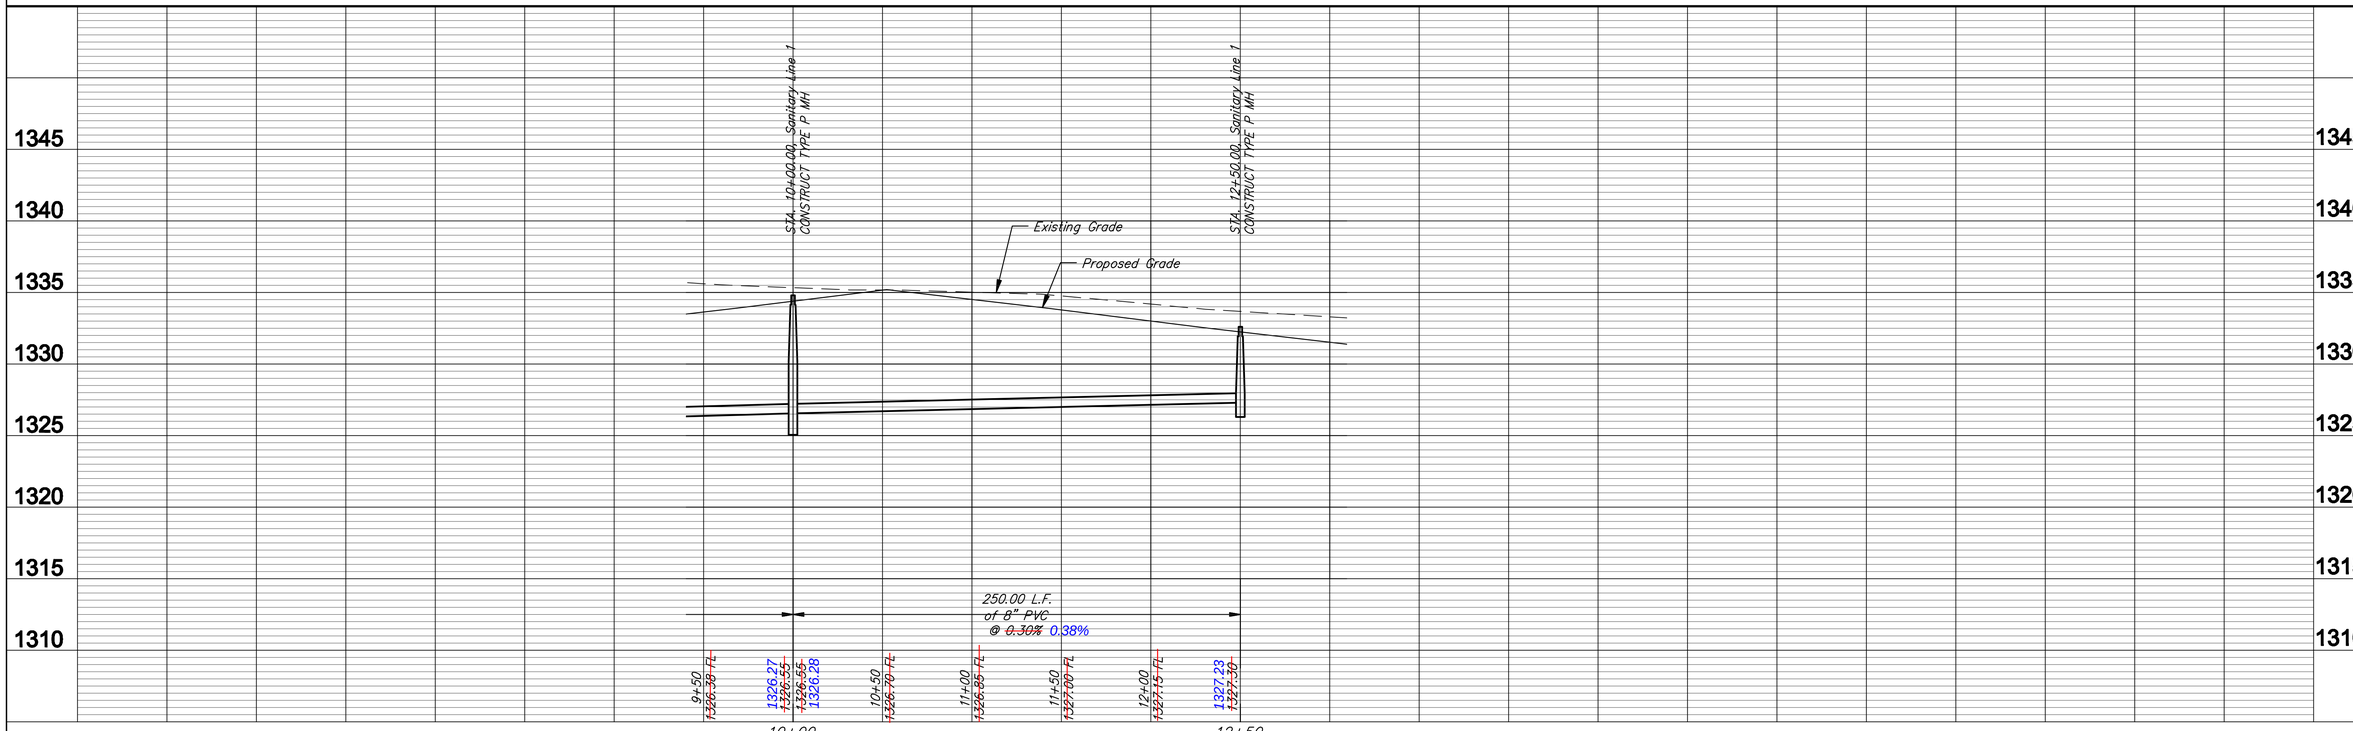

Ruegsegger & Bartlett, P.A.
Engineering Surveying Land Planning
8500 W. 13th
Wichita, Kansas 67212
Phone: (316) 722-1111
Fax: (316) 722-1112
www.rbpa.com

DRAWN EJG
DATE June 1, 2009
VERIFY EJG
DATE April 30, 2009

PROJECT NUMBER 468-86516
DRAWING FILE SS (SS Line 1)

Sanitary Sewer Line 1
WICHITA, KANSAS

3268E

3
11