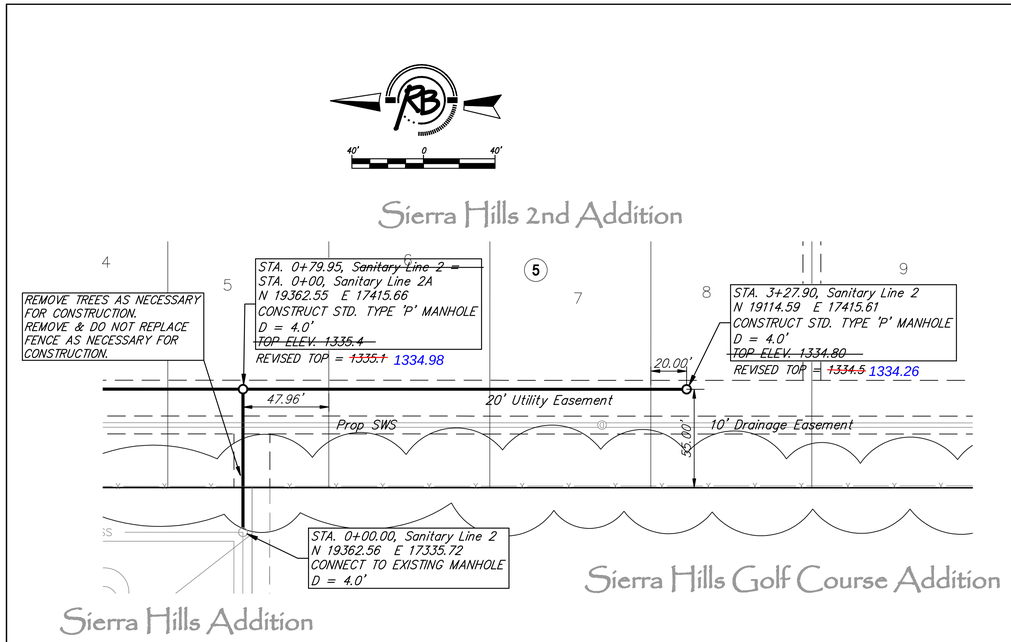

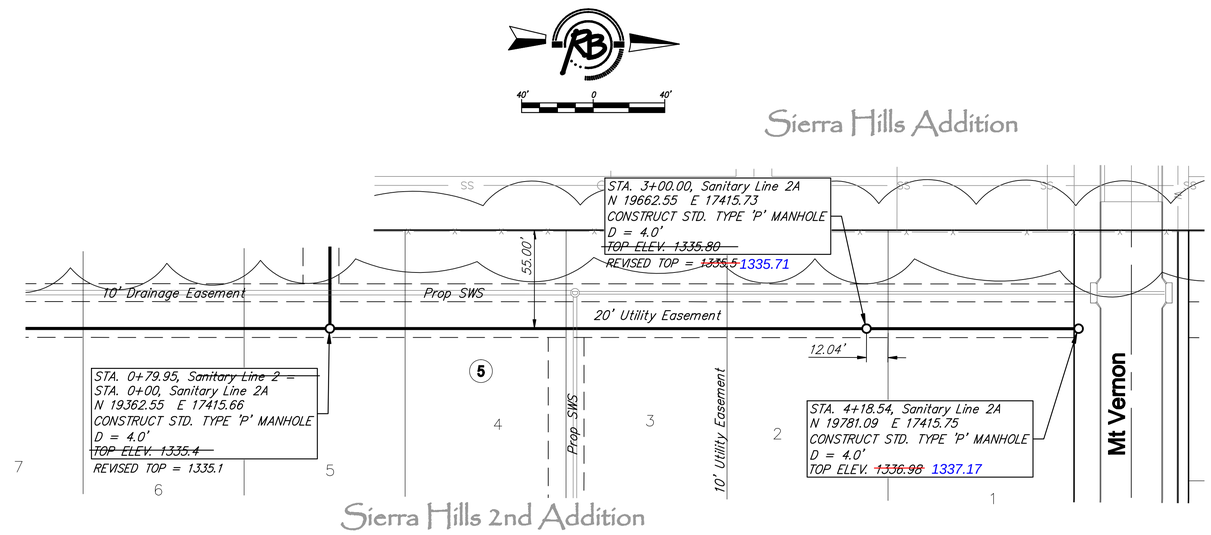

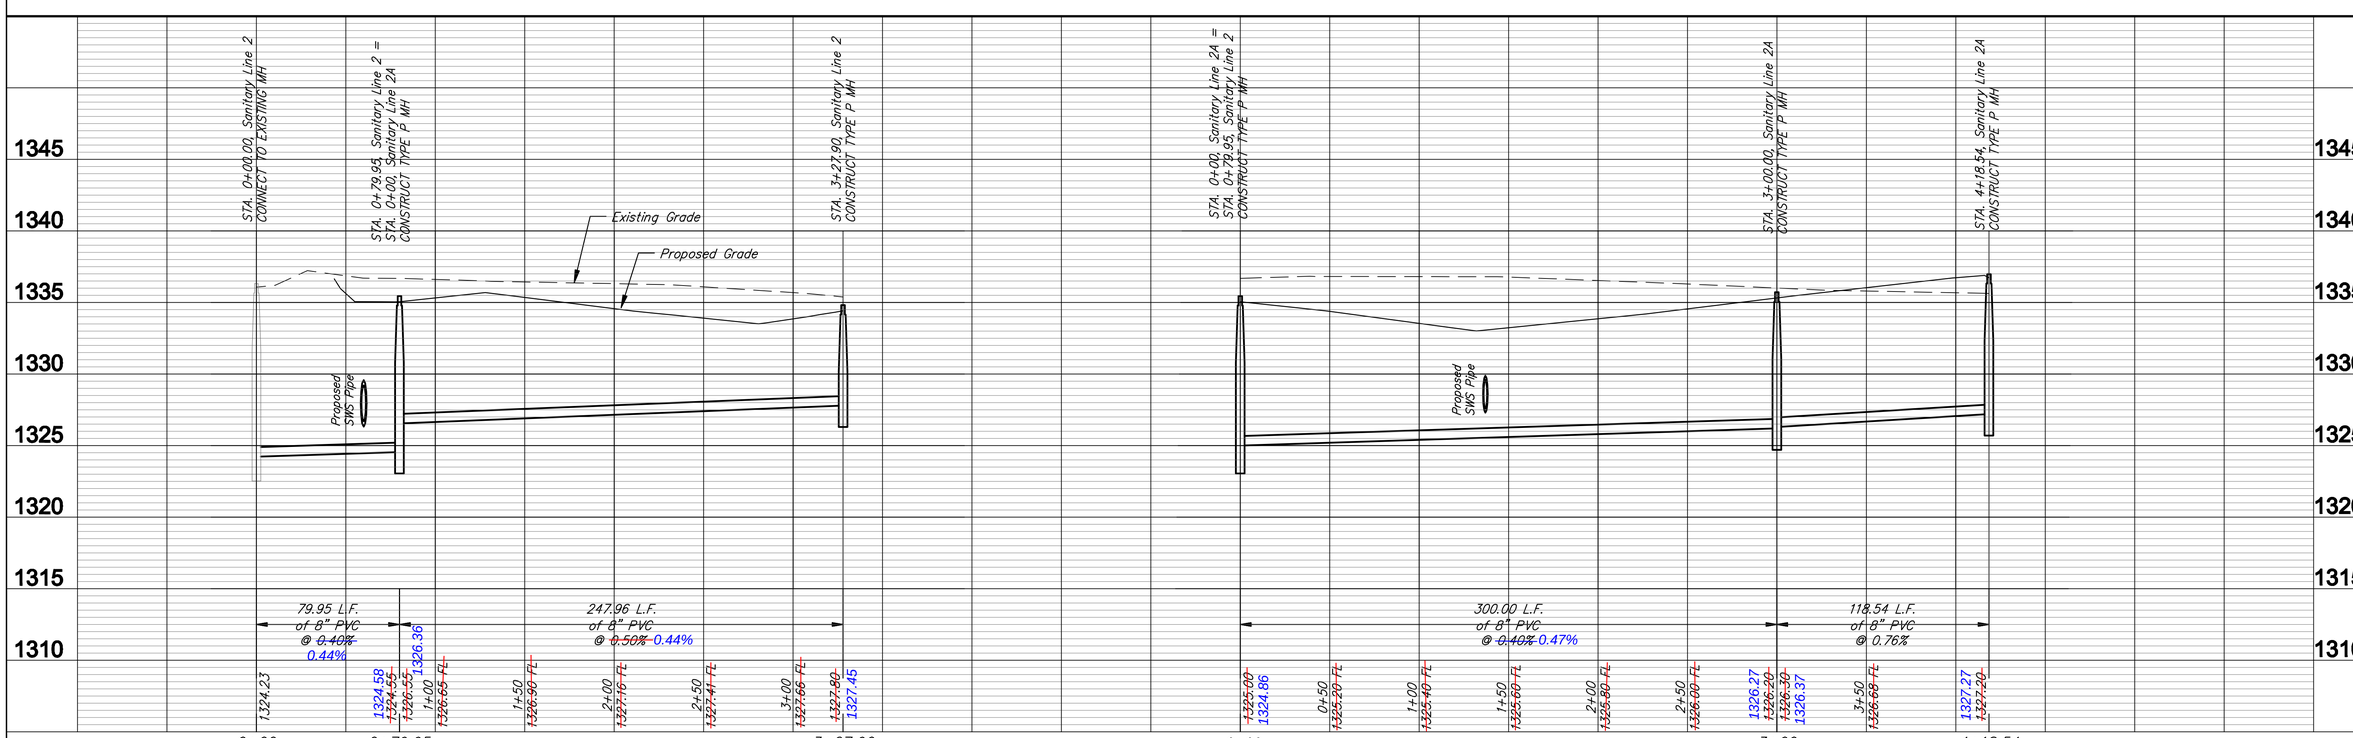

Rueszler & Backus, P.A.
Engineering Surveying Land Planning
Wichita, Ks.
Phone 316-
Fax 316-
www.rbpa.com

DESIGNED EJG
DRAWN EJG
CHECKED
DATE July 8, 2009
SCALE
DATE June 1, 2009 April 30, 2008

PROJECT NUMBER 468-86516
DRAWING FILE SS (SS Line 2)

Sanitary Sewer Line 2
WICHITA, KANSAS

3268E

4 of 11