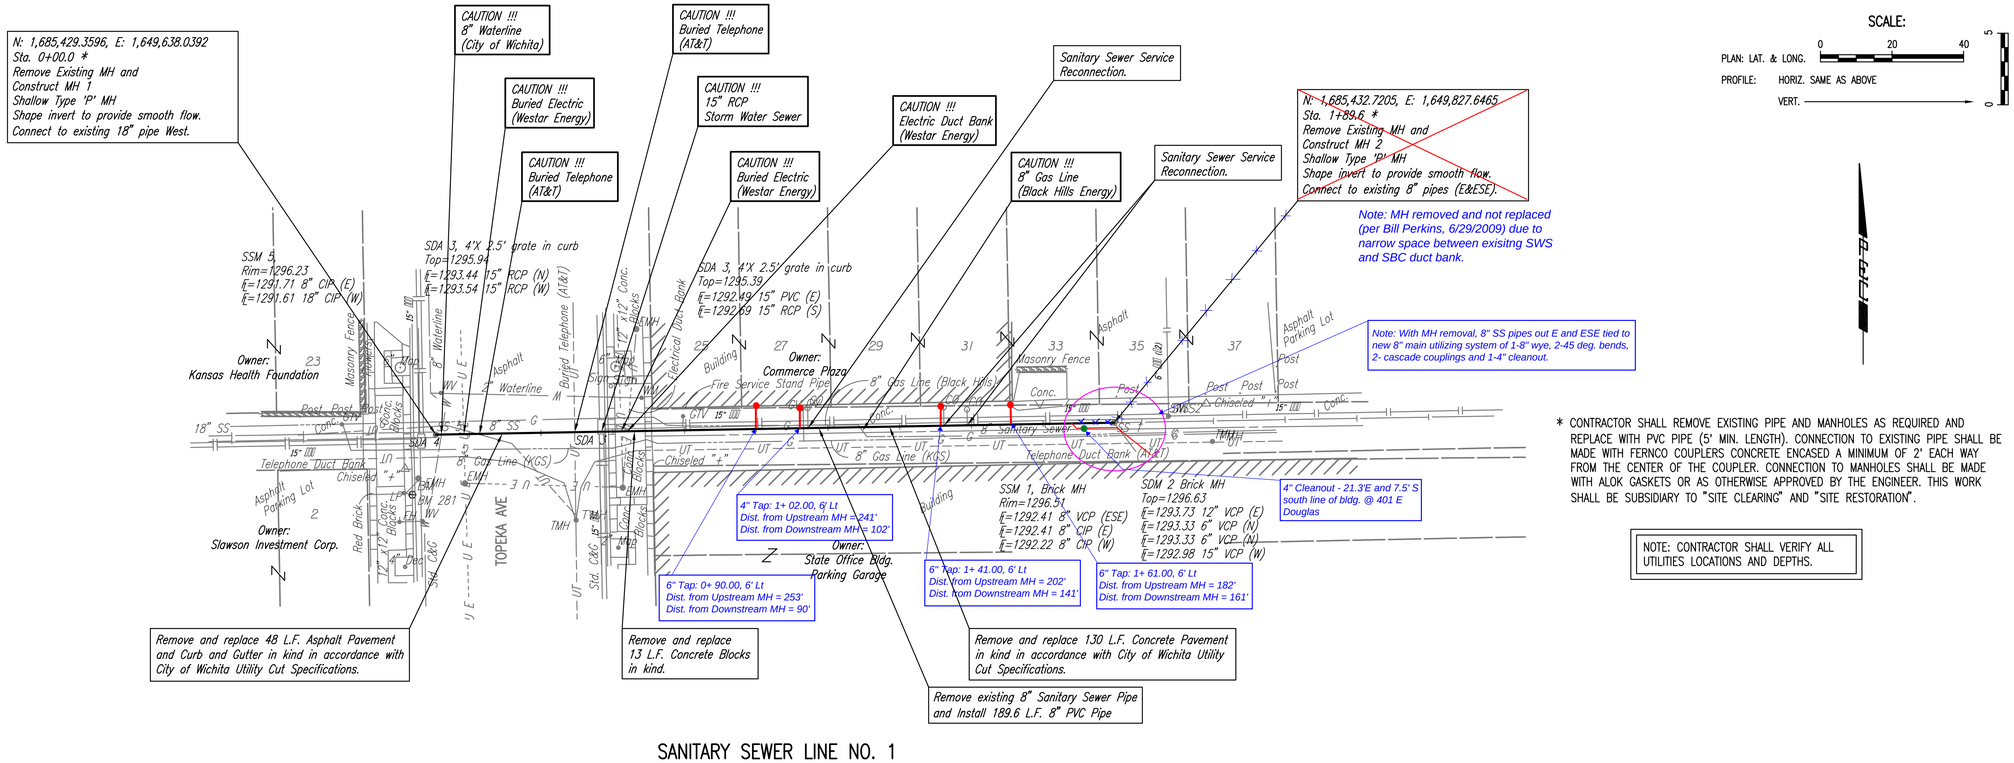

SANITARY SEWER LINE NO. 1

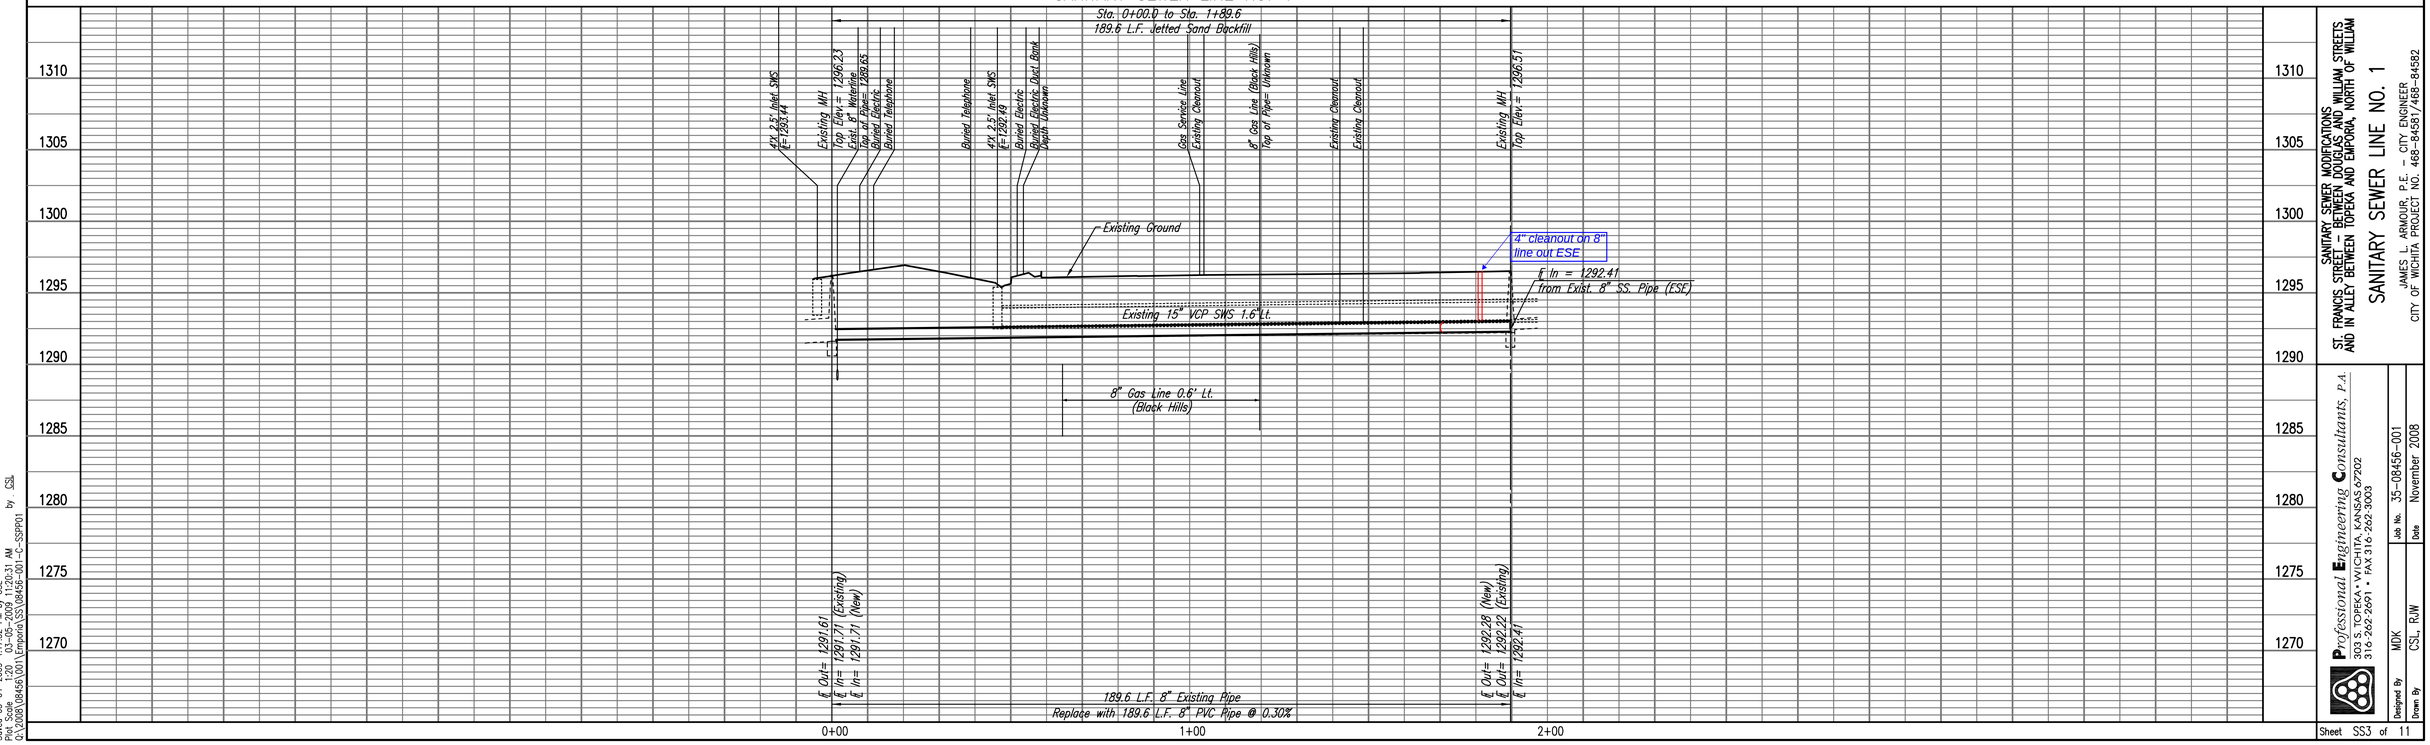

SANITARY SEWER MODIFICATIONS
ST. FRANCIS STREET – BETWEEN DOUGLAS AND WILLIAM STREETS
AND IN ALLEY BETWEEN TOPEKA AND EMPORIA, NORTH OF WILLIAM

SANITARY SEWER LINE NO. 1

JAMES L. ARMOUR, P.E. – CITY ENGINEER
CITY OF WICHITA PROJECT NO. 468-84581/468-84582

Professional Engineering Consultants, P.A.
303 S. TOPEKA • WICHITA, KANSAS 67202
316-262-2691 • FAX 316-262-3003

Designed By	MDK
Drawn By	CSL, RJW
Job No.	35-08456-001
Date	November 2008

Sheet SS3 of 11

PLAN — CHECKED — CHECKED — BY — DATE

PROFILE — CHECKED — CHECKED

Saved 03-04-2009 4:17:32 PM by CSL
Plotted Date: 03-05-2009 11:20:31 AM by CSL
Q:\2008\08456\001\Emporia\SS\08456-001-C-SSPP01