



DATE	BY

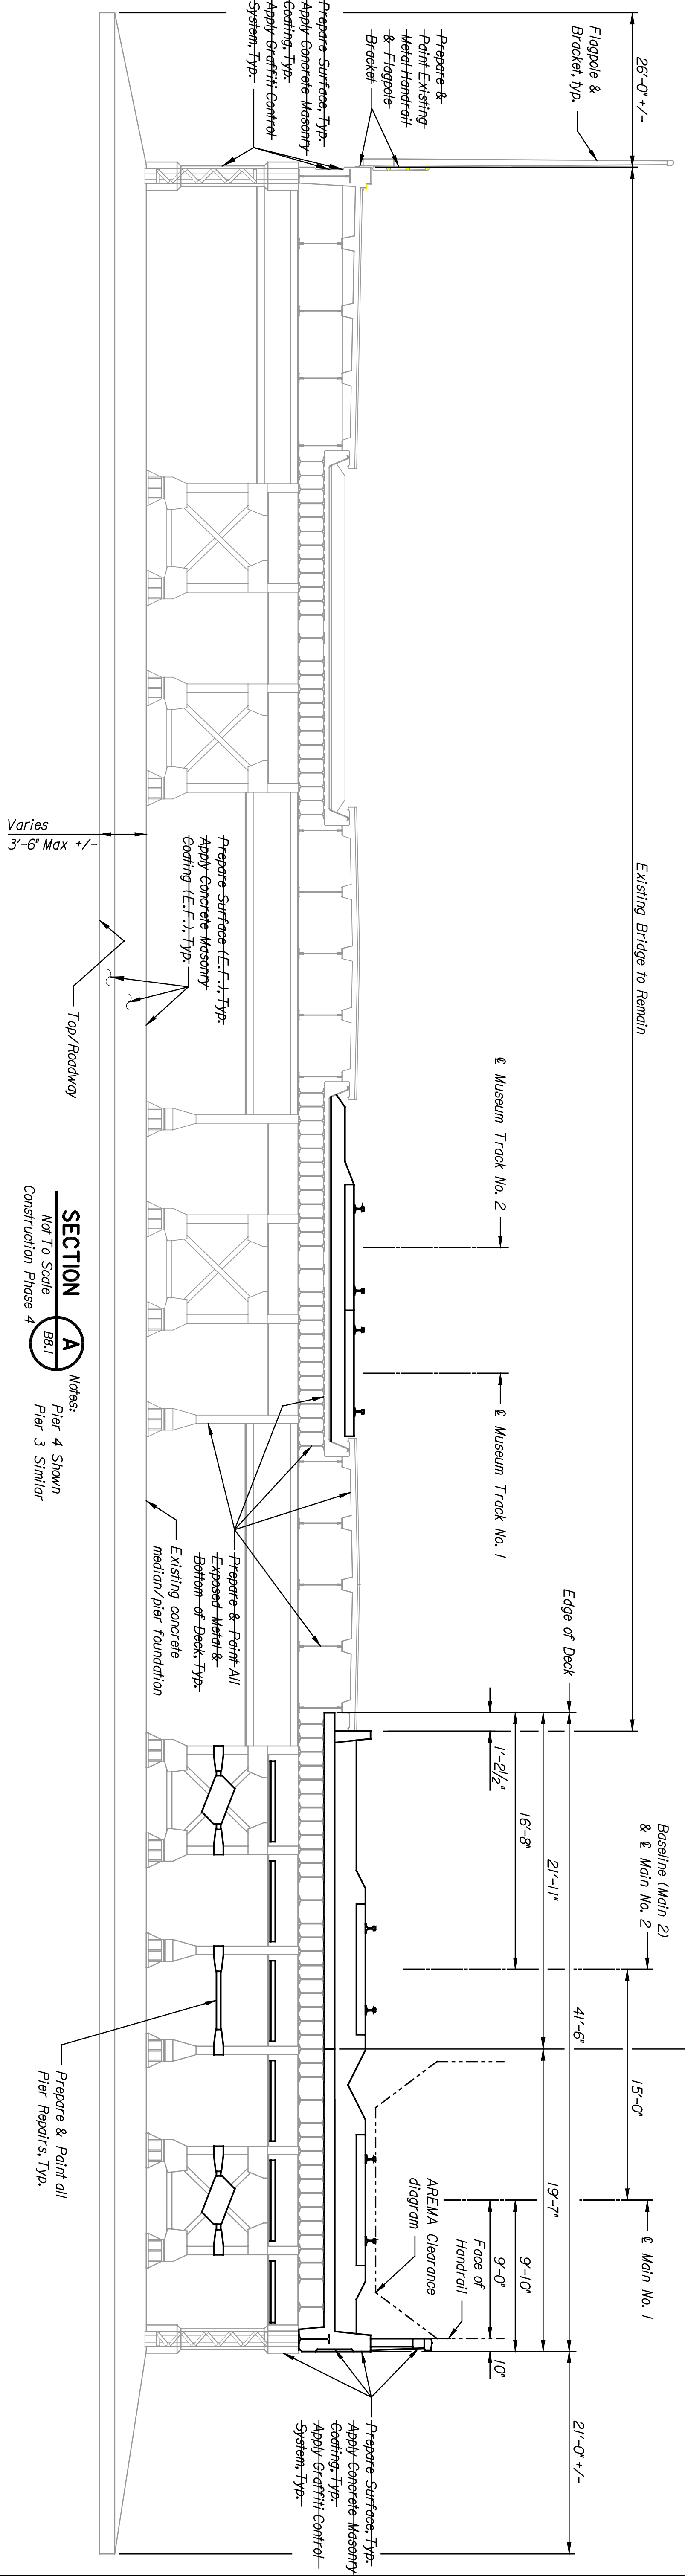

SECTION A
 Not To Scale
 Notes:
 Pier 4 Shown
 Pier 3 Similar
 Construction Phase 4

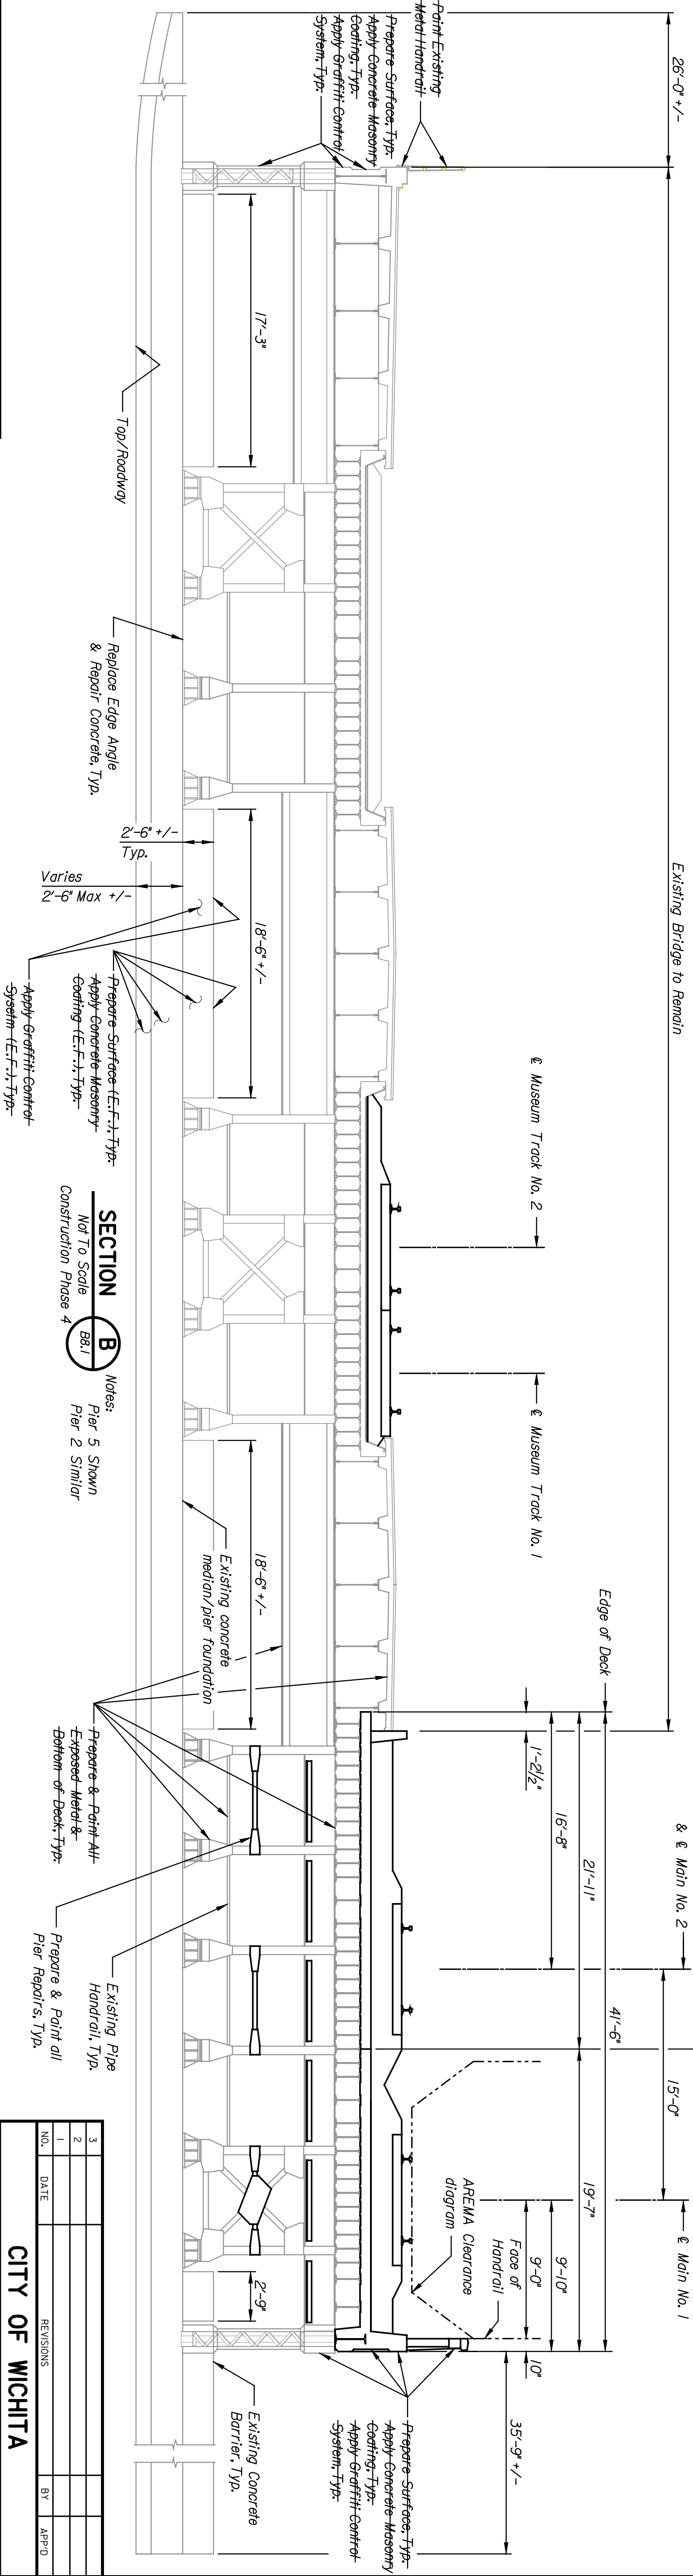

SECTION B
 Not To Scale
 Notes:
 Pier 5 Shown
 Pier 2 Similar
 Construction Phase 4

PNTB
 ARCHITECTS ENGINEERS PLANNERS

This sheet designed by:

STATE	PROJECT NO.	YEAR	TOTAL
KANSAS	472-84071	2005	B8.5


SHEET NO.	OF	SCALE AS NOTED	APPD.
DESIGNED	BY	DATE	BY
DESIGN CR.	BY	DATE	BY

CITY OF WICHITA
 DOUGLAS AVENUE
 TYPICAL SECTIONS - PHASE 4