



	BY	DATE

Plotted on: 04-JAN-2005 12:46 *time*
 dJamison Plot Queue: #queue*
 Plot Scale: #scale* Pen Table: #pentable*
 Design Filename: K:\B29049\BridgesDec2004\Base Bid\Douglas\Drawings\d02c.dgn

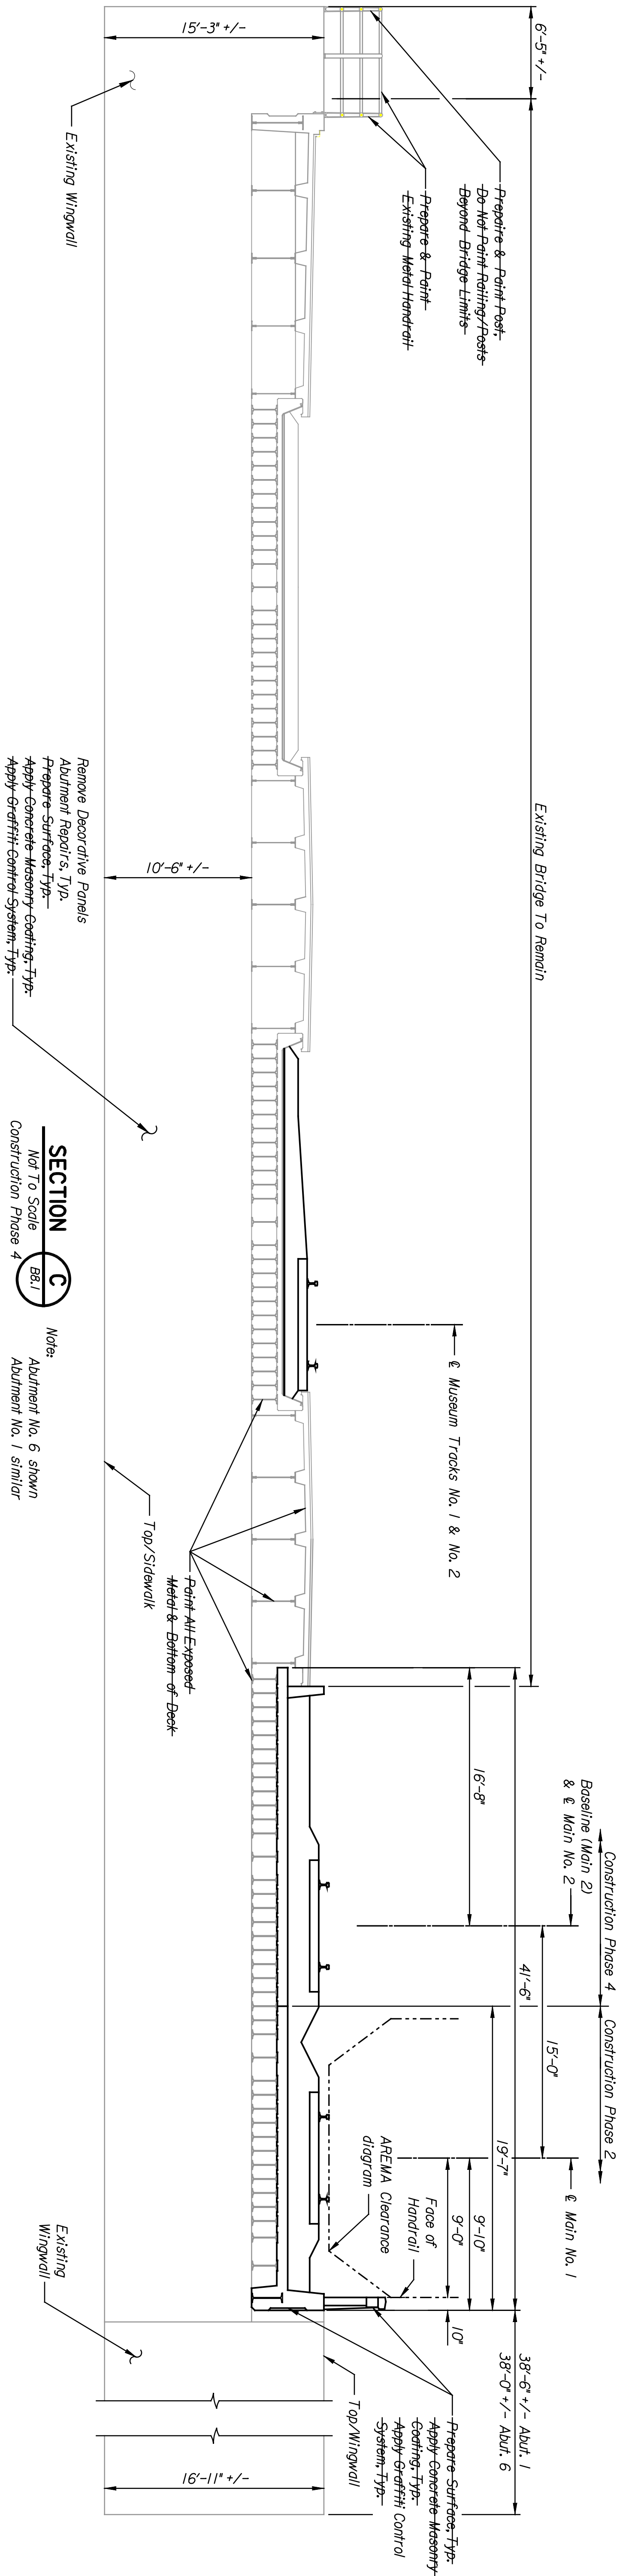

STATE	PROJECT NO.	YEAR	SHEET TOTAL
KANSAS	472-84071	2005	B8.6

This sheet designed by:

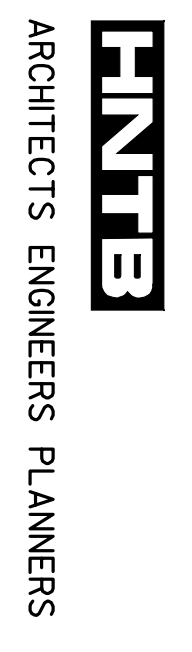

NOTES:
 Indicate all dimensions and sizes
 PER BR 20.4 WICHITA, KS

SHEET NO.	OF	SCALE AS NOTED	APPD.
DESIGNED BY	END	DETAILED BY	QUANTITIES BY
DESIGN CK.	CK.	DRAWN BY	TRACED BY

CITY OF WICHITA
 DOUGLAS AVENUE
 TYPICAL SECTIONS - PHASE 4

NO.	DATE	REVISIONS	BY	APPD.
1				
2				
3				