
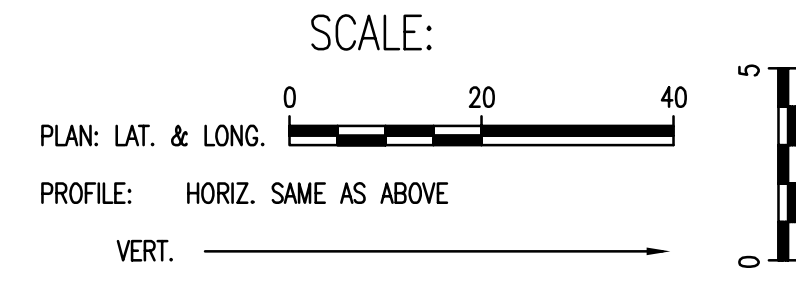


PLAN	CHECKED	CHECKED
BY		
DATE		


PROFILE	CHECKED	CHECKED
BY		
DATE		

Saved: 03-09-2006 2:54:24 PM by RBT
 Plot Scale: 1:20 03-09-2006 5:15:45 PM by RBT
 J:\SEN\01\2000\0310\2006-03-09 to City\Sanitary Sewer\04-1.mxd

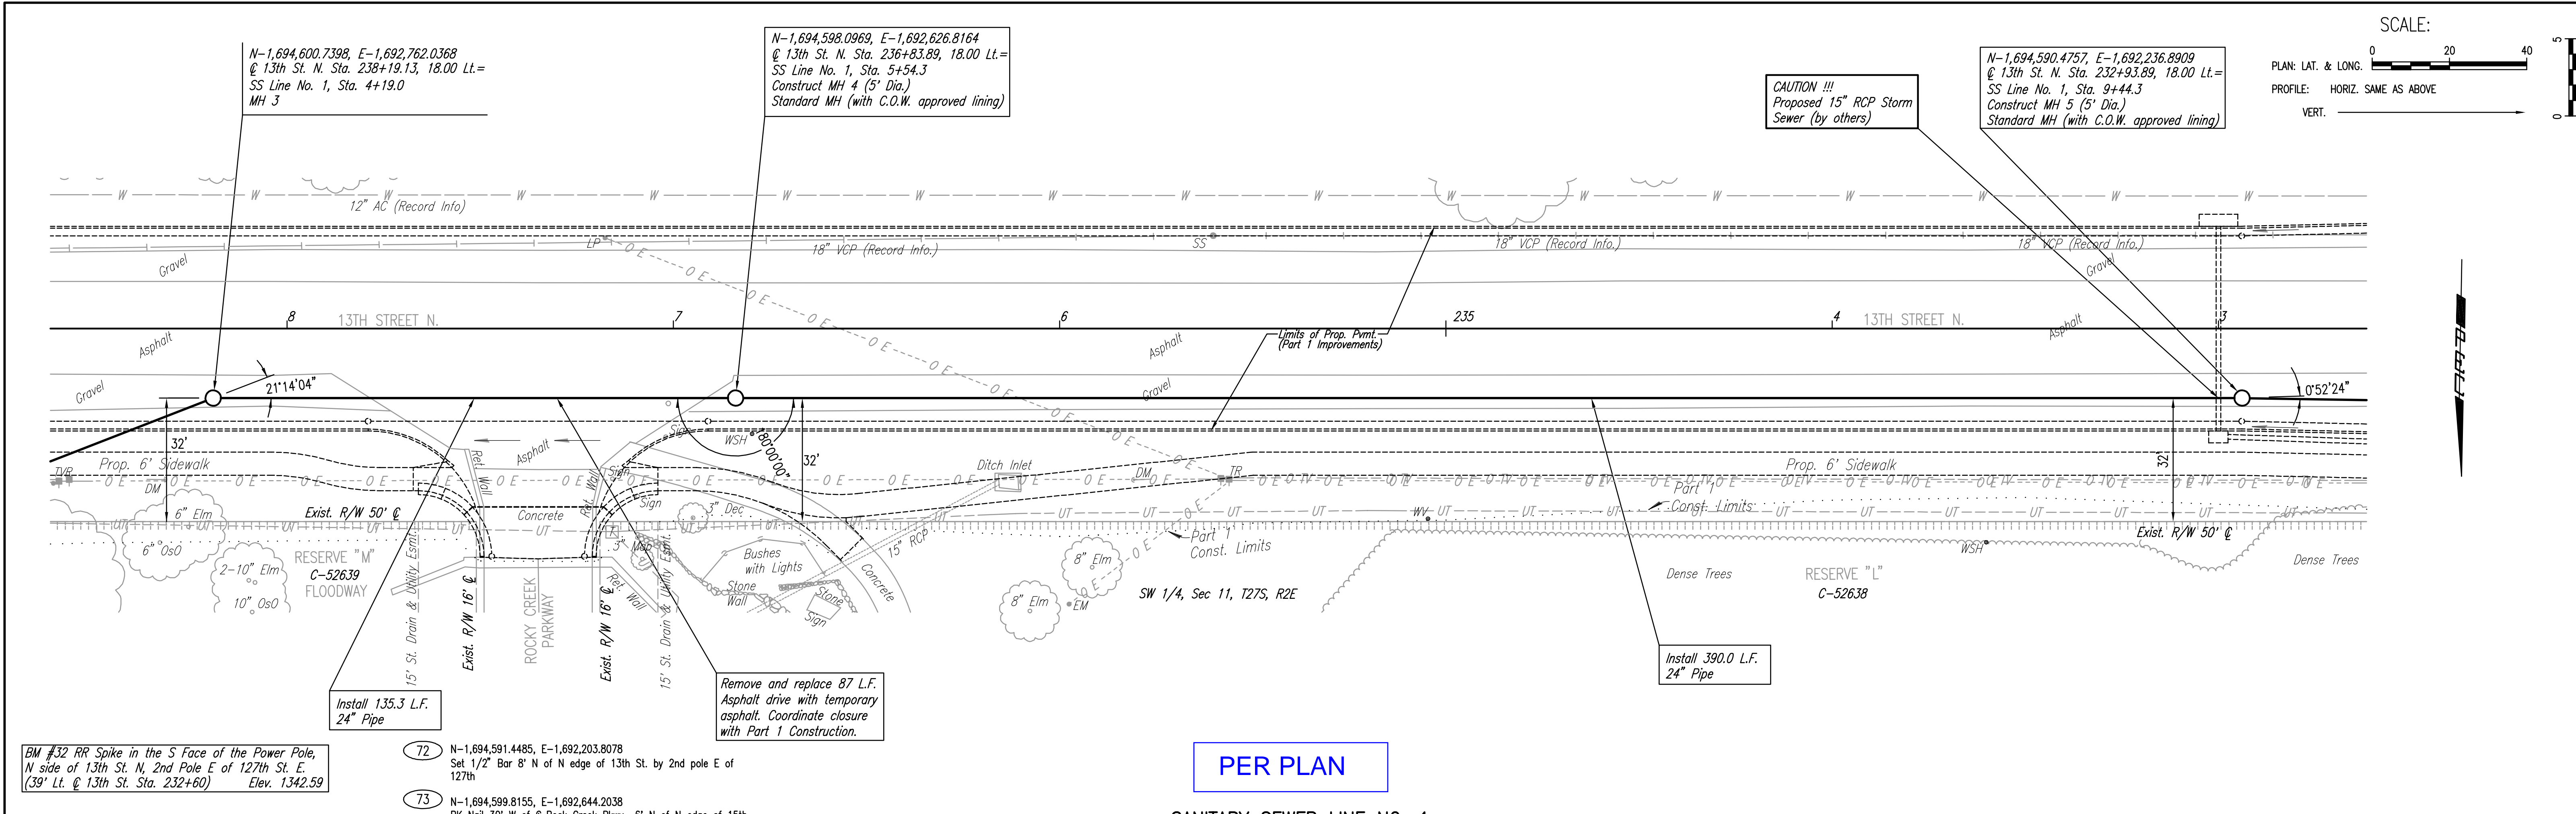

PER PLAN

SANITARY SEWER LINE NO. 1

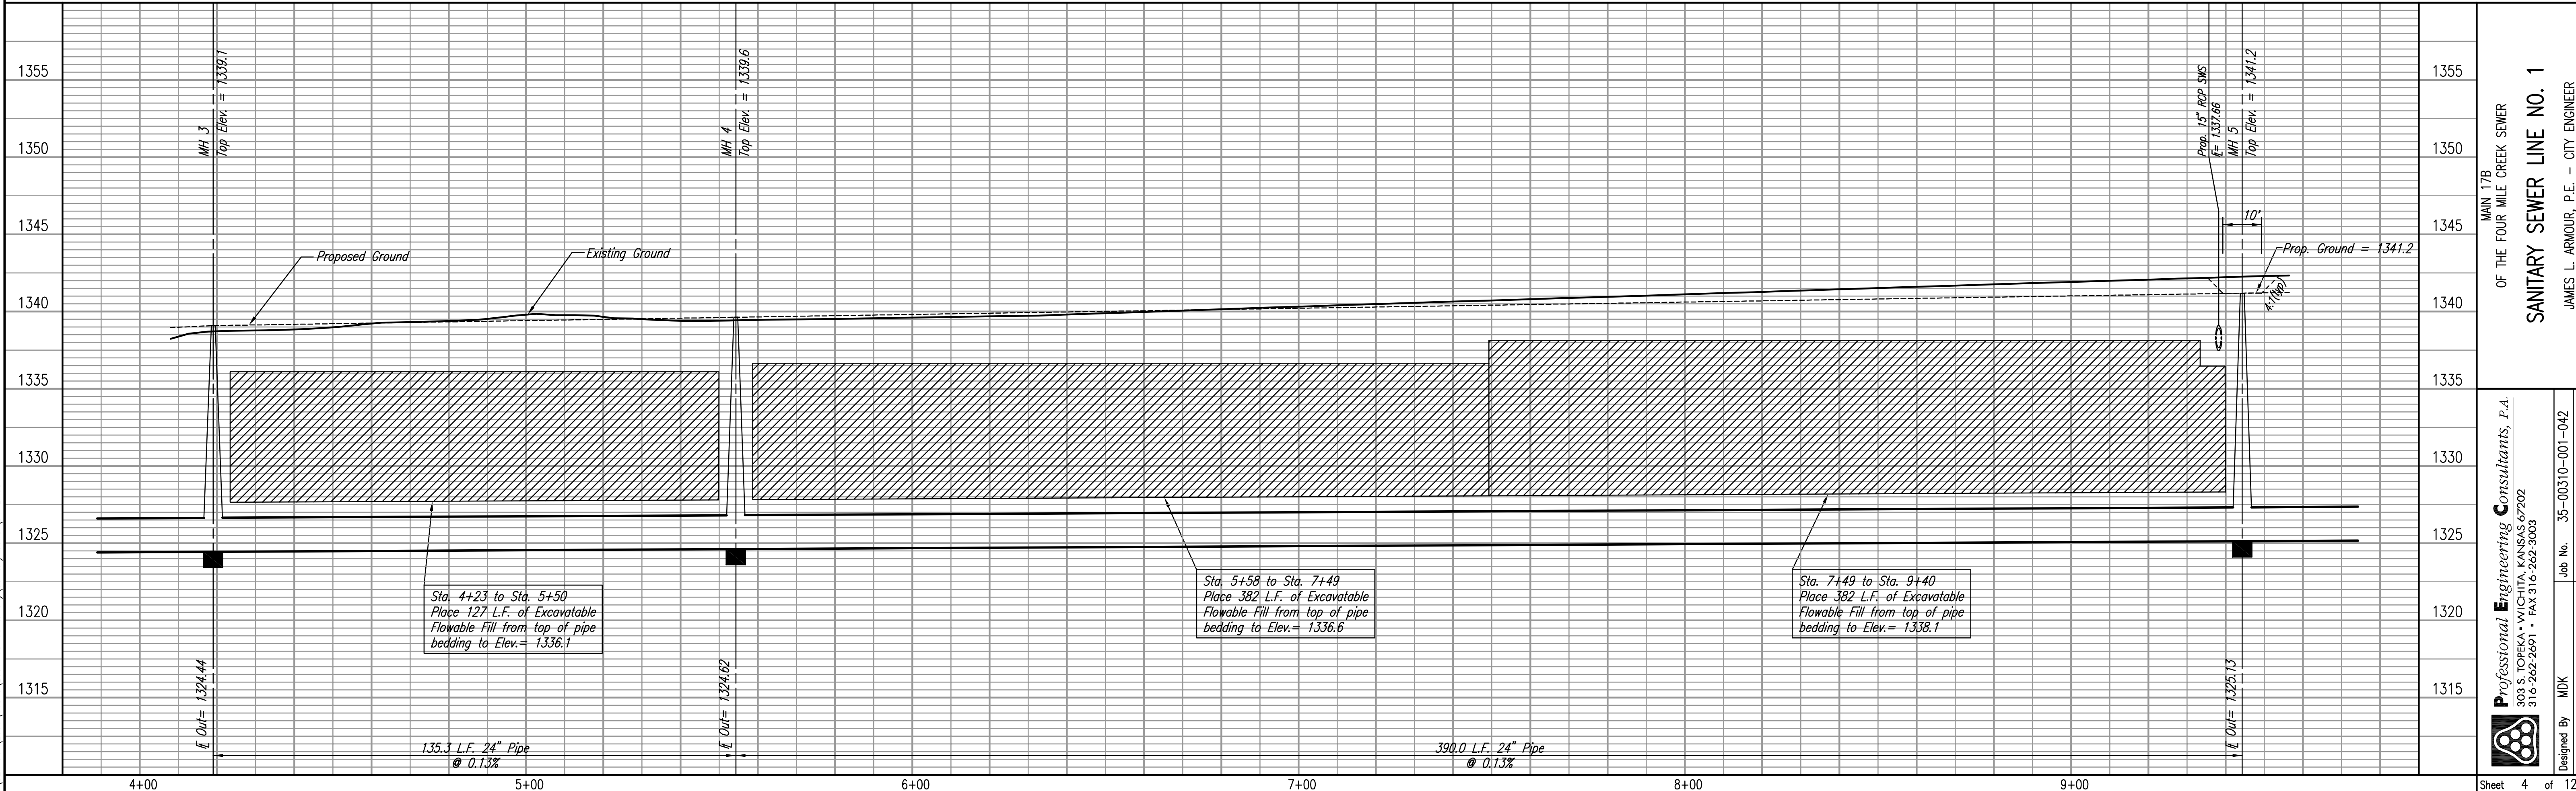

Professional Engineering Consultants, P.A.

Professional Engineering Consultants, P.A.
 OF THE FOUR MILE CREEK SEWER
SANITARY SEWER LINE NO. 1

DESIGNED BY: MDK
 DRAWN BY: AEE

Job No. 35-00310-001-042
 Date November 2005

JAMES L. ARMOUR, P.E. - CITY ENGINEER
 CITY OF WICHITA PROJECT NO. 468-84136

Sheet 4 of 12