
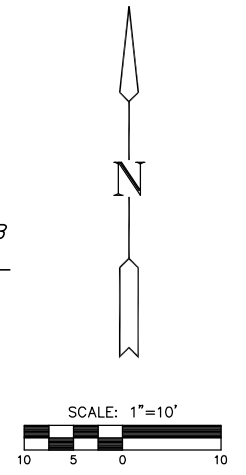


NOTE:
Boring location and information as shown on the plans represent the best information obtainable for design. Boring logs completed 8-10-05.

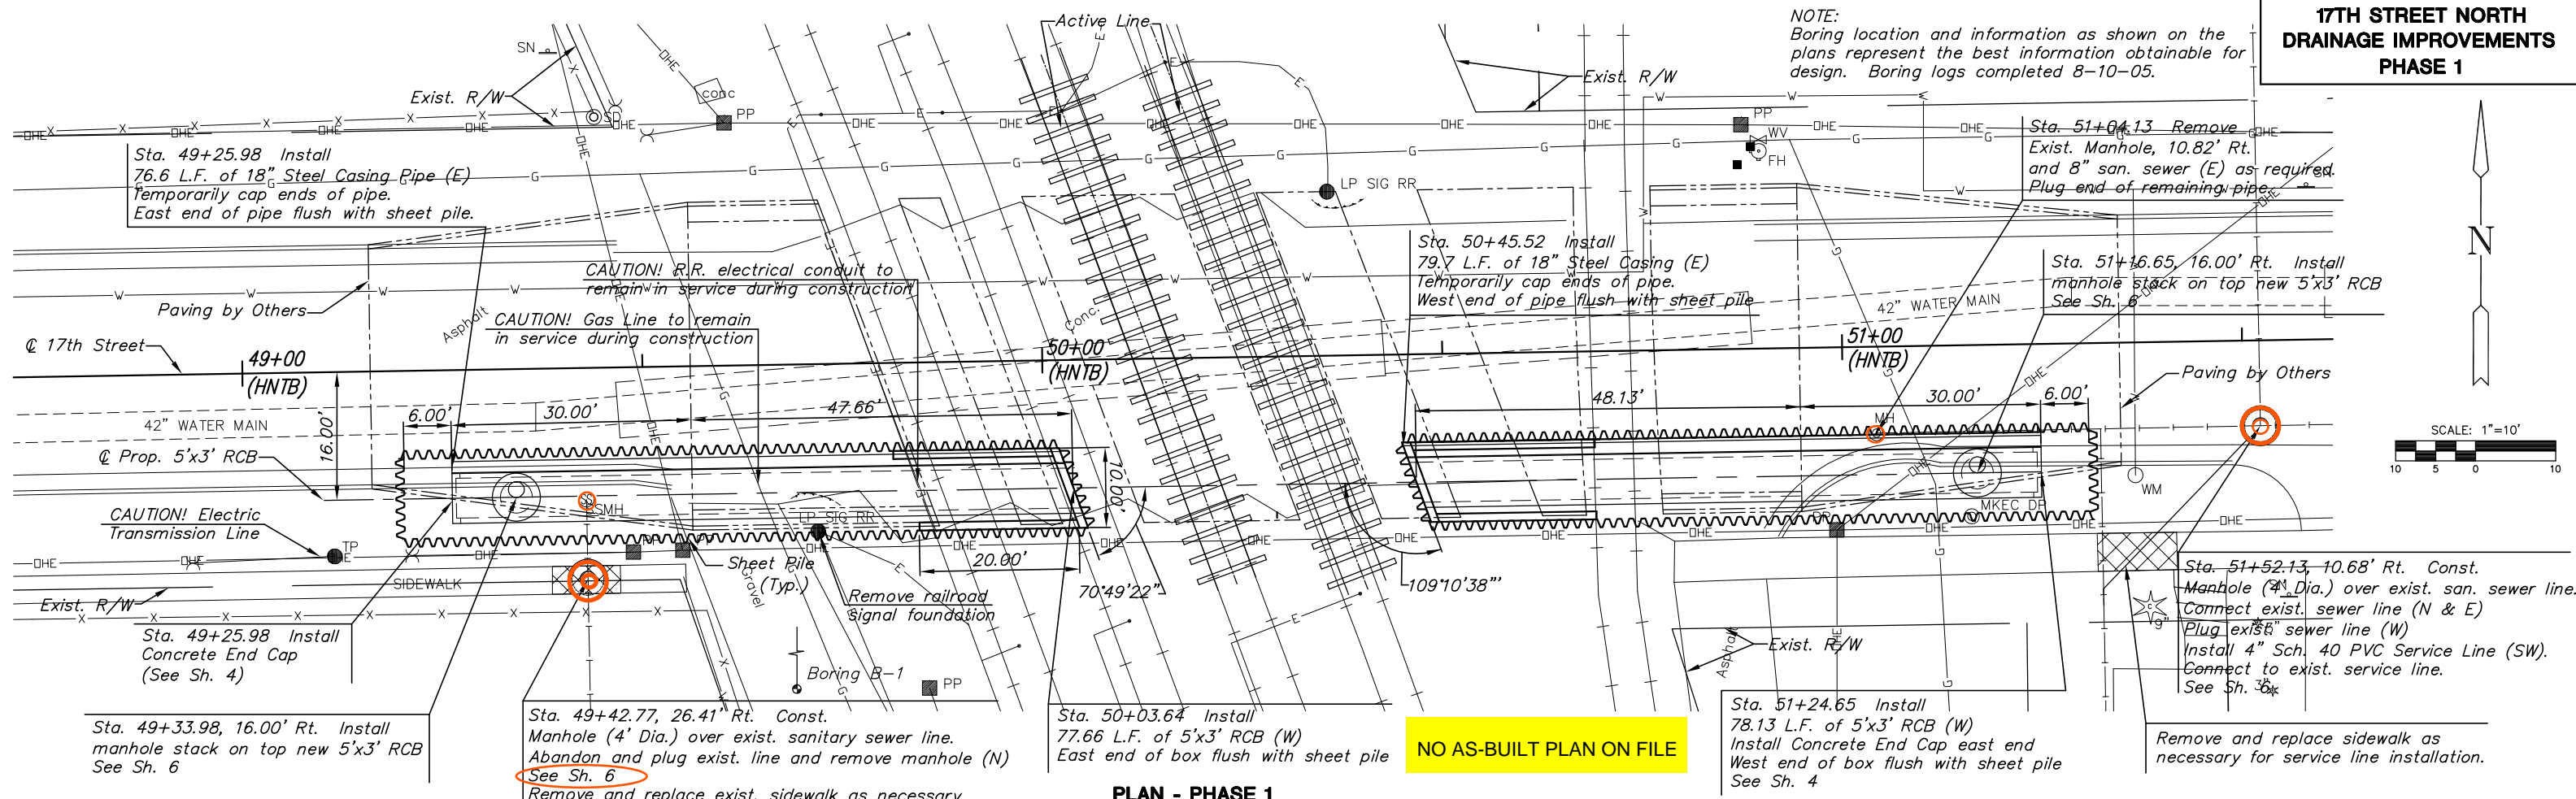

PROFILE - PHASE 1

Scale: Horiz. 1" = 10'
Vert. 1" = 10'

CONSTRUCTION NOTE: Sheet pile end wall, parallel to active railway shall remain in place; however, end wall is to be removed. All other sheet piling and waters to be removed at completion of backfilling operation.

