90417

SOUTHEAST 48" WATERLINE - PHASE 2A
LEWIS/IDA TO LEWIS/GREEN
AND LEWIS STREET SS ADJUSTMENT

OCA NO. 633796

CITY OF WICHITA PROJECT NO. **448-90310**

CITY OF WICHITA, KANSAS

JAMES L. ARMOUR, P.E. - CITY ENGINEER

BRB - Contractor
J. Wagner - City of Wichita, Field Project Engineer
J. DeCicco/K. Yale - City of Wichita, Inspectors
Release Date: 5/7/2010
As-built
WL : APRosas
SS PDF: APRosas 08/06/2010

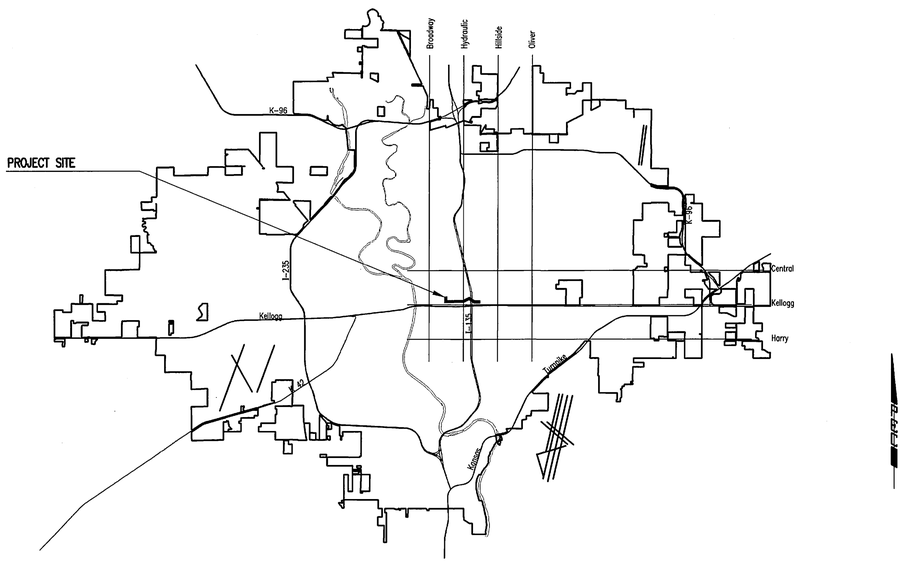

LOCATION MAP

INDEX OF SHEETS

SHEET NO. 1	TITLE SHEET
SHEET NO. 2	KEY MAP AND GENERAL NOTES
SHEET NO. 3	HORIZONTAL AND VERTICAL CONTROL
SHEET NO. 4	CITY OF WICHITA WATERLINE MAP
SHEET NO. 5	STANDARD WATERLINE DETAILS
SHEET NO. 6-7	WATERLINE DETAILS
SHEET NO. 8-24	WATERLINE PLAN/PROFILE
SHEET NO. 25-26	SANITARY SEWER ADJUSTMENT PLAN/PROFILE
SHEET NO. 27	TYPE "P" MANHOLE DETAILS
SHEET NO. 28	FRAME & COVER DETAILS
SHEET NO. 29	RISER DETAILS
SHEET NO. 30-32	SOIL EROSION BMP DETAILS
SHEET NO. 33	LANDSCAPE PLAN
SHEET NO. 34	PAVEMENT PLAN AND DETAILS
SHEET NO. 35	MISCELLANEOUS PAVEMENT DETAILS
SHEET NO. 36	STANDARD DRIVE ENTRANCE DETAILS
SHEET NO. 37	WHEELCHAIR RAMP DETAILS
SHEET NO. 38	TRAFFIC CONTROL PLAN

FEBRUARY 2009

PLANS PREPARED BY

PROFESSIONAL ENGINEERING CONSULTANTS, P.A.

ENGINEERS

WICHITA, KANSAS

ERIC J. BROCK
LICENSED
18603
2/05/09
KANSAS
PROFESSIONAL ENGINEER

Saved 02-03-2009 3:33:06 PM by JAN
Plot Scale 1:1 02-03-2009 4:08:38 PM by JAN
C:\2007\07704\DGN\PHASE 2A\07704-001-MLTITLE