
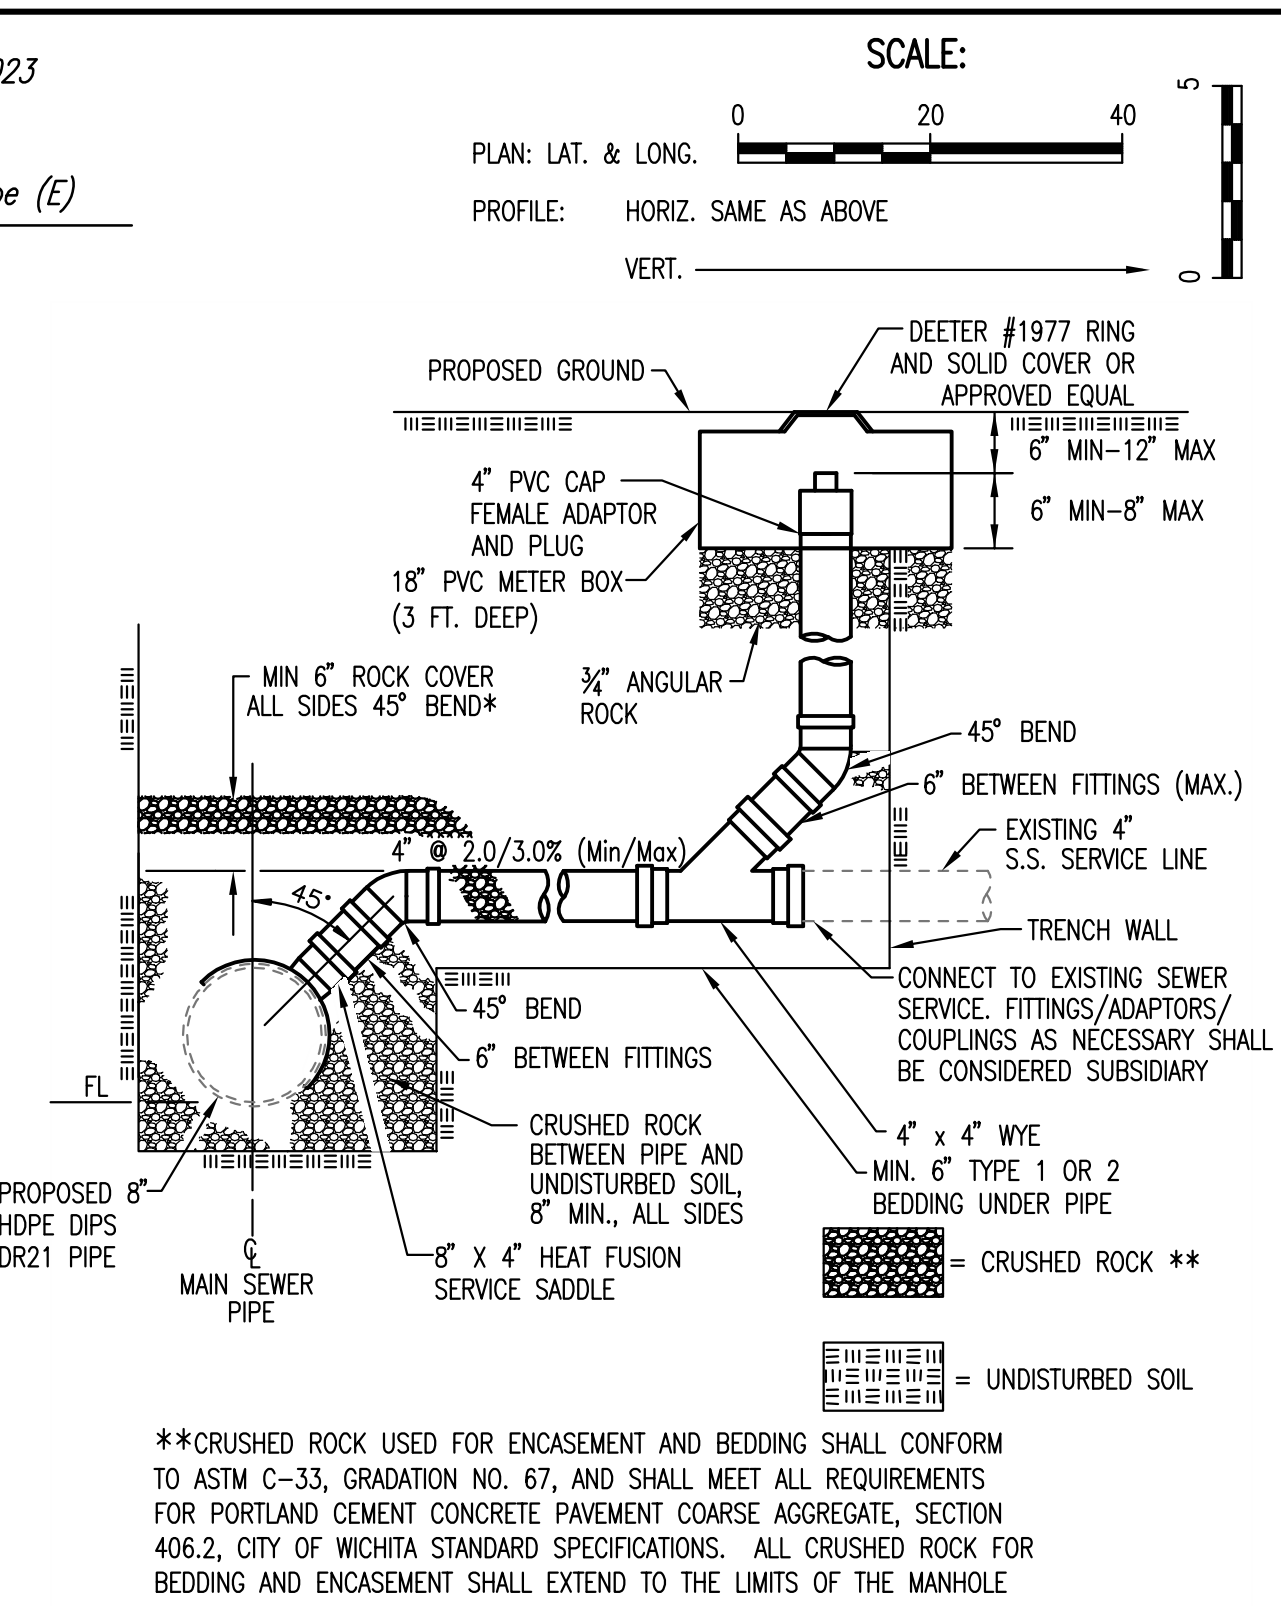



DATE	
BY	
CHECKED	CHECKED
PLAN	

DATE	
BY	
CHECKED	CHECKED
PROFILE	

Sowed 02-03-2009 10:42:04 AM by JLN  
 Plot Scale 1:20 02-03-2009 2:05:05 PM  
 Q:\2007\07704\000\PHASE 2A\07704-000-C-SSR02

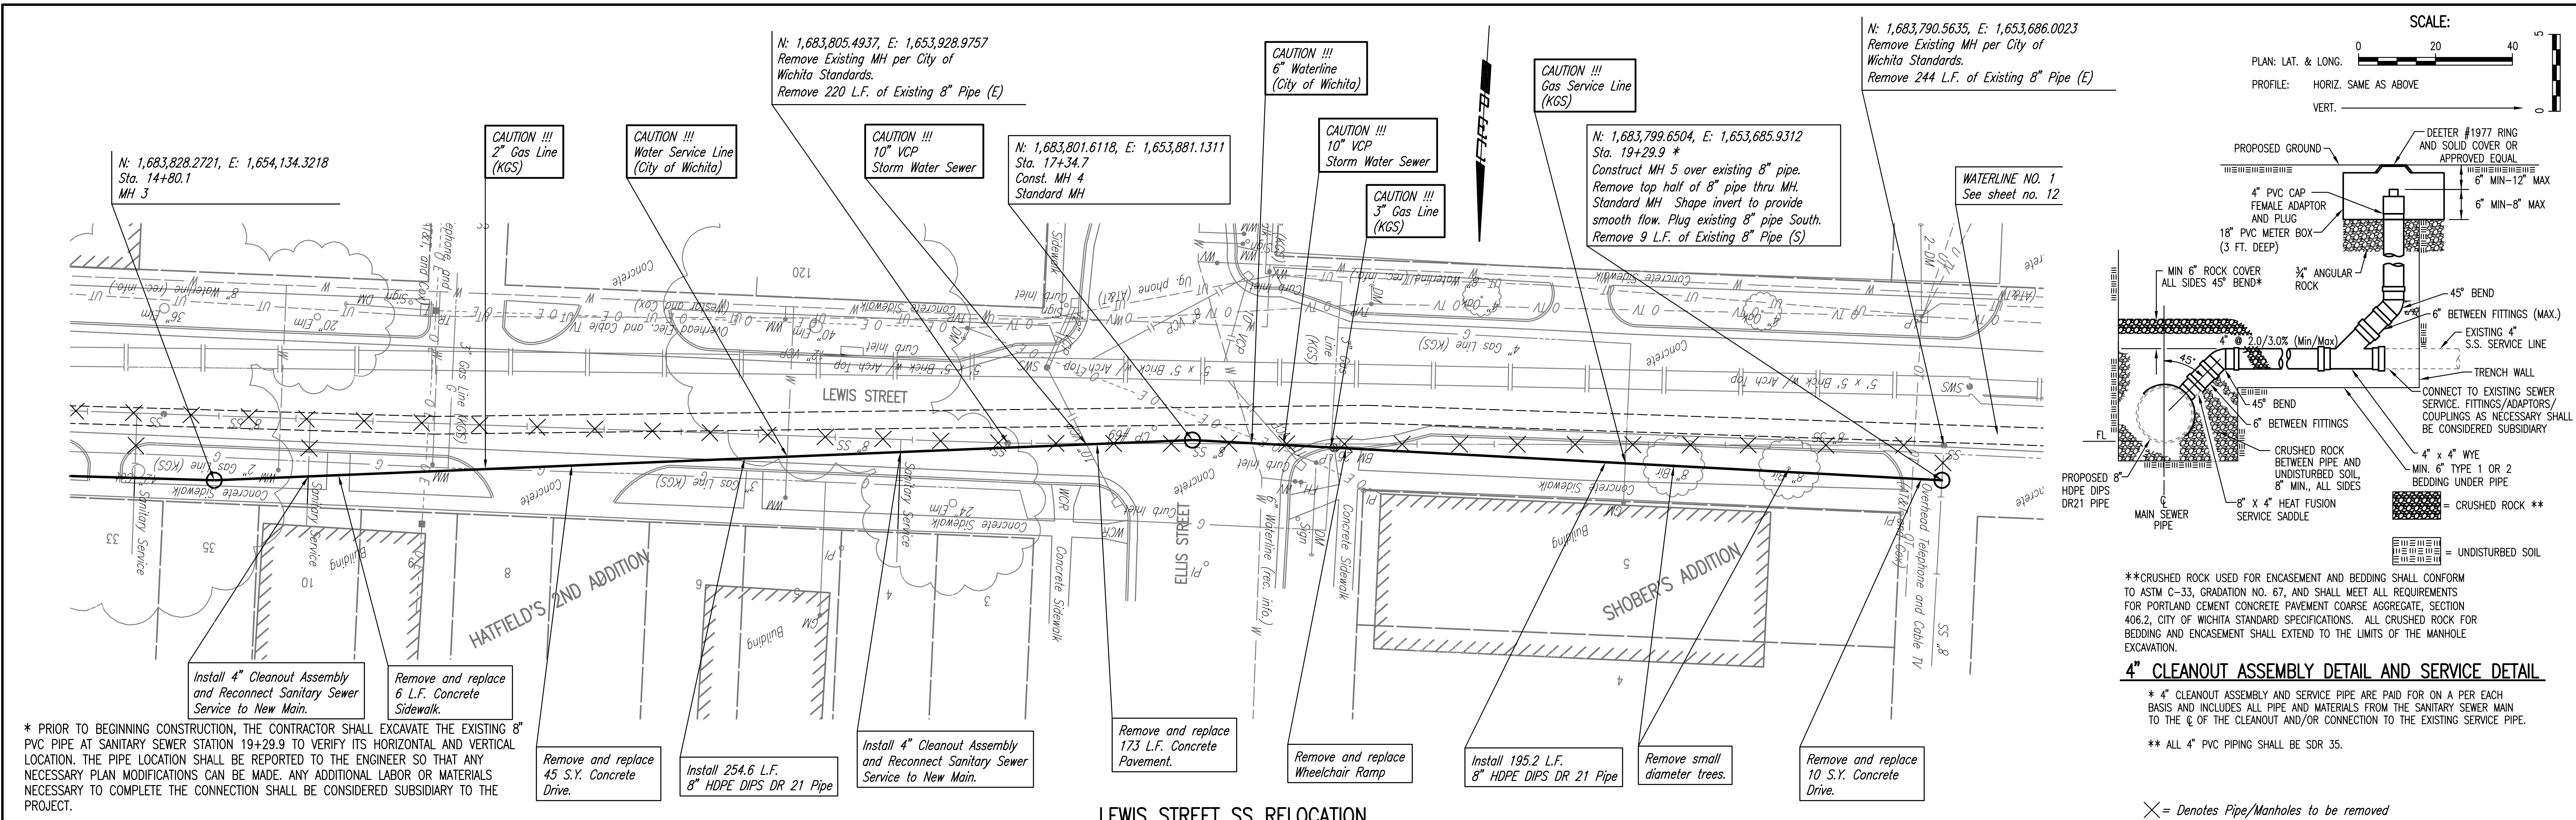

LEWIS STREET SS RELOCATION

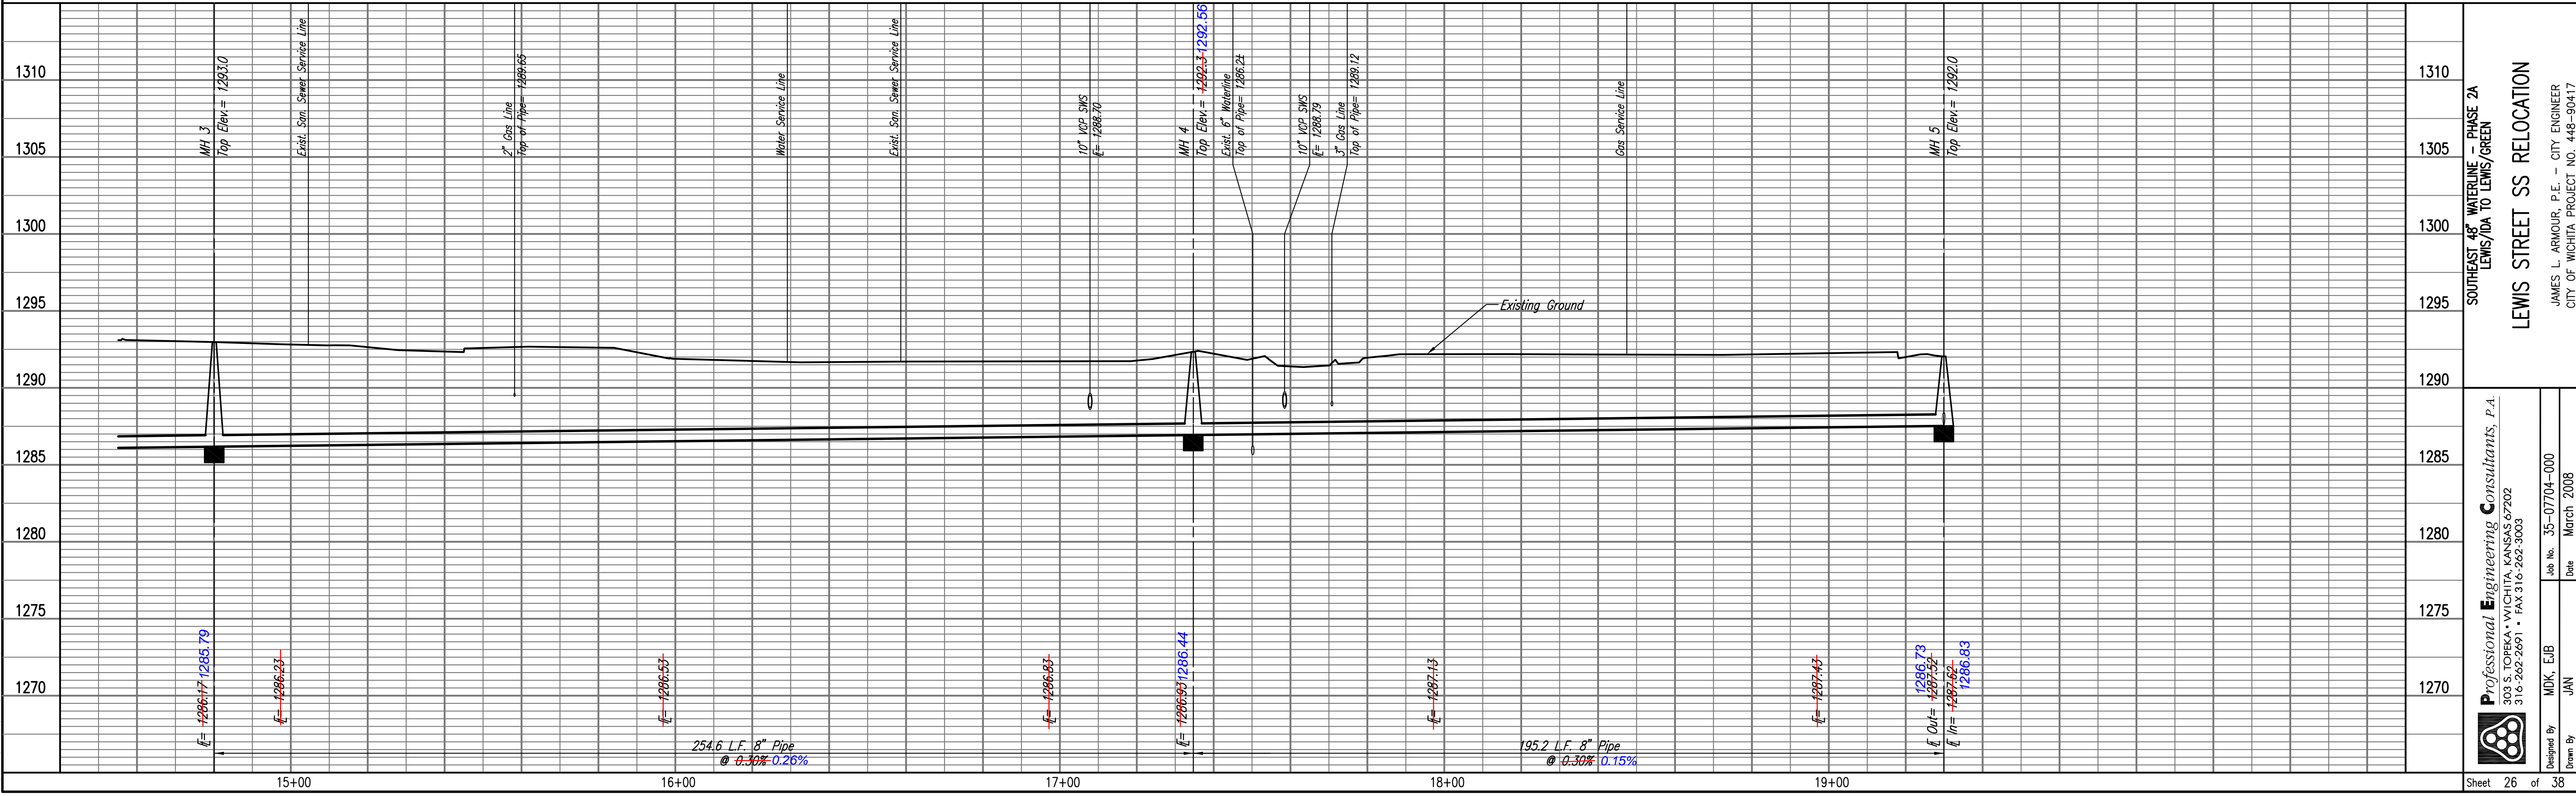

SOUTH EAST 48" WATERLINE - PHASE 2A  
 LEWIS/DA TO LEWIS/GREEN  
 LEWIS STREET SS RELOCATION  
 JAMES L. ARMOUR, P.E. - CITY ENGINEER  
 CITY OF WICHITA PROJECT NO. 448-90417  
 Professional Engineering Consultants, P.A.  
 903 S. TOPICKA AVENUE, WICHITA, KANSAS 67202  
 316.262.2691 • FAX 316.262.3003  
 Designed By MDK, EJB  
 Job No. 35-07704-000  
 Date March 2008  
 Drawn By JAN  
 Sheet 26 of 38