


Note: Core driller made a mistake in drilling - took mark of mh as top of pipe instead of bottom of pipe resulting in pipe installed 8" lower than planned.

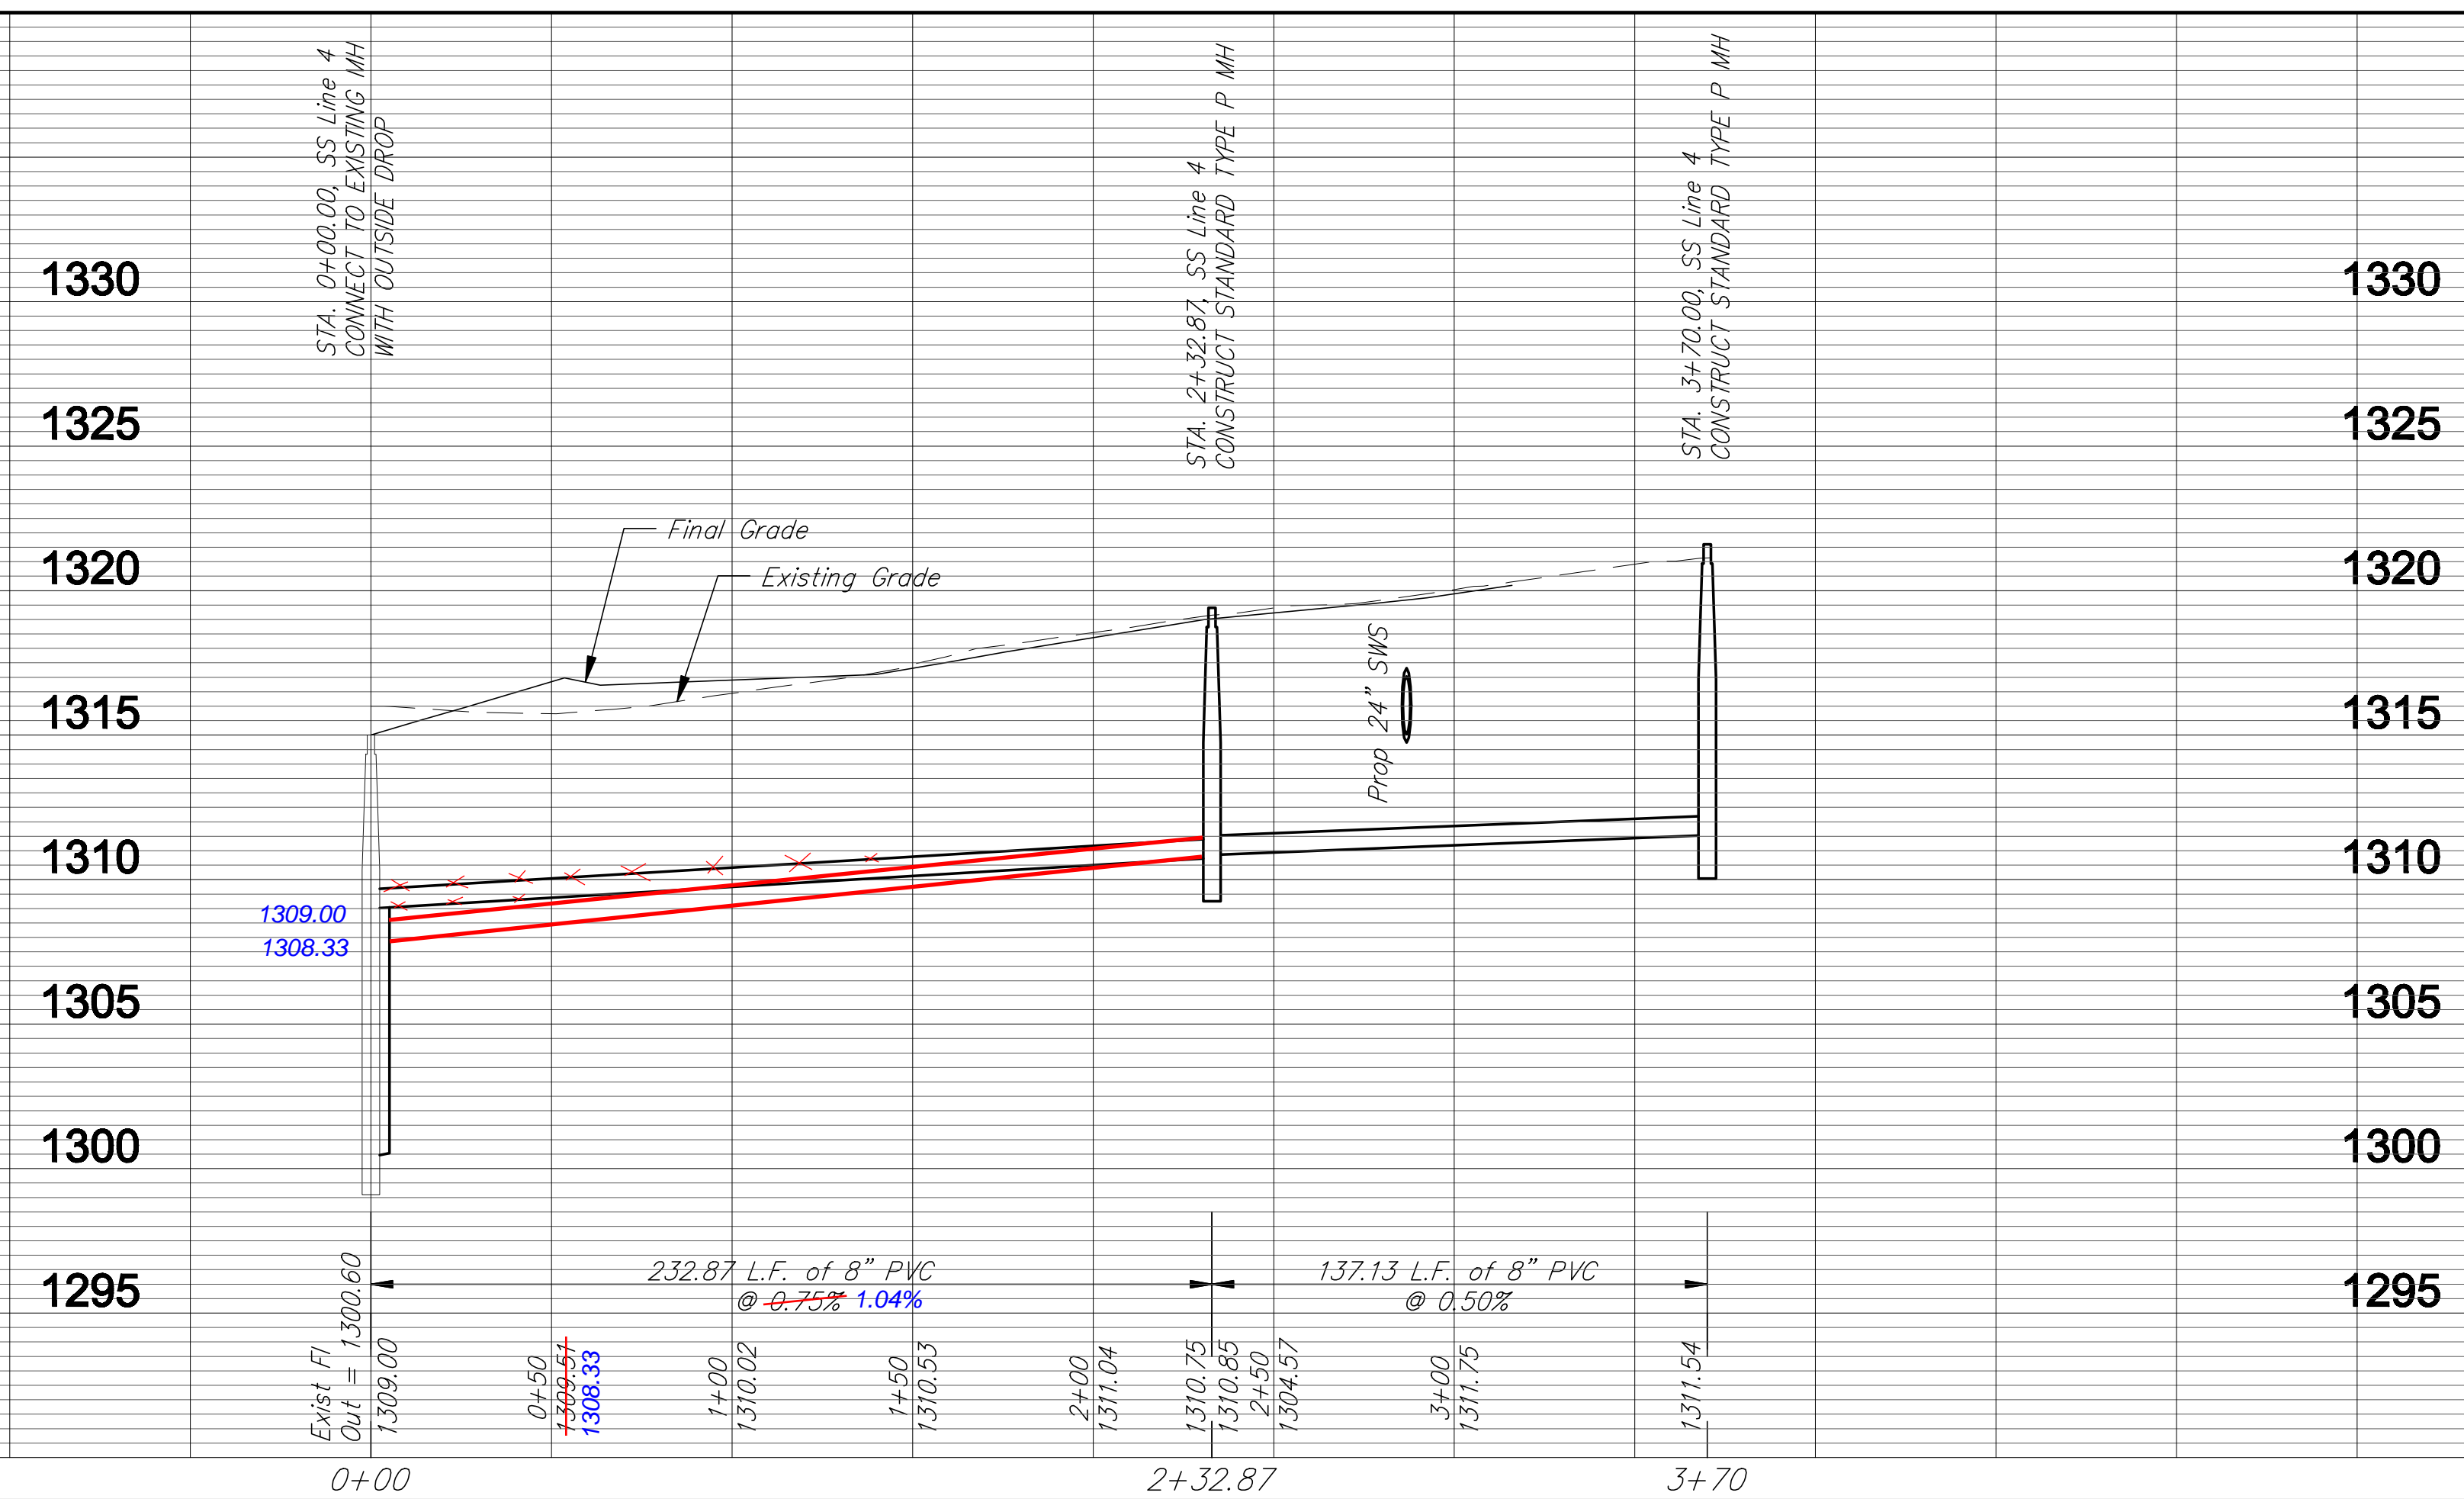

Ruggles & Bohm, P.A.
 Engineering, Surveying, Land Planning

PROJECT NUMBER
 468-84551

DATE
 Dec. 11, 2008

PROJECT NAME
 SANITARY SEWER IMPROVEMENTS
 LINE 3 & 4
 WICHITA, KANSAS





