
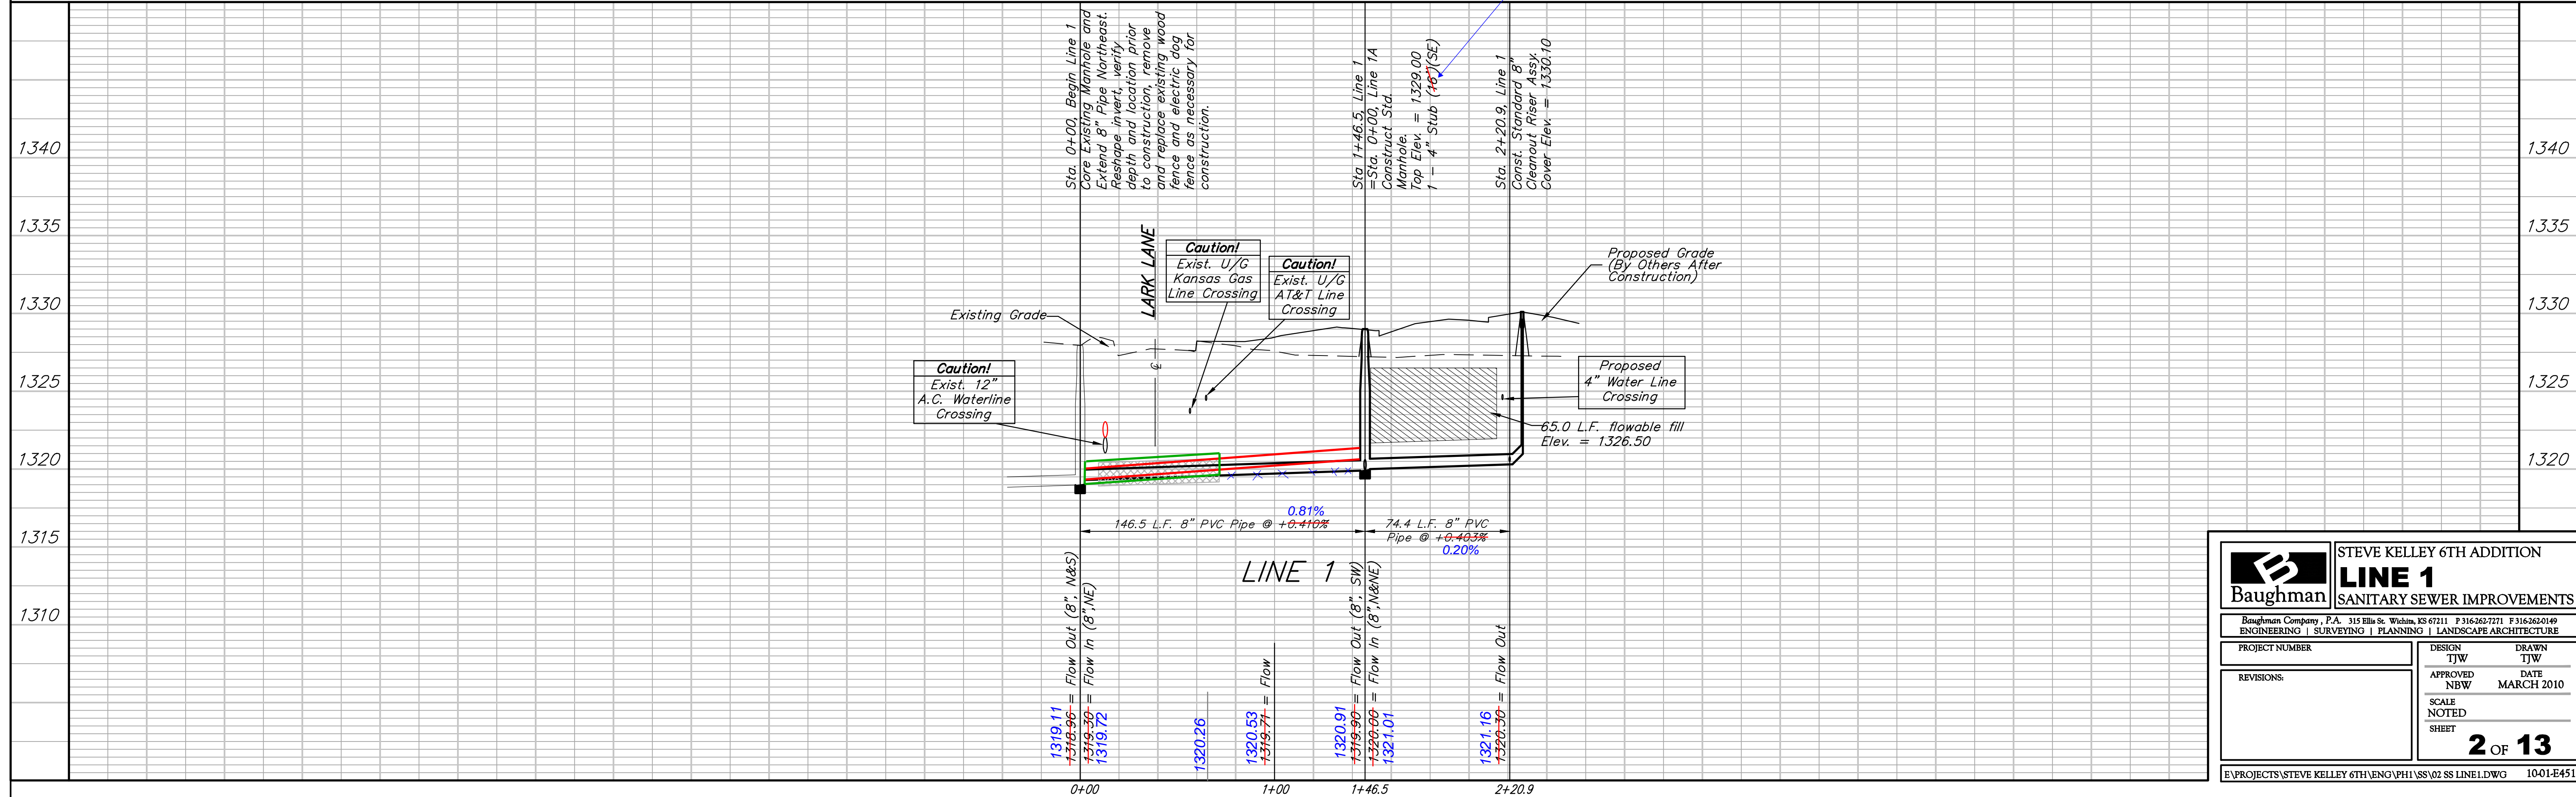
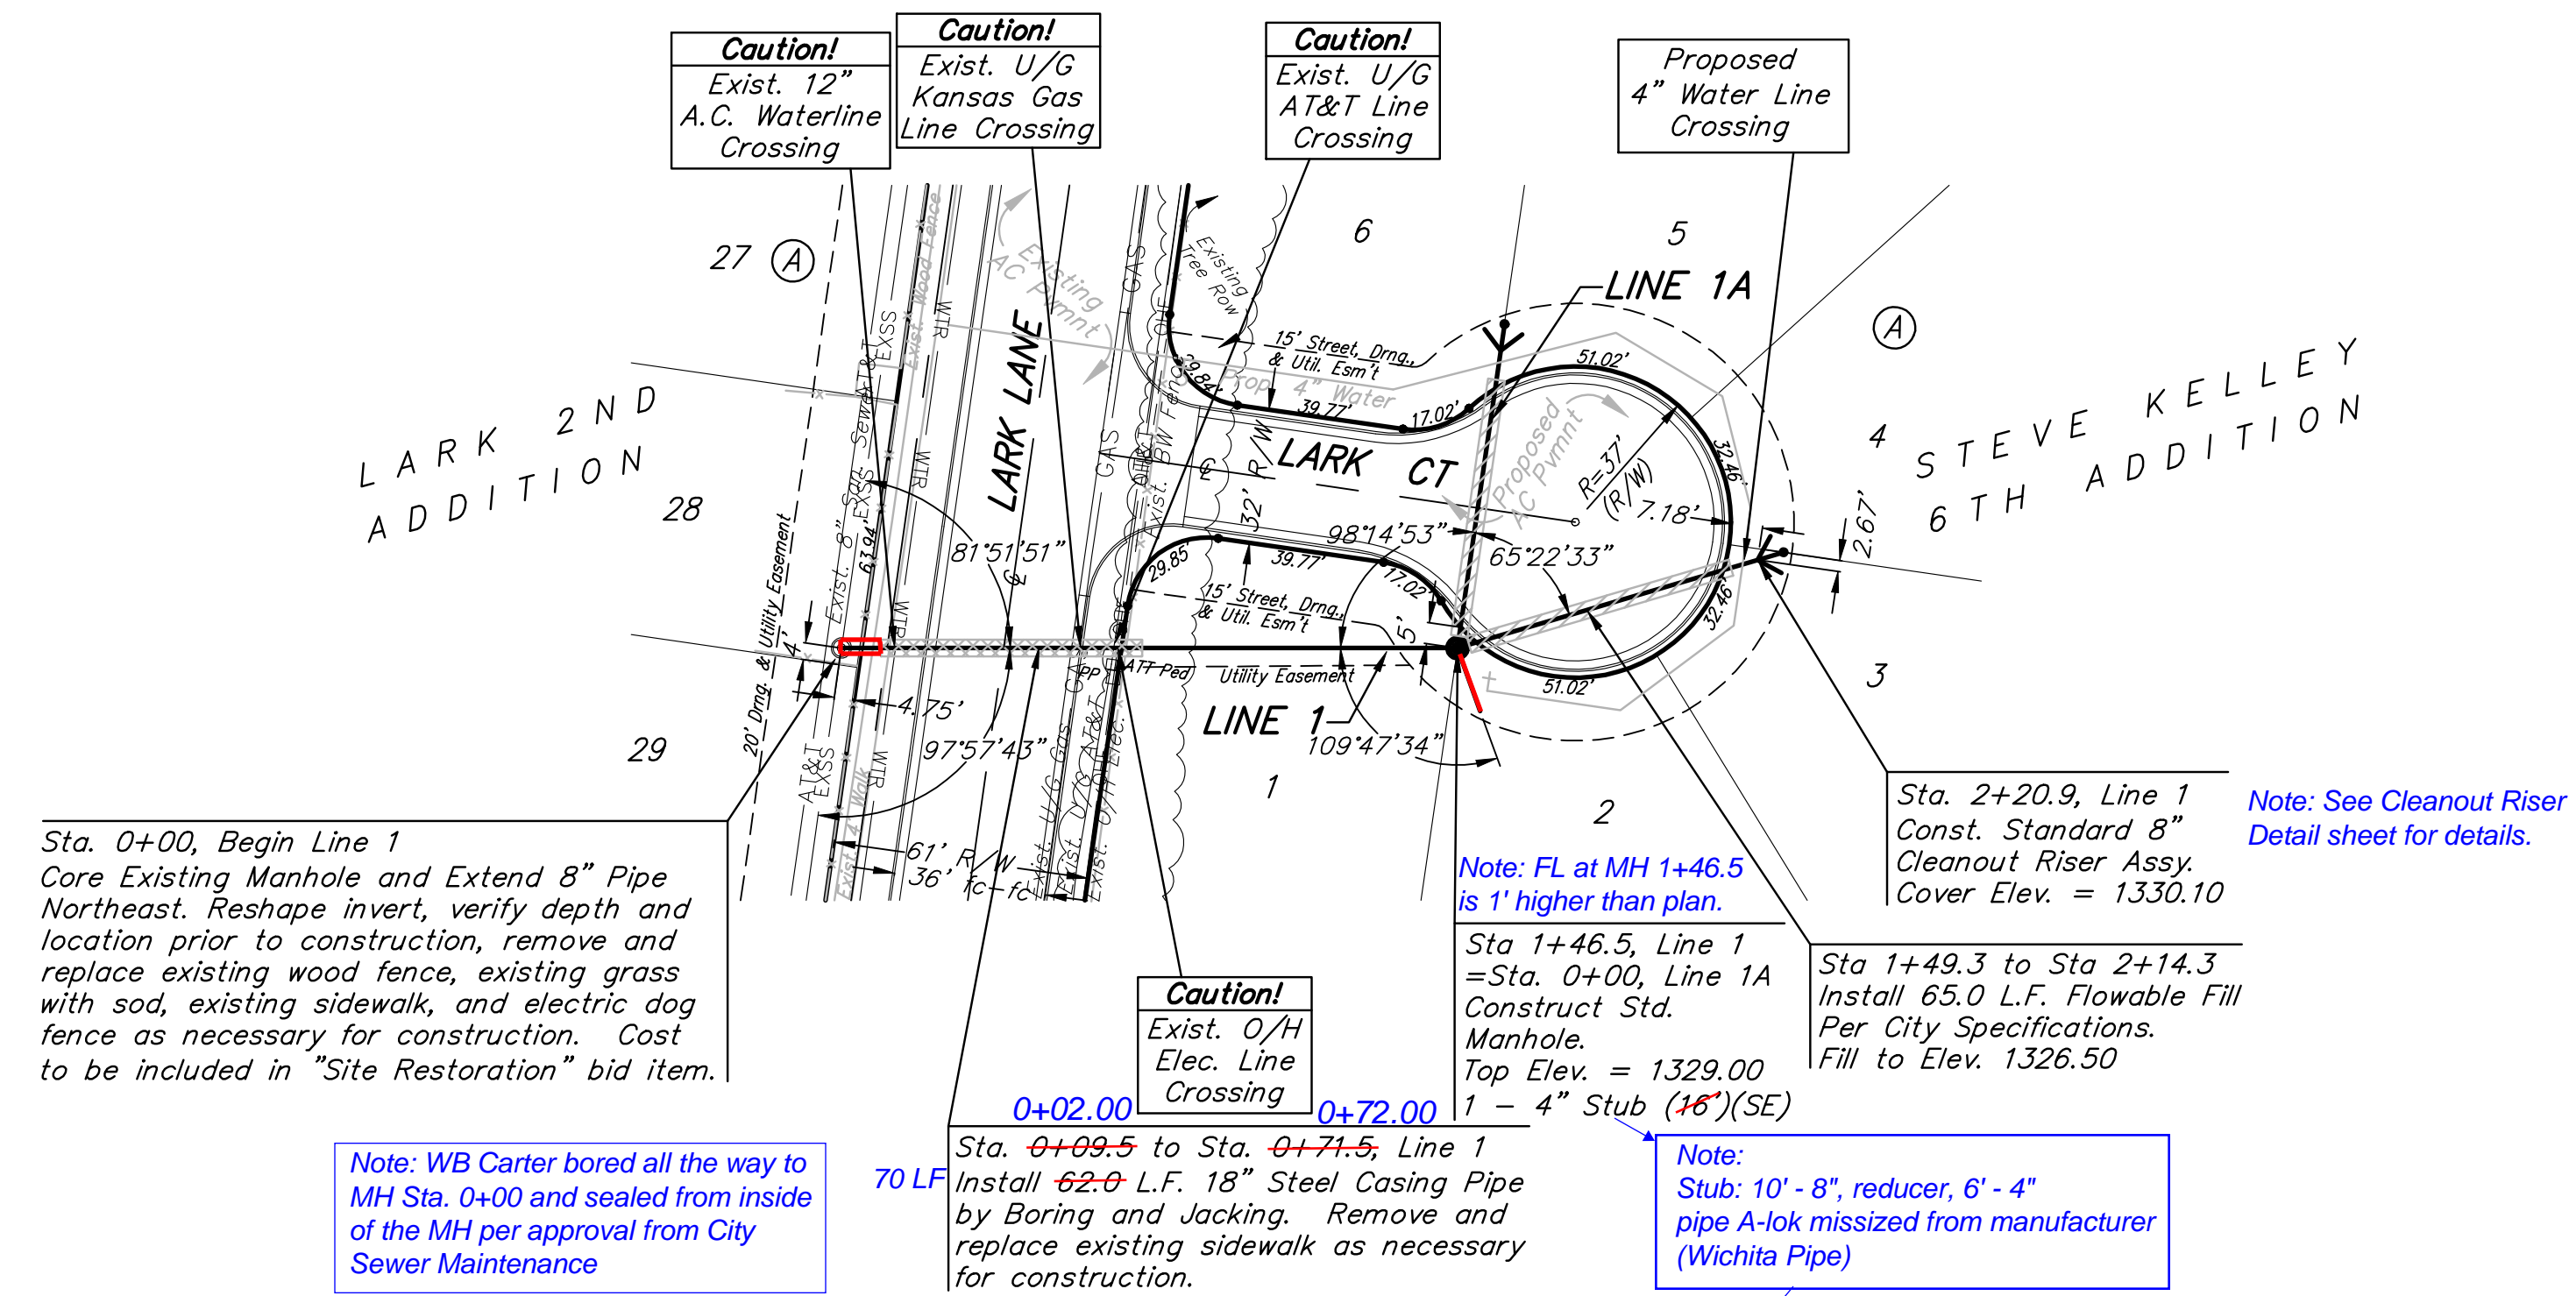


**BENCHMARK:**  
 SQUARE CUT TOP OF  
 CURVE 9 FEET WEST OF  
 NORTHWEST CORNER OF  
 LOT AT 1900 S. LARK  
 ELEV. = 1328.49 (NAVD 88)

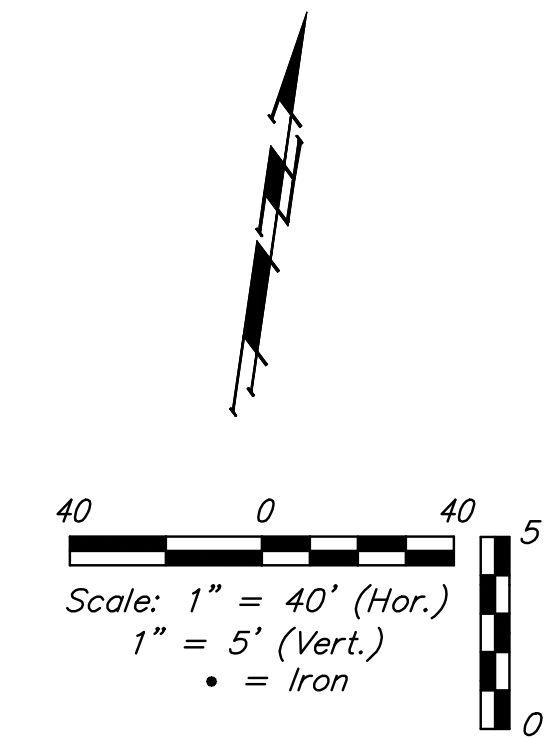

		STEVE KELLEY 6TH ADDITION	
		<b>LINE 1</b>	
Baughman Company, P.A. 315 Ellis St. Wichita, KS 67211 P 316-262-7271 F 316-262-0149 ENGINEERING   SURVEYING   PLANNING   LANDSCAPE ARCHITECTURE		PROJECT NUMBER: _____ DESIGN: TJW DRAWN: TJW APPROVED: NBW DATE: MARCH 2010 SCALE: NOTED SHEET: <b>2 OF 13</b>	
REVISIONS: _____ _____ _____		E:\PROJECTS\STEVE KELLEY 6TH\ENG\PH1\SS\02 SS LINE1.DWG 1001-E451	