
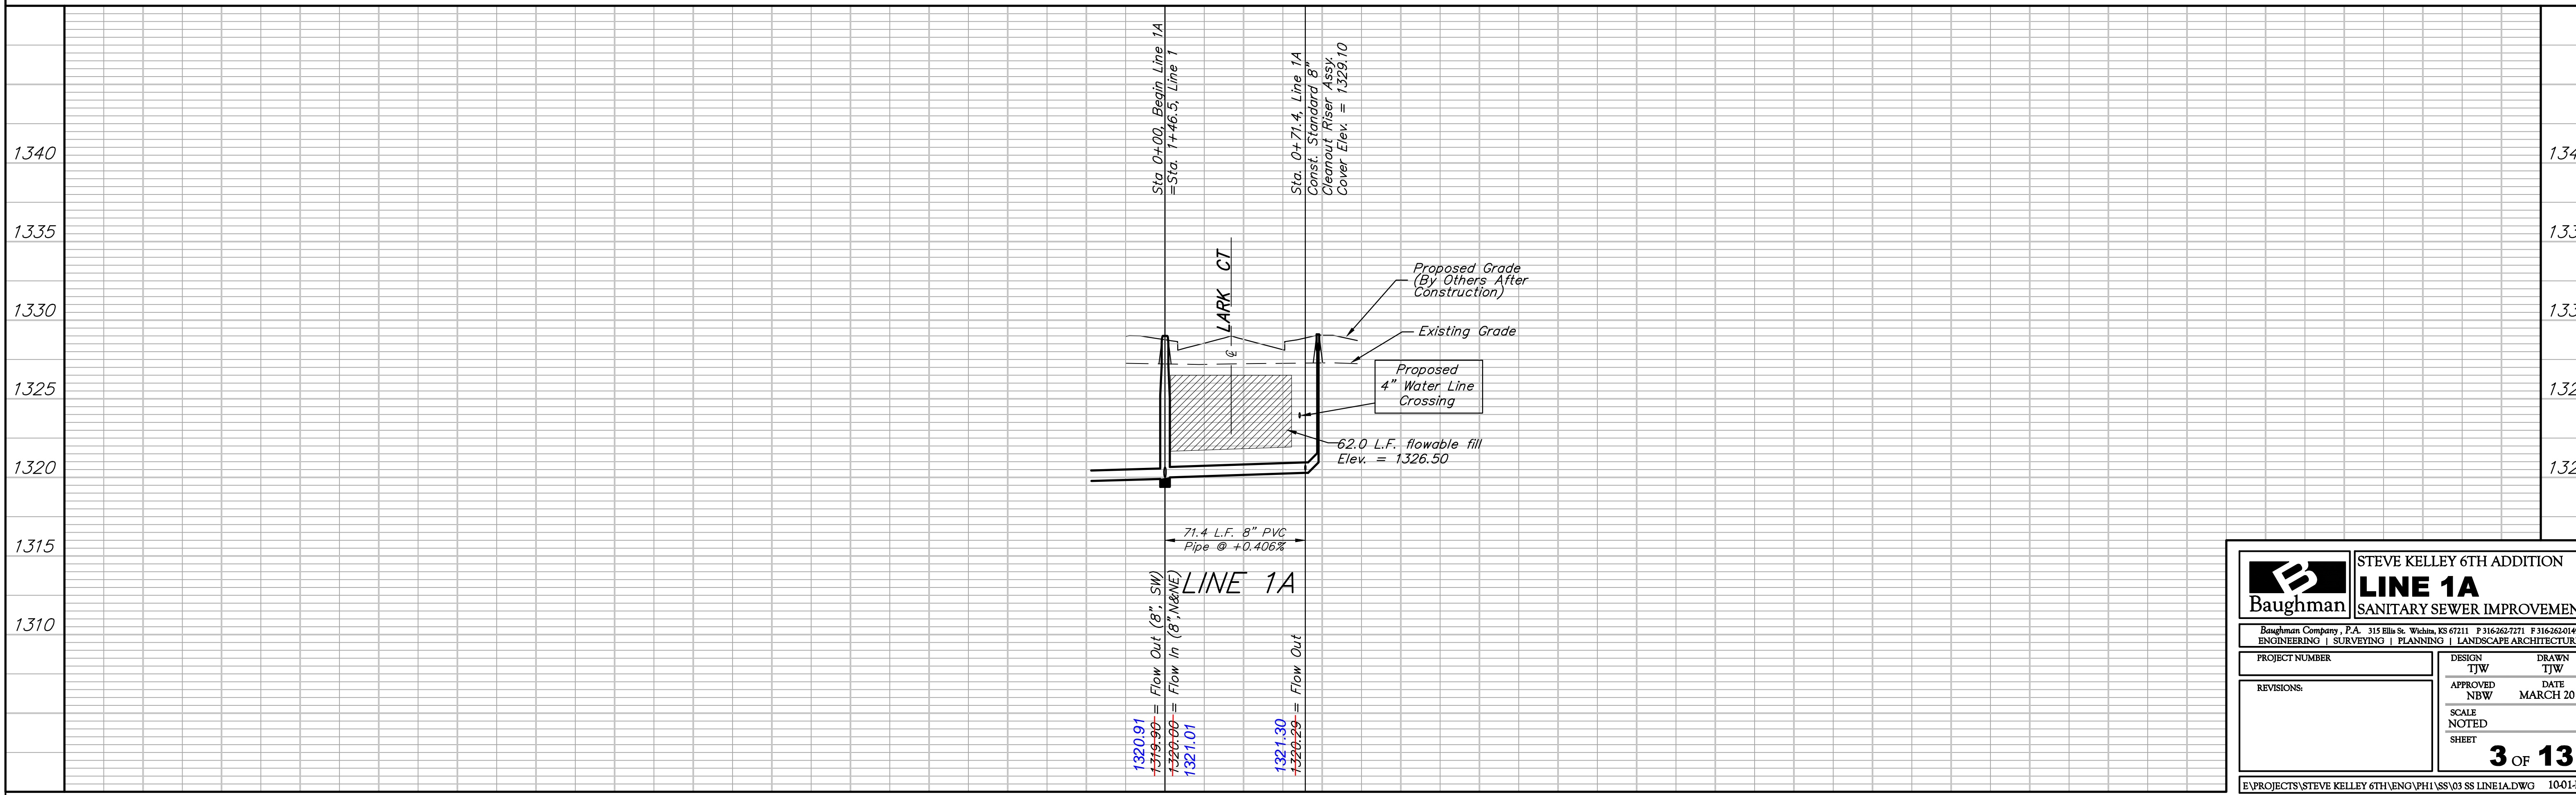
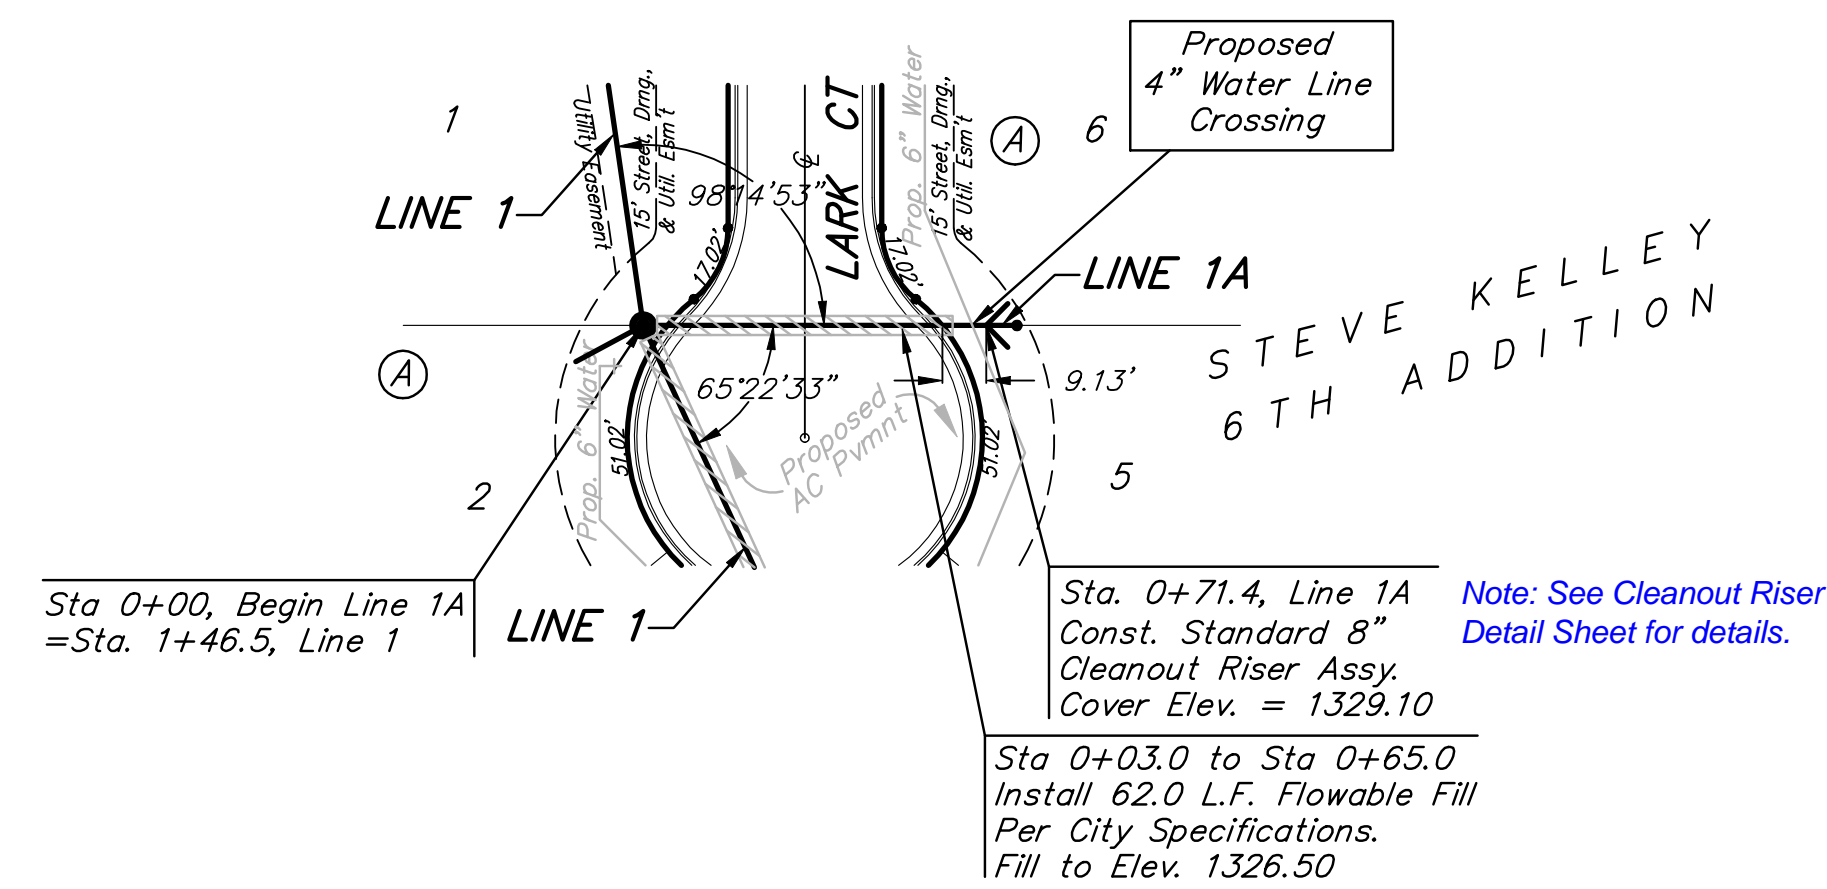


**BENCHMARK:**

SQUARE CUT TOP OF  
CURVE 9 FEET WEST OF  
NORTHWEST CORNER OF  
LOT AT 1900 S. LARK  
ELEV. = 1328.49 (NAVD 88)

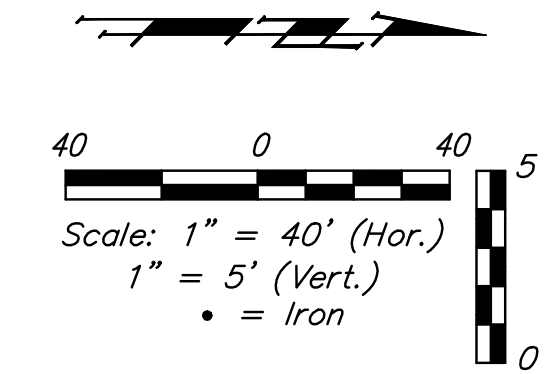

		STEVE KELLEY 6TH ADDITION	
		<b>LINE 1A</b>	
Baughman Company, P.A. 315 Ellis St. Wichita, KS 67211 P 316-262-7271 F 316-262-0149 ENGINEERING   SURVEYING   PLANNING   LANDSCAPE ARCHITECTURE		PROJECT NUMBER: _____ DESIGN: TJW DRAWN: TJW APPROVED: NBW DATE: MARCH 2010 SCALE: NOTED SHEET: <b>3 OF 13</b>	
REVISIONS:		PROJECTS\STEVE KELLEY 6TH\ENGVPH1\SS\03 SS LINE1A.DWG 10-01-E451	