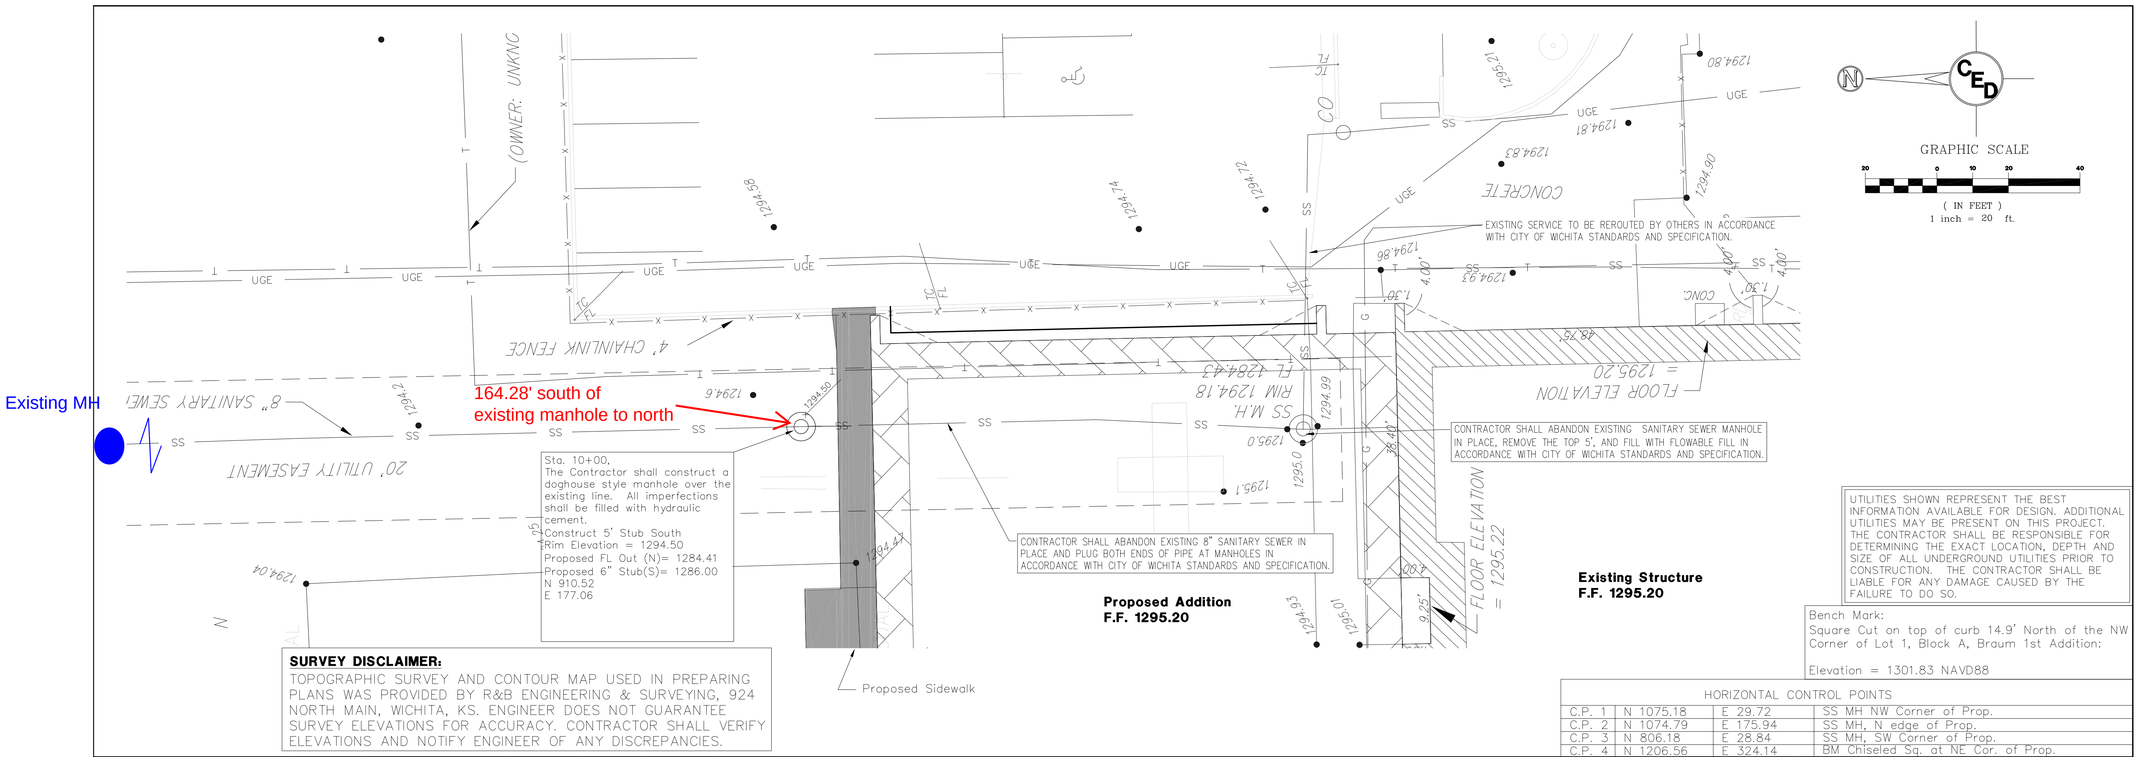

SURVEY DISCLAIMER:

TOPOGRAPHIC SURVEY AND CONTOUR MAP USED IN PREPARING PLANS WAS PROVIDED BY R&B ENGINEERING & SURVEYING, 924 NORTH MAIN, WICHITA, KS. ENGINEER DOES NOT GUARANTEE SURVEY ELEVATIONS FOR ACCURACY. CONTRACTOR SHALL VERIFY ELEVATIONS AND NOTIFY ENGINEER OF ANY DISCREPANCIES.

UTILITIES SHOWN REPRESENT THE BEST INFORMATION AVAILABLE FOR DESIGN. ADDITIONAL UTILITIES MAY BE PRESENT ON THIS PROJECT. THE CONTRACTOR SHALL BE RESPONSIBLE FOR DETERMINING THE EXACT LOCATION, DEPTH AND SIZE OF ALL UNDERGROUND UTILITIES PRIOR TO CONSTRUCTION. THE CONTRACTOR SHALL BE LIABLE FOR ANY DAMAGE CAUSED BY THE FAILURE TO DO SO.

Bench Mark:
Square Cut on top of curb 14.9' North of the NW Corner of Lot 1, Block A, Braum 1st Addition:

Elevation = 1301.83 NAVD88

HORIZONTAL CONTROL POINTS			
C.P. 1	N 1075.18	E 29.72	SS MH NW Corner of Prop.
C.P. 2	N 1074.79	E 175.94	SS MH, N edge of Prop.
C.P. 3	N 806.18	E 28.84	SS MH, SW Corner of Prop.
C.P. 4	N 1206.56	E 324.14	BM Chiseled Sq. at NE Cor. of Prop.

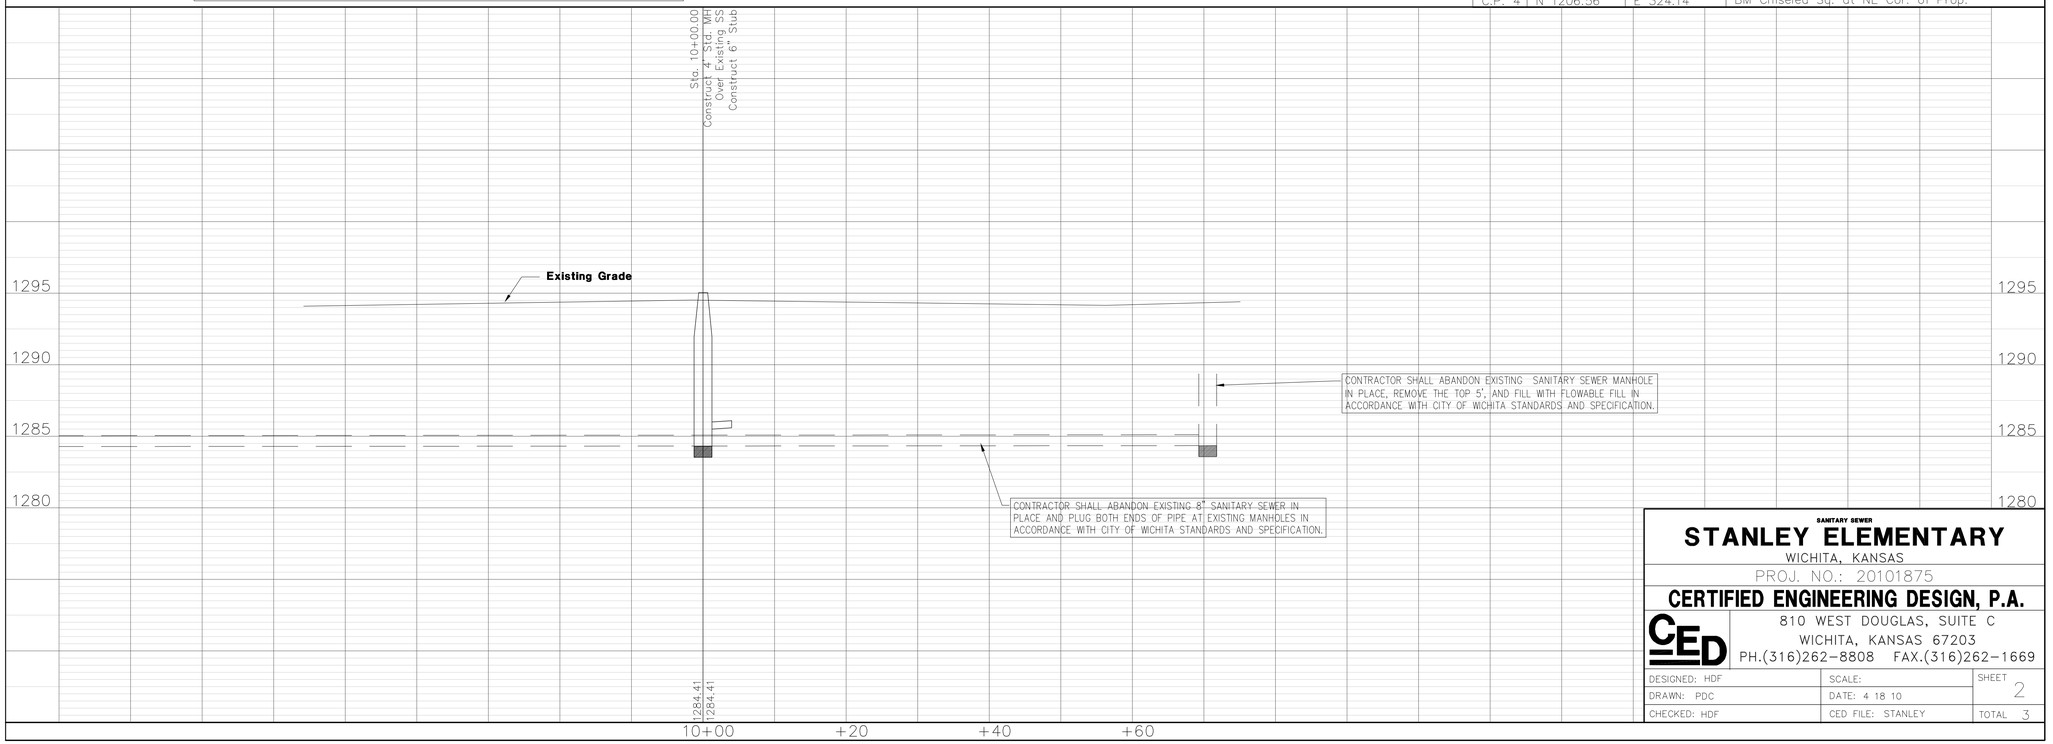

SANITARY SEWER

STANLEY ELEMENTARY

WICHITA, KANSAS

PROJ. NO.: 20101875

CERTIFIED ENGINEERING DESIGN, P.A.

CED

810 WEST DOUGLAS, SUITE C
WICHITA, KANSAS 67203
PH.(316)262-8808 FAX.(316)262-1669

DESIGNED: HDF	SCALE:	SHEET 2
DRAWN: PDC	DATE: 4 18 10	
CHECKED: HDF	CED FILE: STANLEY	TOTAL 3