



NOTE: PLACE WATERPROOFING WHERE GRADES ABUT BUILDING ABOVE FINISHED FLOOR ELEVATION. REF ARCH

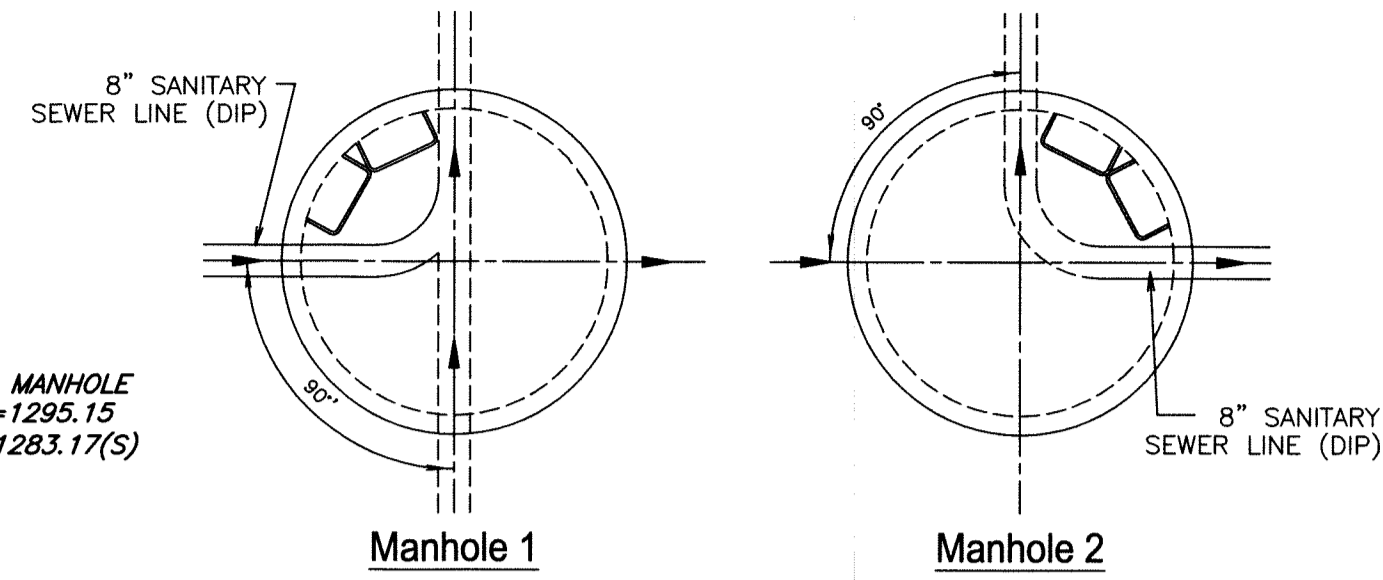

Direction of Flow was field verified by Schwab-Eaton Surveyors.

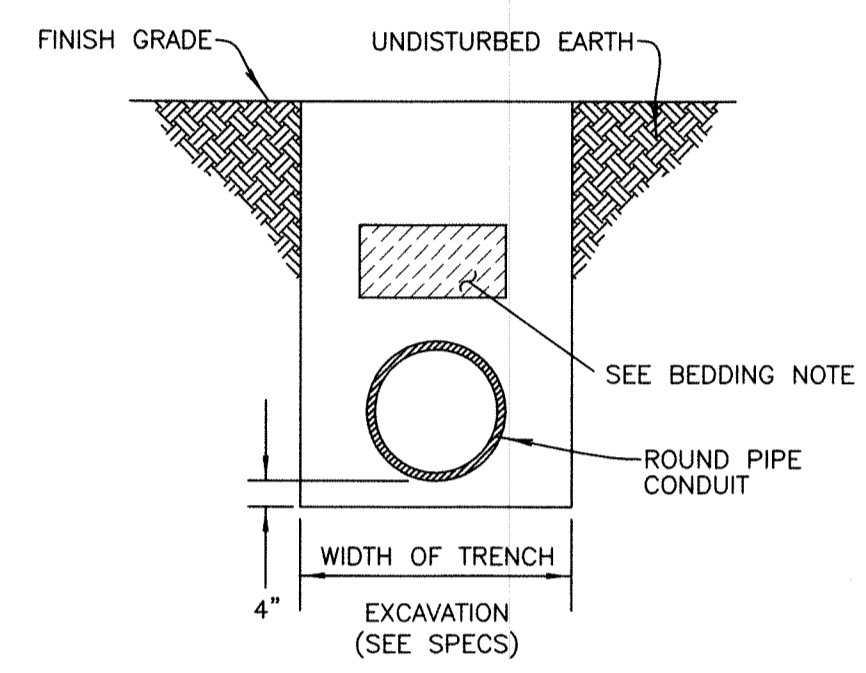

Pipe Bedding Detail For Sanitary Sewer
NOT TO SCALE

BEDDING NOTE:
STANDARD BEDDING MATERIAL MUST BE TYPE "A" AGGREGATE BASE UNDER PAVING TYPE "A" AGGREGATE BASE TO BE COMPACTED TO 95% STD. PROCTOR DENSITY.
INITIAL BEDDING AND TRENCH EXCAVATION WIDTHS SHALL BE AS PER CITY OF WICHITA PUBLIC WORKS DEPARTMENT STANDARDS AND SPECIFICATIONS.

QuikTrip
4705 South 129th East Ave.
Tulsa, OK 74134-7008
P.O. Box 3475
Tulsa, OK 74101-3475
(918) 615-7700


- GENERAL NOTES**
1. ALL CONSTRUCTION TO BE IN STRICT ACCORDANCE WITH CURRENT CITY OF WICHITA, PUBLIC WORKS DEPARTMENT STANDARDS AND SPECIFICATIONS.
 2. CONTRACTOR WILL BE REQUIRED TO VACUUM TEST ALL MANHOLES ACCORDING TO CITY OF WICHITA, PUBLIC WORKS DEPARTMENT STANDARDS AND SPECIFICATIONS.
 3. CONTRACTOR TO VERIFY UTILITY LOCATIONS BEFORE EXCAVATING.
 4. ALL GRADES TO BE BASED ON U.S.G.S. VERTICAL DATUM.
 5. ALL PIPE SHALL BE CONSTRUCTED OF MATERIAL AS SHOWN ON THE PROFILES.
 6. IN-LINE SERVICE TEES SHALL BE OF THE SAME MATERIAL AS PIPE INSTALLED. OUTLET CONNECTIONS TO IN-LINE TEES SHALL BE SCHEDULE 40 PVC.
 7. QUIKTRIP OR THEIR DESIGNATED INSPECTION FIRM, SHALL PERFORM ALL INSPECTION AND TESTING SERVICES (INCLUDING TELEVISION AND AIR TESTING OF SEWERS) AND SHALL DOCUMENT AND PROVIDE THE CITY SATISFACTORY DOCUMENTATION OF ALL SUCH ACTIVITIES.
 8. ALL SERVICE TEES ARE STATIONED FROM THE IMMEDIATE DOWNSTREAM MANHOLE.
 9. SHEETING, SHORING, DEWATERING, ETC. SHALL BE THE RESPONSIBILITY OF THE CONTRACTOR (ALL COSTS INCLUDED IN OTHER ITEMS OF WORK).

© COPYRIGHT
1986 QUIKTRIP CORPORATION
DESIGN PATENTS

QUIKTRIP PLANS ARE THE EXCLUSIVE PROPERTY OF QUIKTRIP CORPORATION, TULSA, OKLAHOMA. THESE PLANS ARE PROTECTED IN THEIR ENTIRETY BY DOMESTIC AND INTERNATIONAL COPYRIGHT AND PATENT STATUTES. ANY UNAUTHORIZED USE, REPRODUCTION, PUBLICATION, DISTRIBUTION OR SALE IN WHOLE OR IN PART, IS STRICTLY FORBIDDEN.





No.	Revision	Date

HRAOK, Inc.
ENGINEERS-SURVEYORS-PLANNERS-LANDSCAPE ARCHITECTS
OKLAHOMA: CA# 3643-EXP. DATE: 6-30-2011
KANSAS: CN# 1600-EXP. DATE: 12-31-2010
1913 WEST TACOMA - SUITE A VOICE: (918) 268-3737
BROKEN ARROW, OKLAHOMA 74012 FAX: (918) 268-2554
WWW.HRAOK.COM INFO@HRAOK.COM

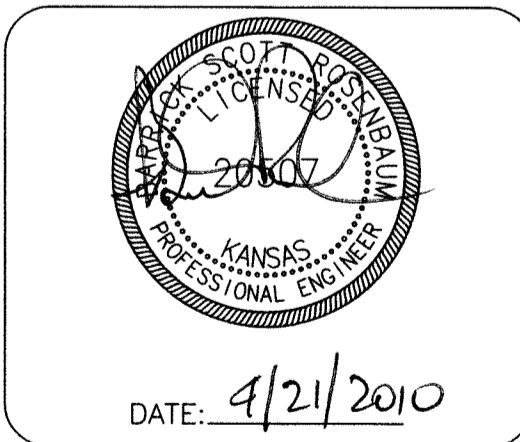

SANITARY SEWER PLAN AND PROFILE

DRAWN BY: TSM/BLJ	SHEET
DESIGNED BY: BLJ	3
CHECKED BY: BSR	
ISSUE DATE: 8/3/09	OF 14

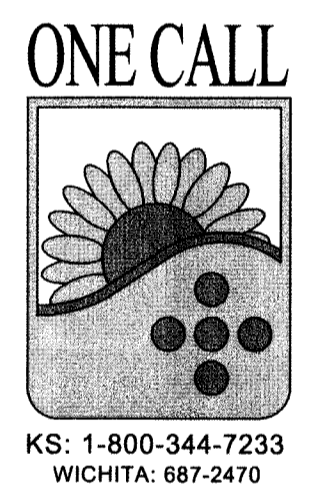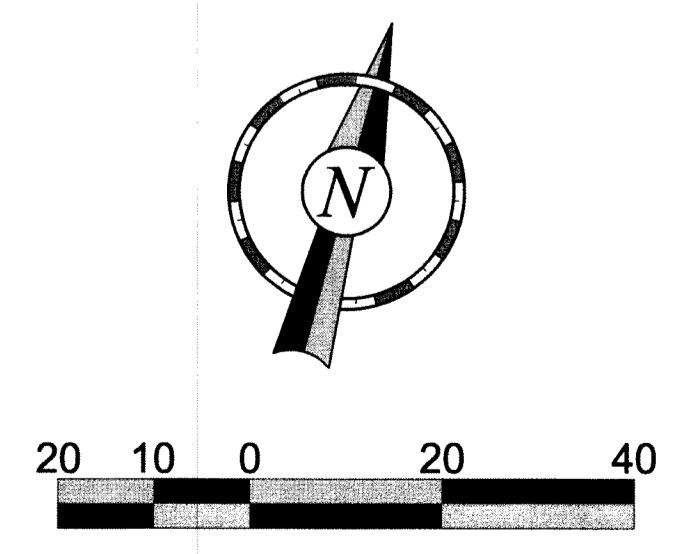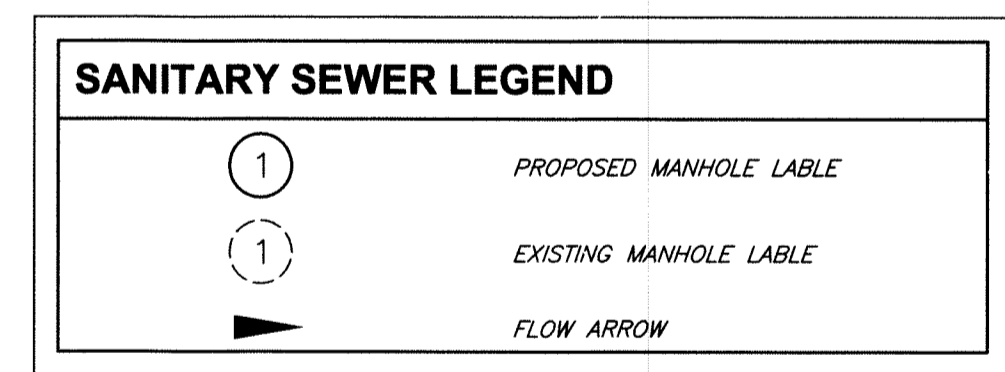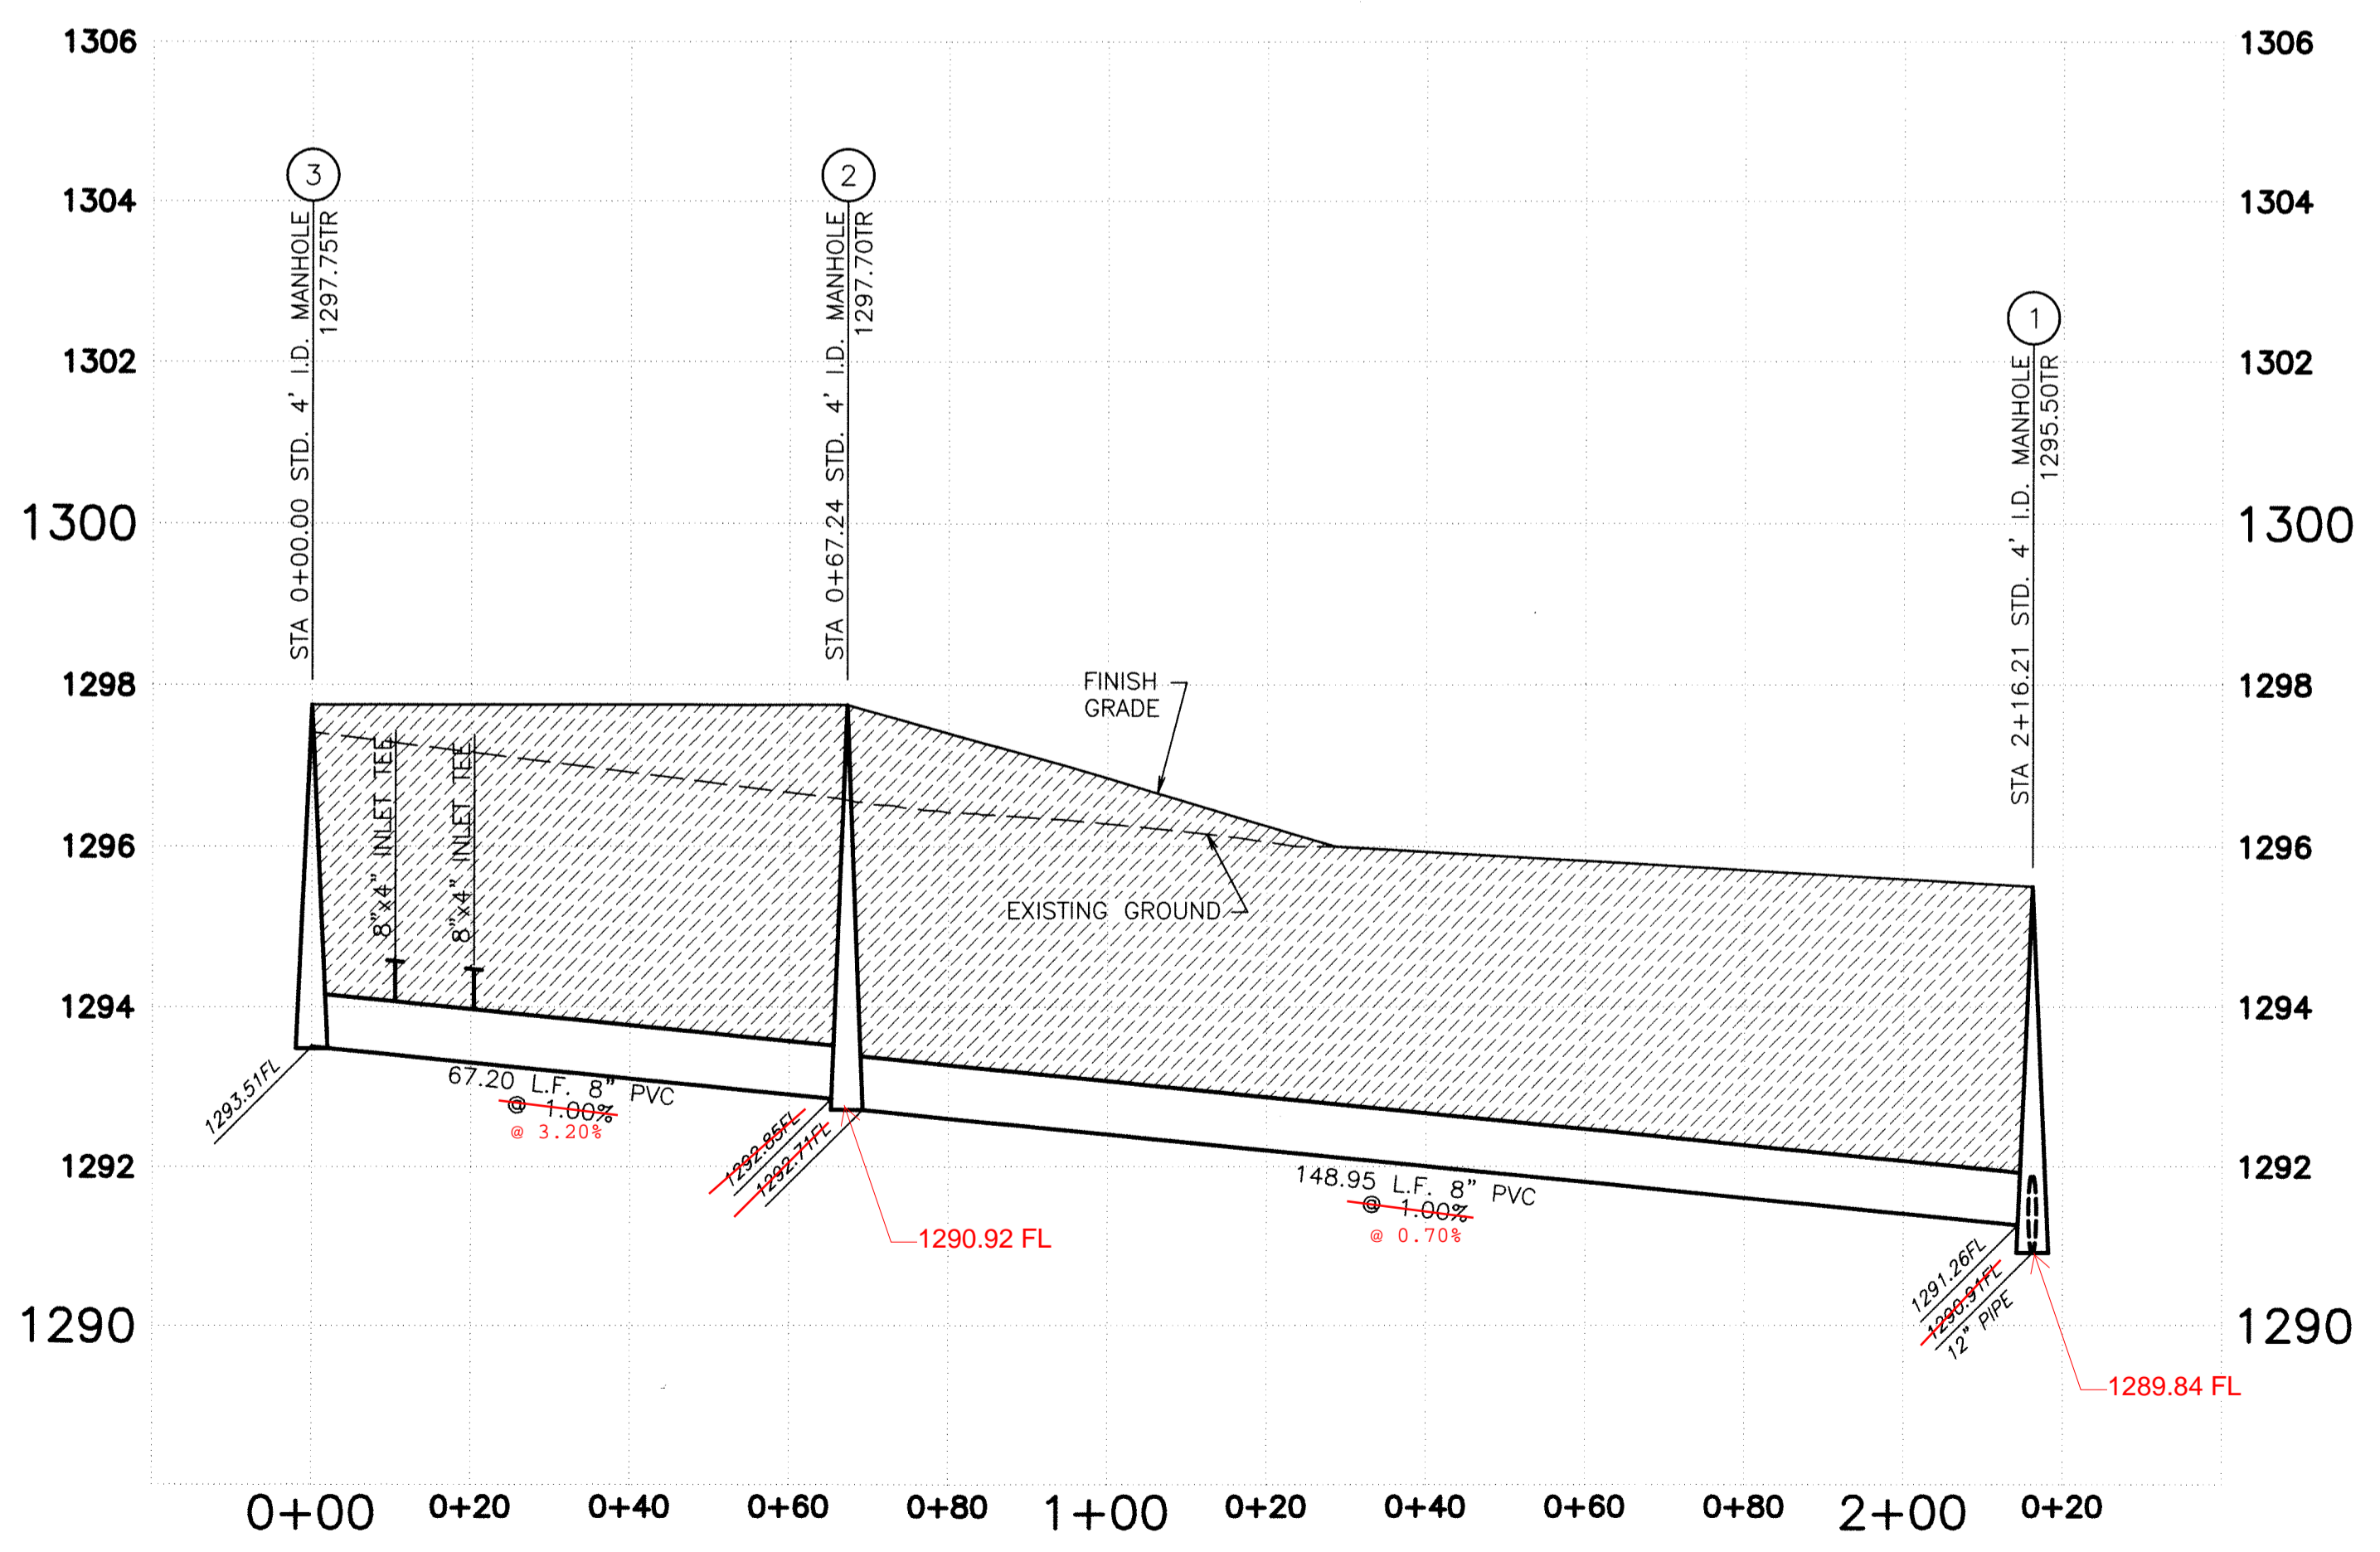

DENOTES AREAS TO BE TYPE "A" AGGREGATE COMPACTED TO 95% STANDARD PROCTOR DENSITY.

C:\TEMP\TEMP\AcPublish_2516\386R Base.dwg — IIFC — Sanitary — Apr 21, 2010 — 2:52pm — Bobby

WICHITA, KANSAS
1010 E. DOUGLAS AVE.
QuikTrip Store No. : 386R