


LINE 1

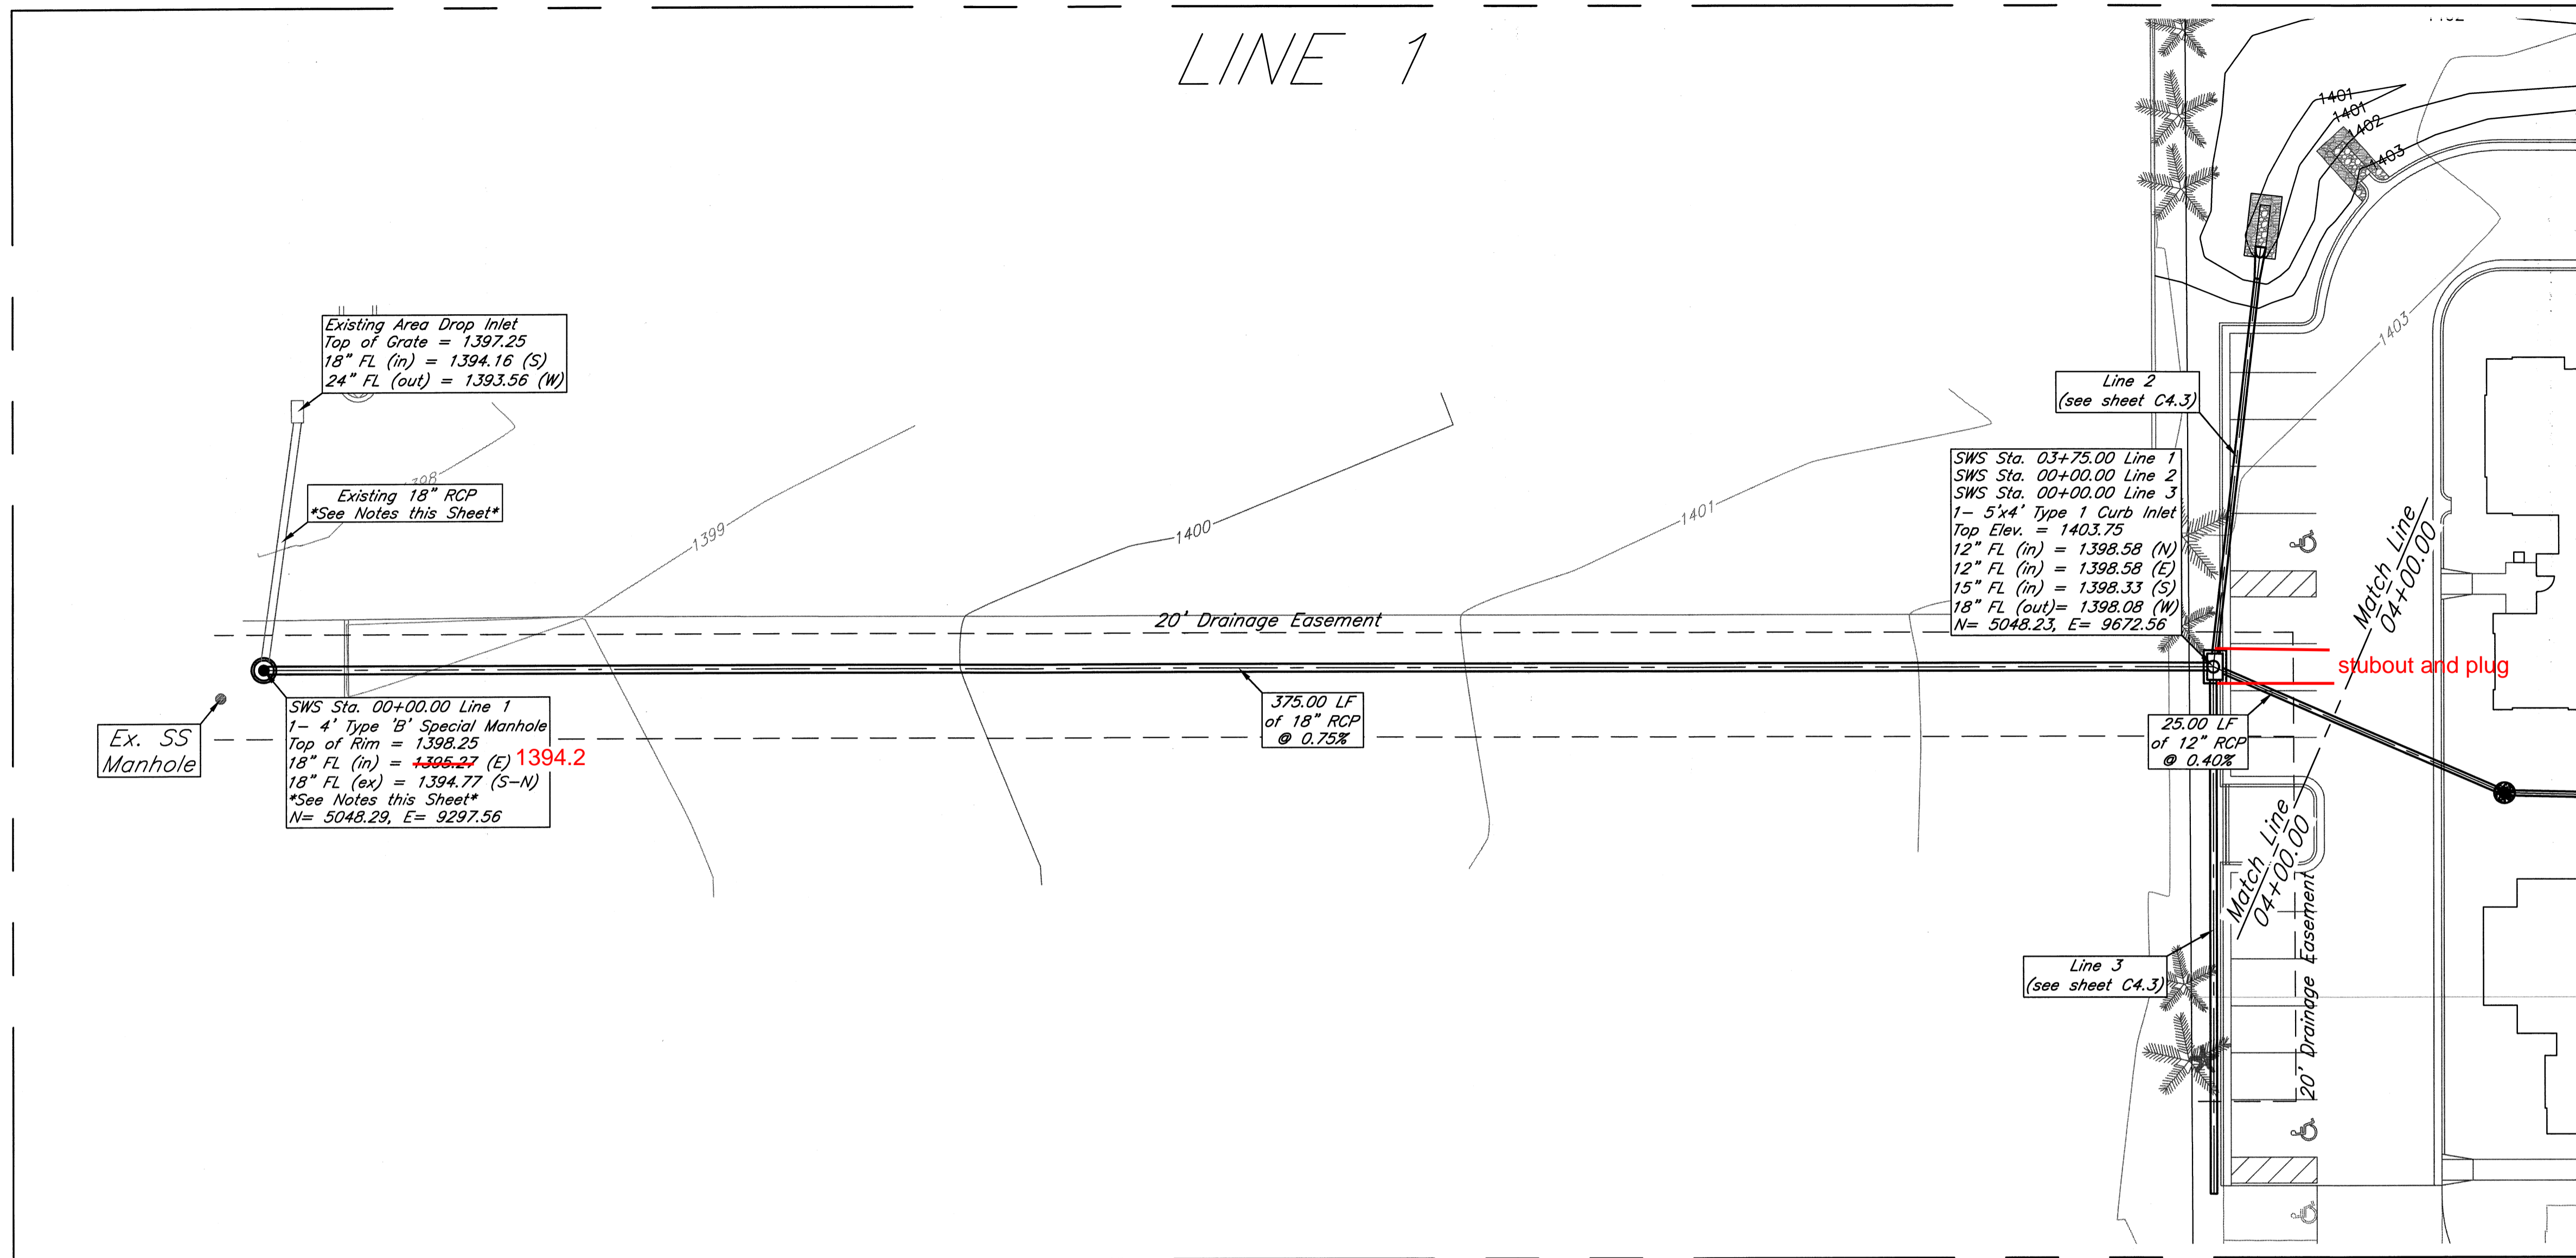

Notes:

- Contractor to field verify flowline and location of existing 18" RCP at station 00+00.00 Line 1. If location differs from shown on plan or if flowline is greater than 0.4' difference from shown on plan, contractor shall contact engineer and determine in field an acceptable solution.



DATE DRAWN
01-05-2010
REVISIONS

PRINTS ISSUED
CITY PERMIT 12-08-09

KREHBIEL
ARCHITECTURE

1300 E. Lewis
Wichita KS 67211
316.267.8233
316.267.8566 fax
krehbielarchitect
ure.com

DATE

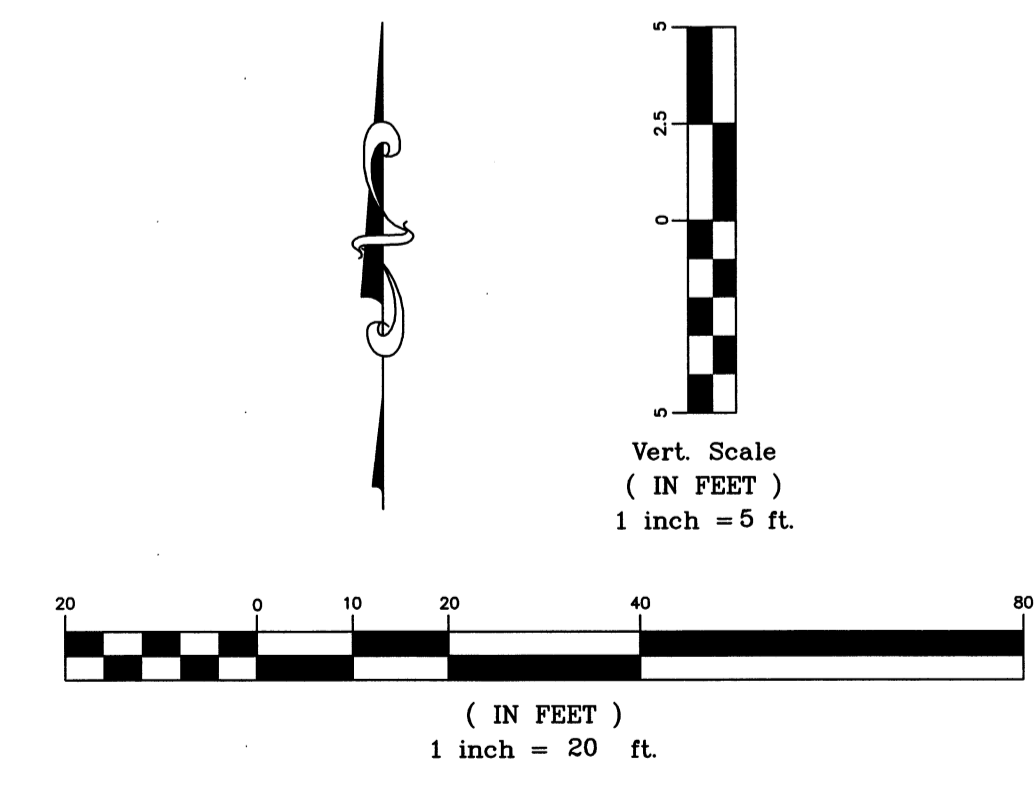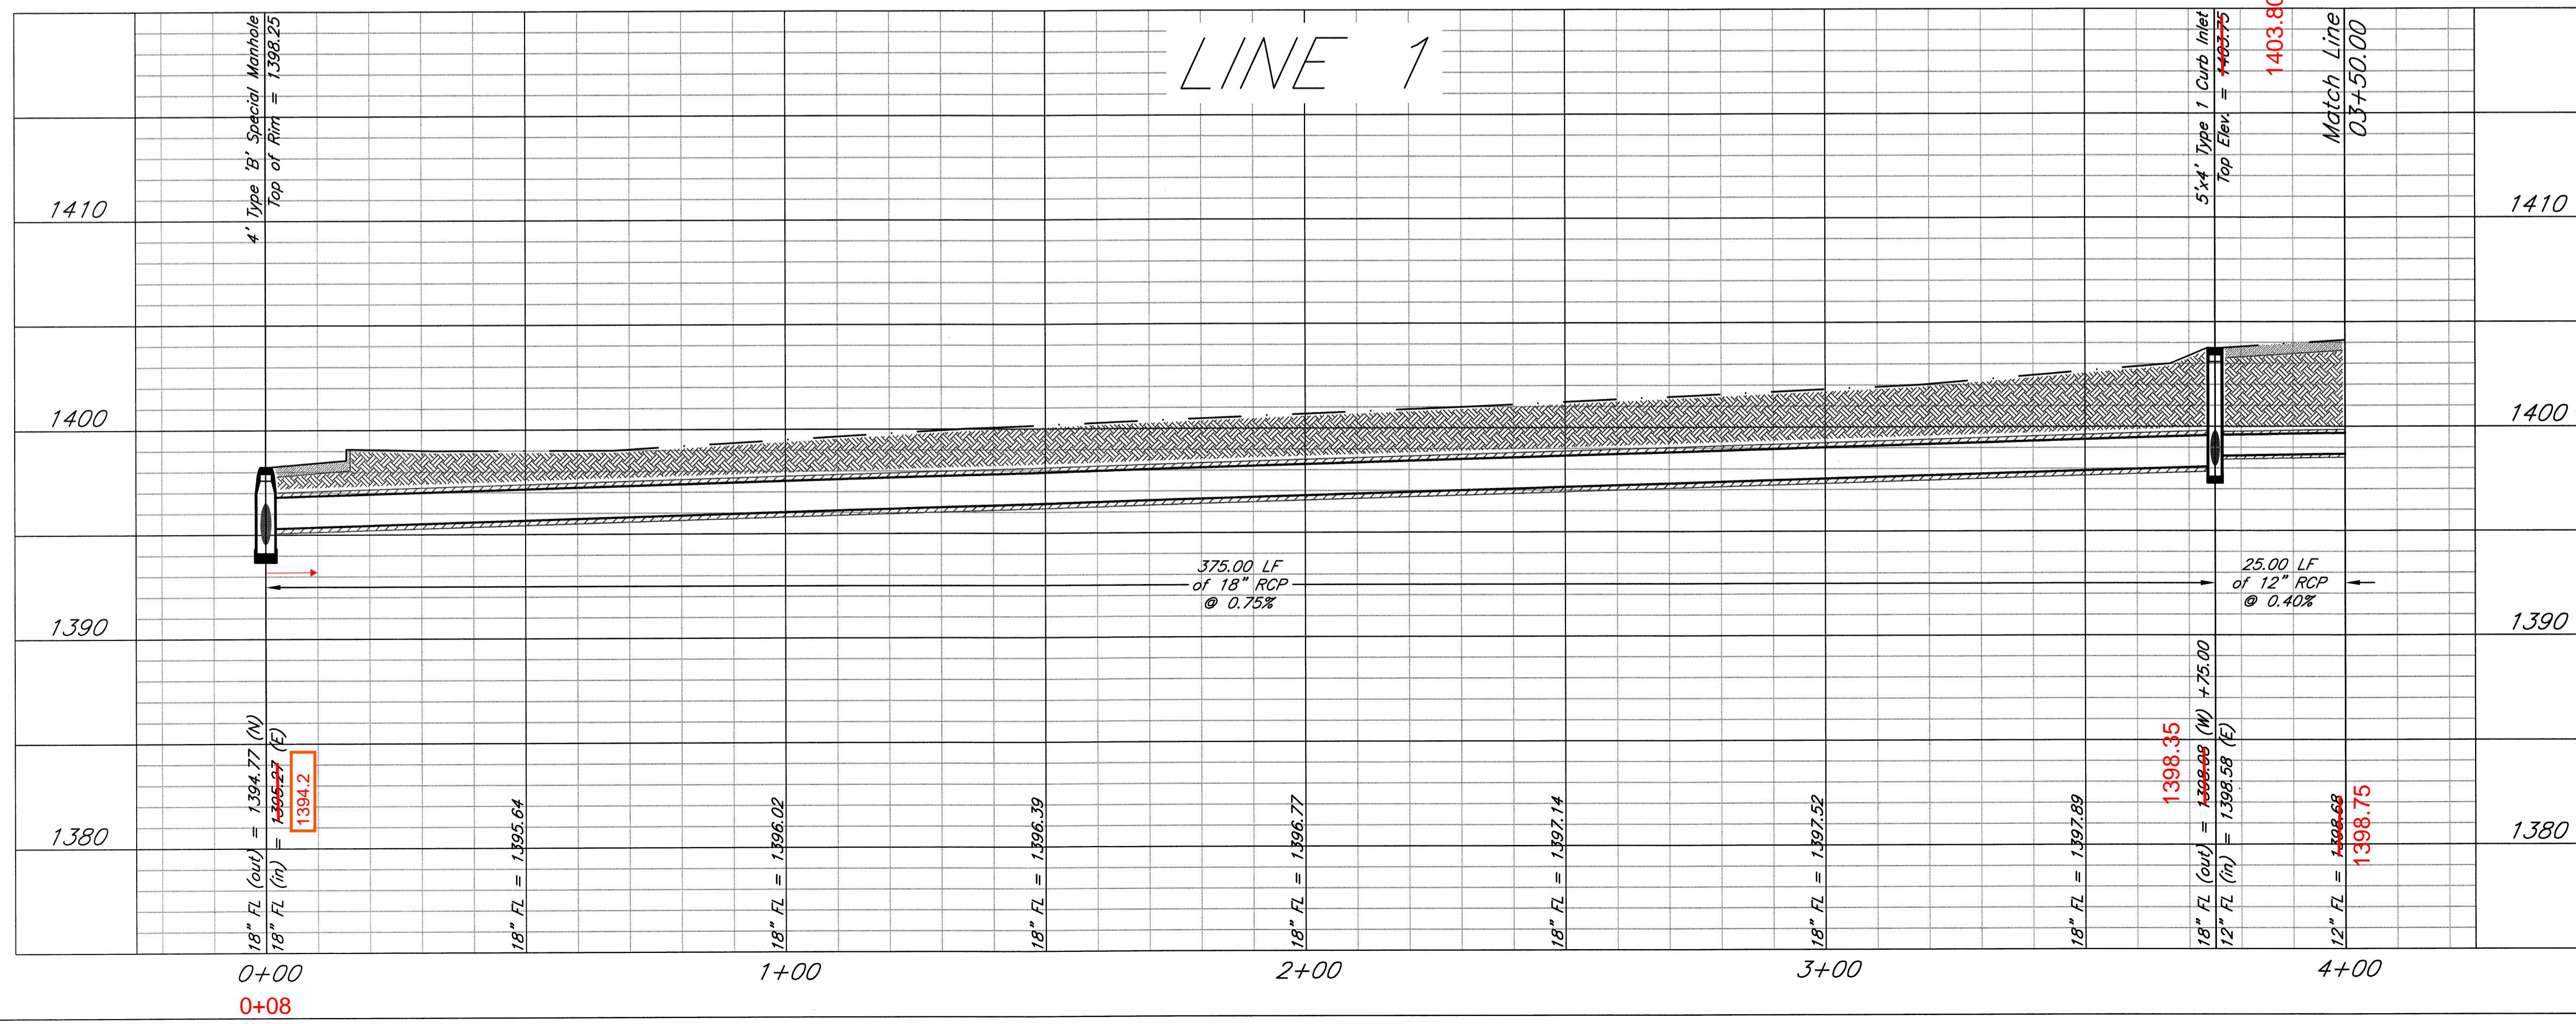

kemiller
engineering

516 S. Market,
Wichita, KS 67202 (316)264-0242

BETHEL HOUSE
RESIDENT ACTIVITY CENTER
2121 N. BROADMOOR
WICHITA, KANSAS

PROJECT NO.
9048
SHEET TITLE
Plan & Profile (line 1)

SHEET NO.
C4.2