


PLAN	CHECKED	DATE
	CHECKED	


PROFILE	CHECKED	DATE
	CHECKED	

Saved: 09-01-2008 08:45:20 AM  
 Plot Scale: 1"=40'  
 G:\2008\08389\001\08389-01-C-SSPP02

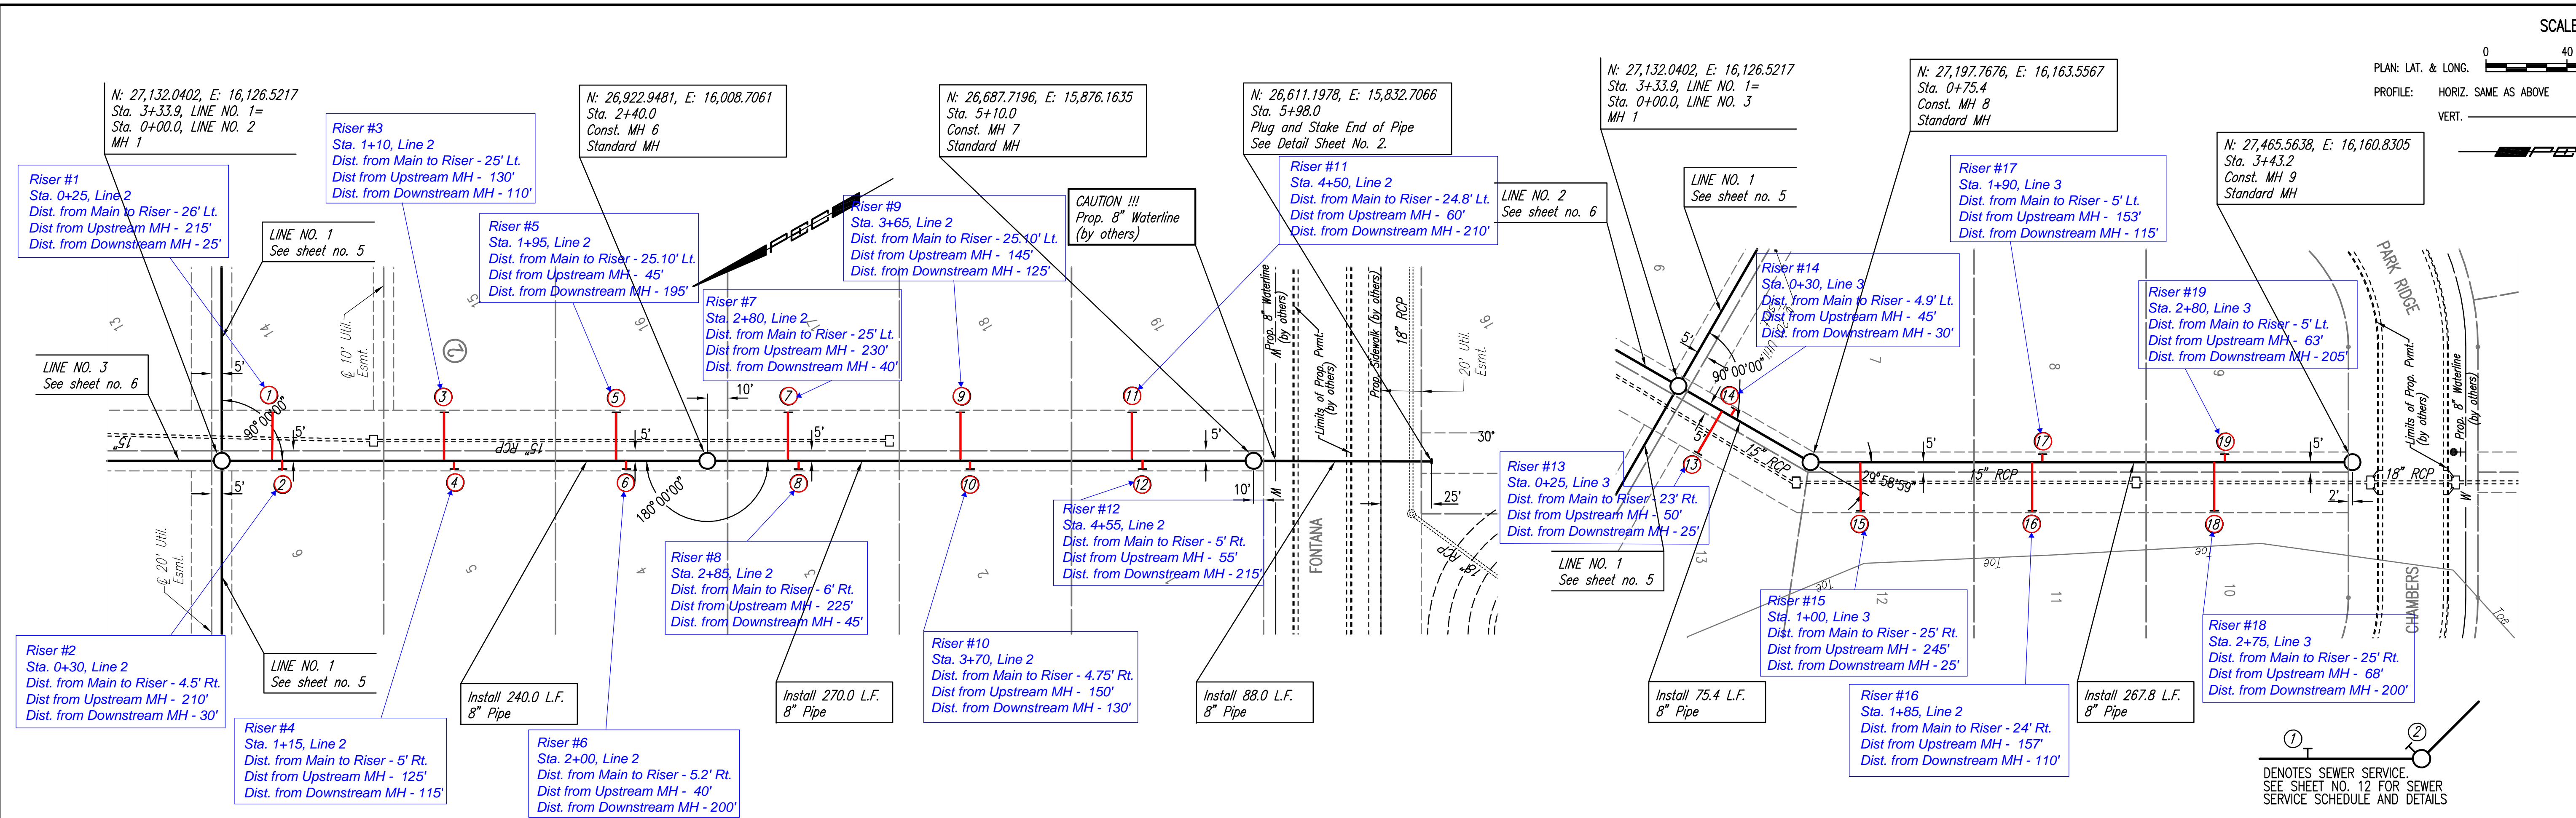

SANITARY SEWER LINE NO. 2

SANITARY SEWER LINE NO. 3

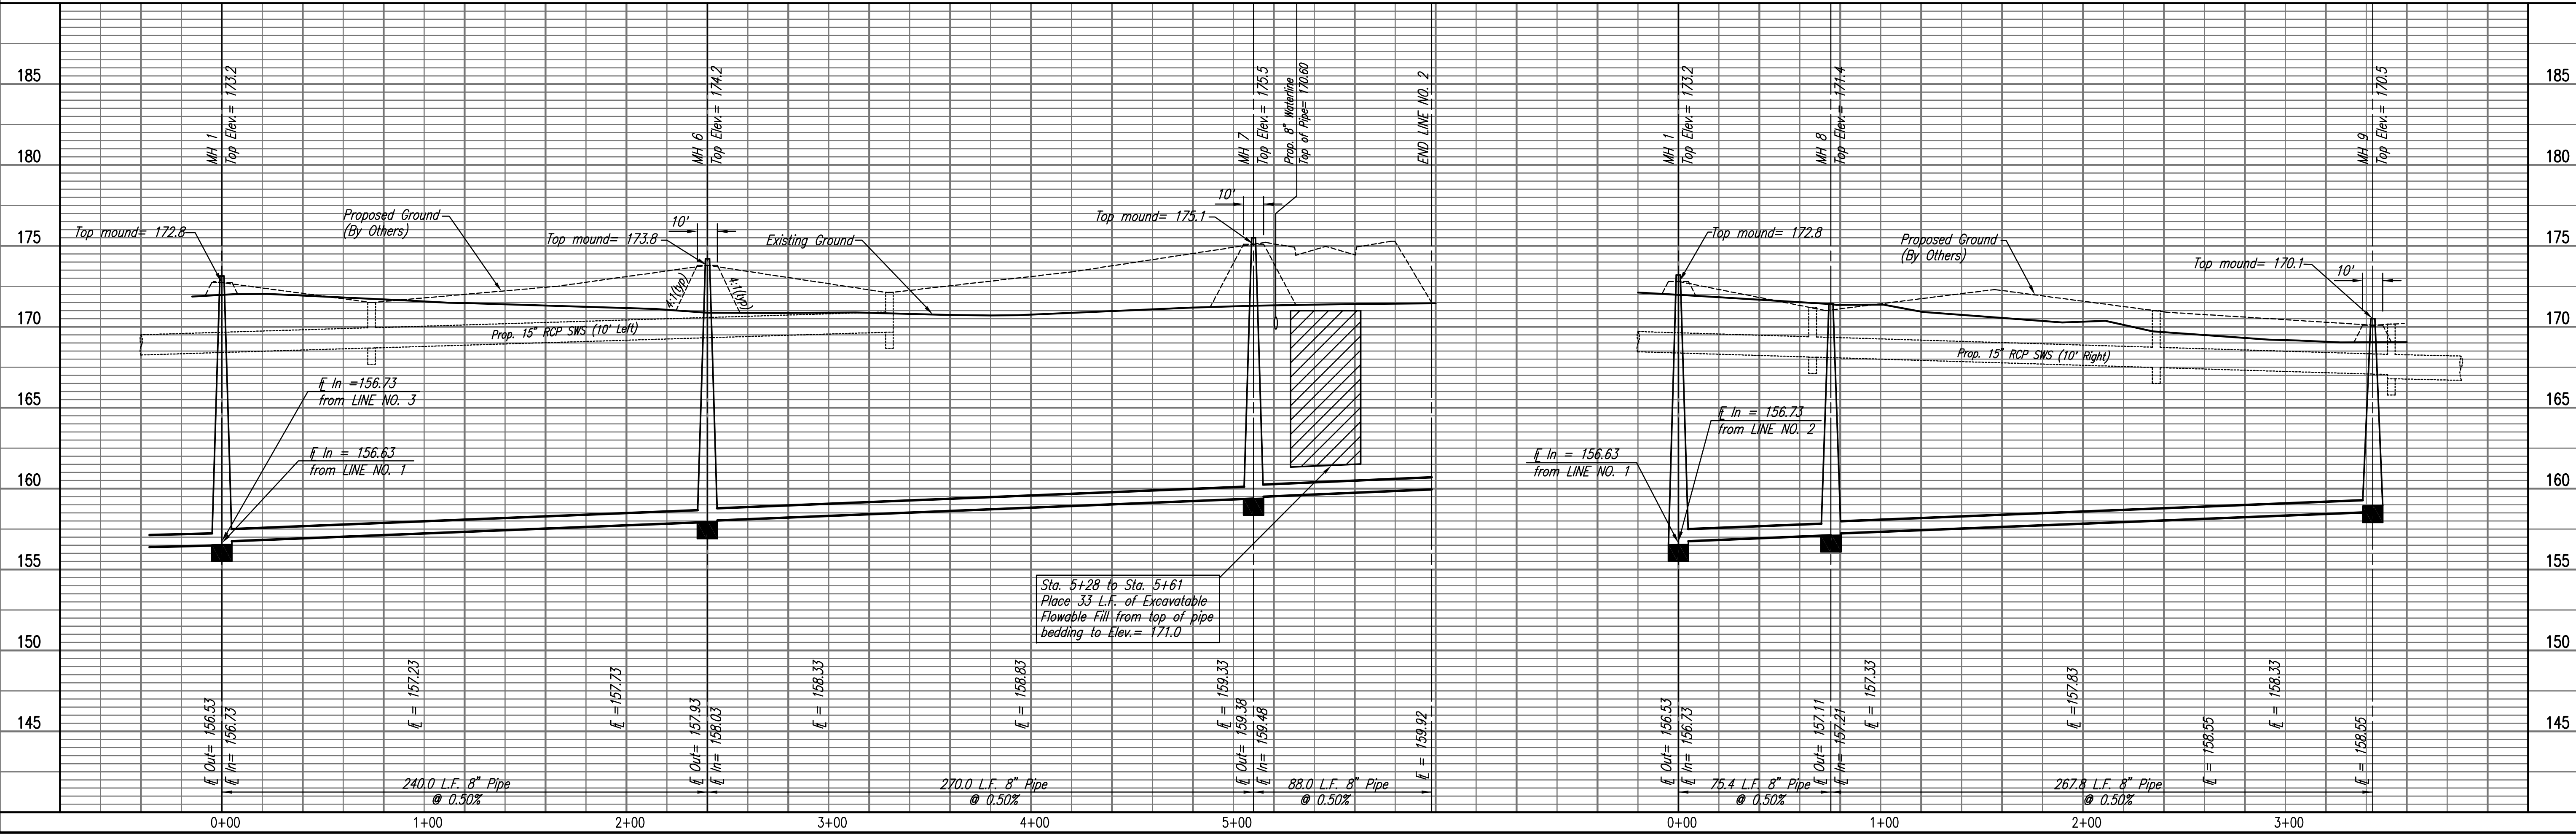

**Professional Engineering Consultants, P.A.**  
 316-262-2691 • FAX 316-262-3003

Job No. 35-08389-001-042  
 Date July 2008

Designed by MDK  
 Drawn by TLS

**LATERAL 16, MAIN 7 OF THE NORTHWEST INTERCEPTOR SEWER**  
**SANITARY SEWER LINE NO. 2 AND 3**

JAMES L. ARMOUR, P.E. - CITY ENGINEER  
 CITY OF WICHITA PROJECT NO. 468-84584

Sheet 7 of 18