



**LATERAL 1, MAIN 6A, NW1**  
**STONEBRIDGE ADDITION**  
**WICHITA, KANSAS**

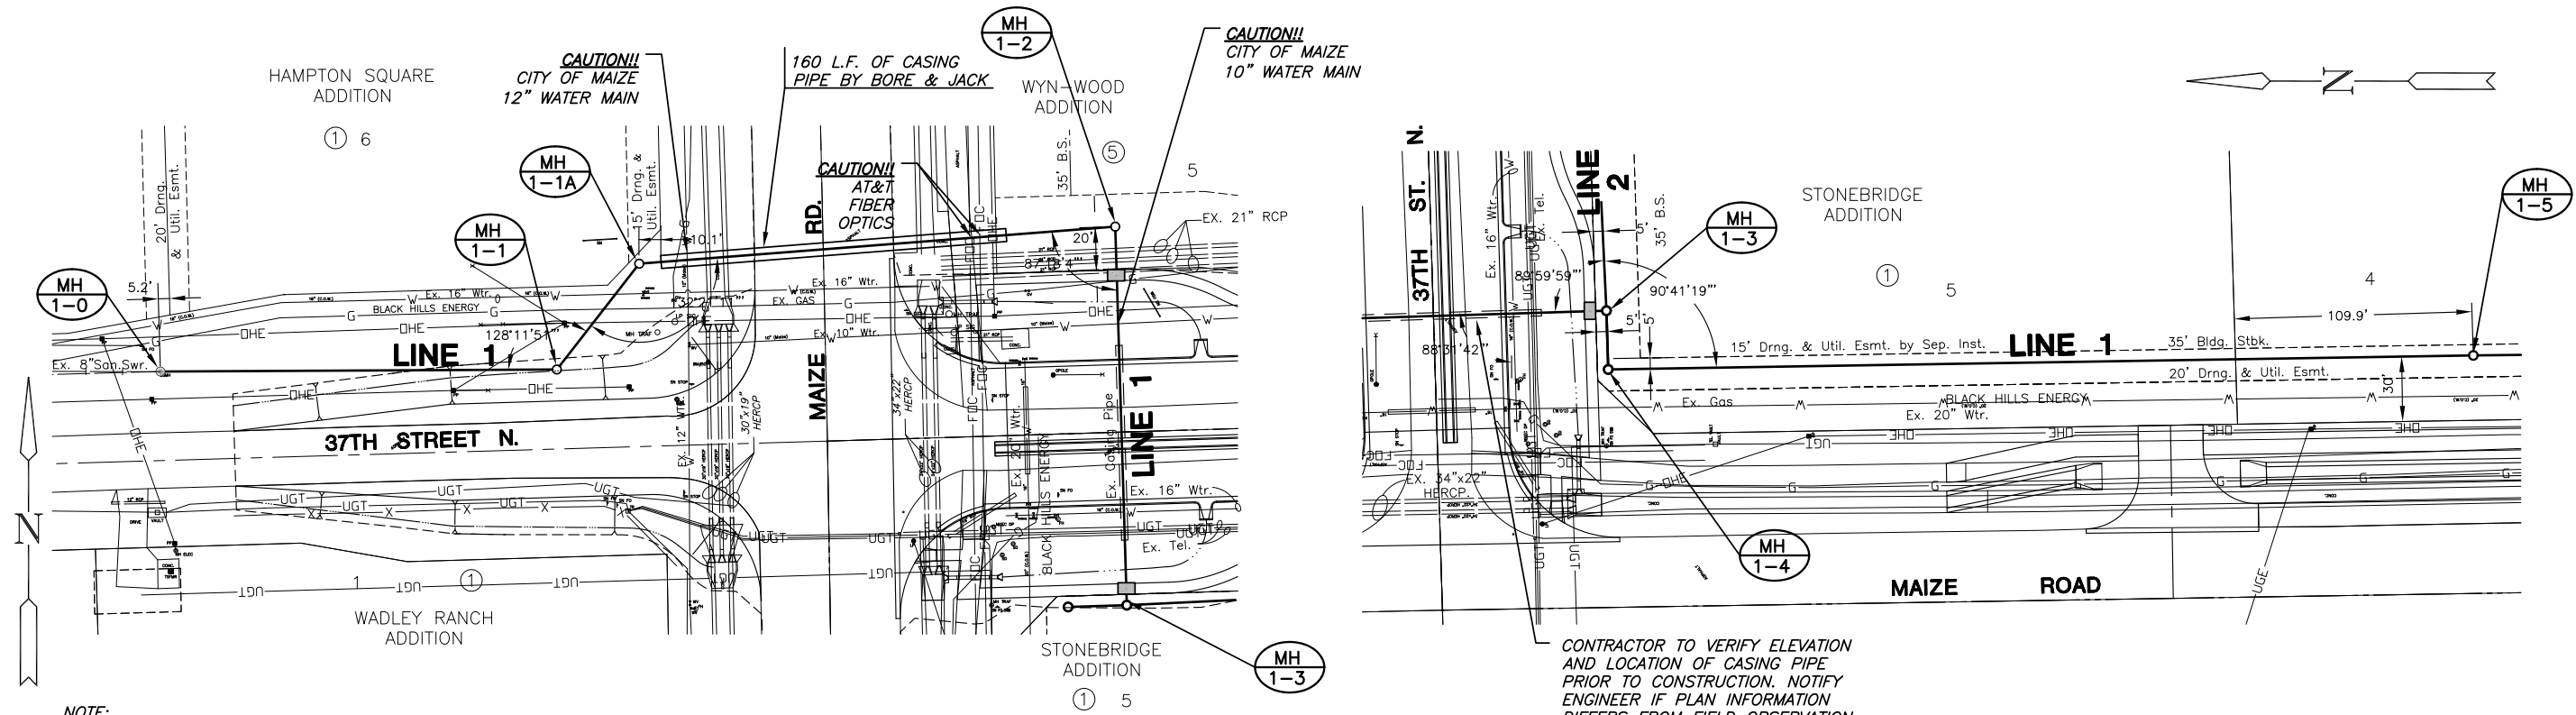

**PLAN LINE 1**

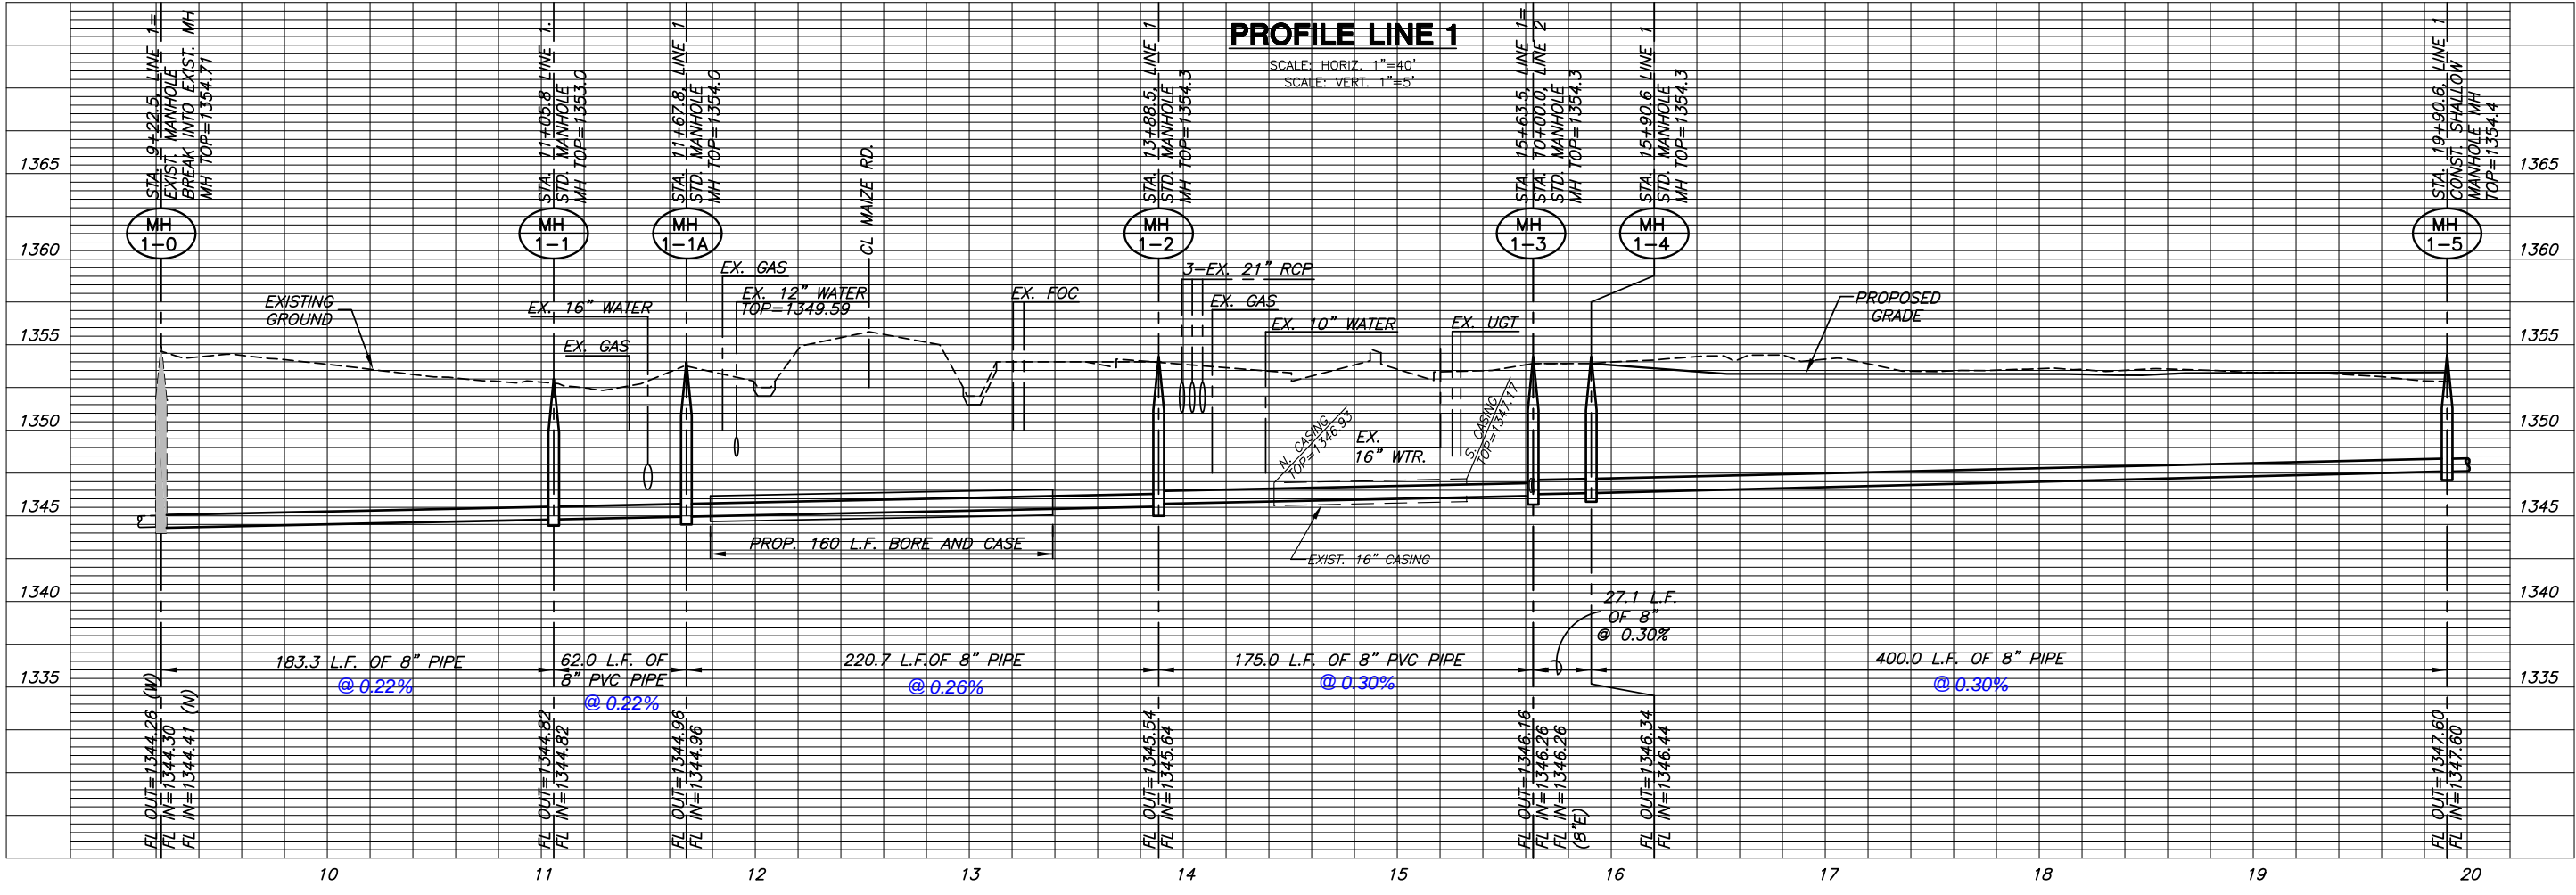

**LINE 1**  
SHEET TITLE  
468-84571  
PROJECT NUMBER

DFL  
DESIGN BY  
DM  
DRAWN BY  
GJA  
CHECKED BY

ISSUED  
April 2010  
REVISED

SHEET NO.  
4 of 13