


NOTE:  
CONTRACTOR TO VERIFY  
LOCATION AND ELEVATION OF  
EXISTING UTILITIES PRIOR TO  
CONSTRUCTION.

TREE REMOVAL

**PLAN LINE 1**

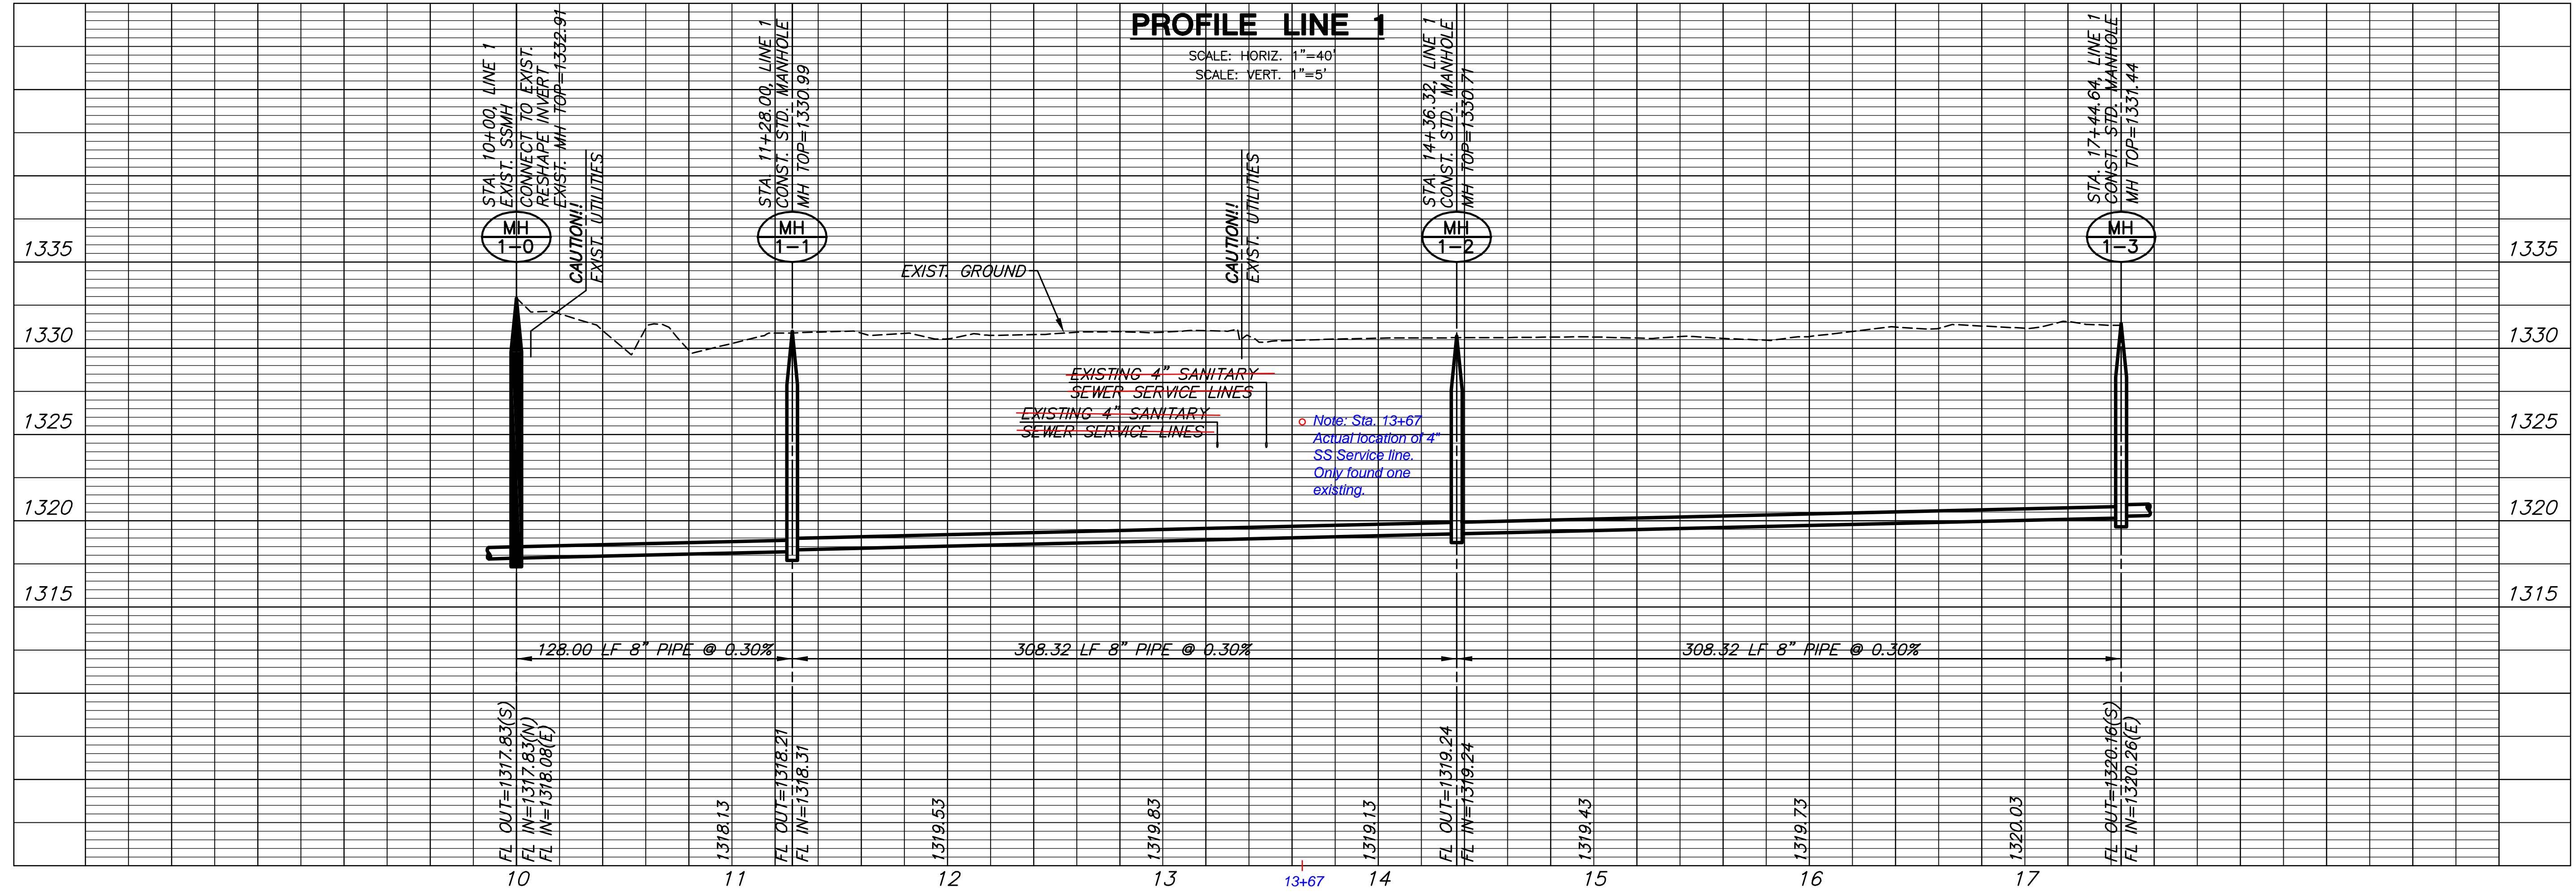

**PROFILE LINE 1**

SCALE: HORIZ. 1" = 40'  
SCALE: VERT. 1" = 5'

**LINE 1**  
SHEET TITLE  
PROJECT NUMBER  
07428

DESIGN BY  
DRAWN BY  
CHECKED BY  
JS  
JWC  
MAB

ISSUED  
REVISD  
June 2009

SHEET NO.  
5 of 14