



PROPOSED KELLOGG EXPANSION
TREE REMOVAL

CAUTION!!
IN CLOSE PROXIMITY TO GAS, UNDERGROUND
ELECTRIC, AND UNDERGROUND TELEPHONE LINES.

PLAN LINE 1

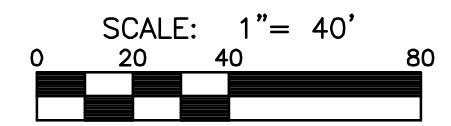

NOTE:
CONTRACTOR TO VERIFY
LOCATION AND ELEVATION OF
EXISTING UTILITIES PRIOR TO
CONSTRUCTION.

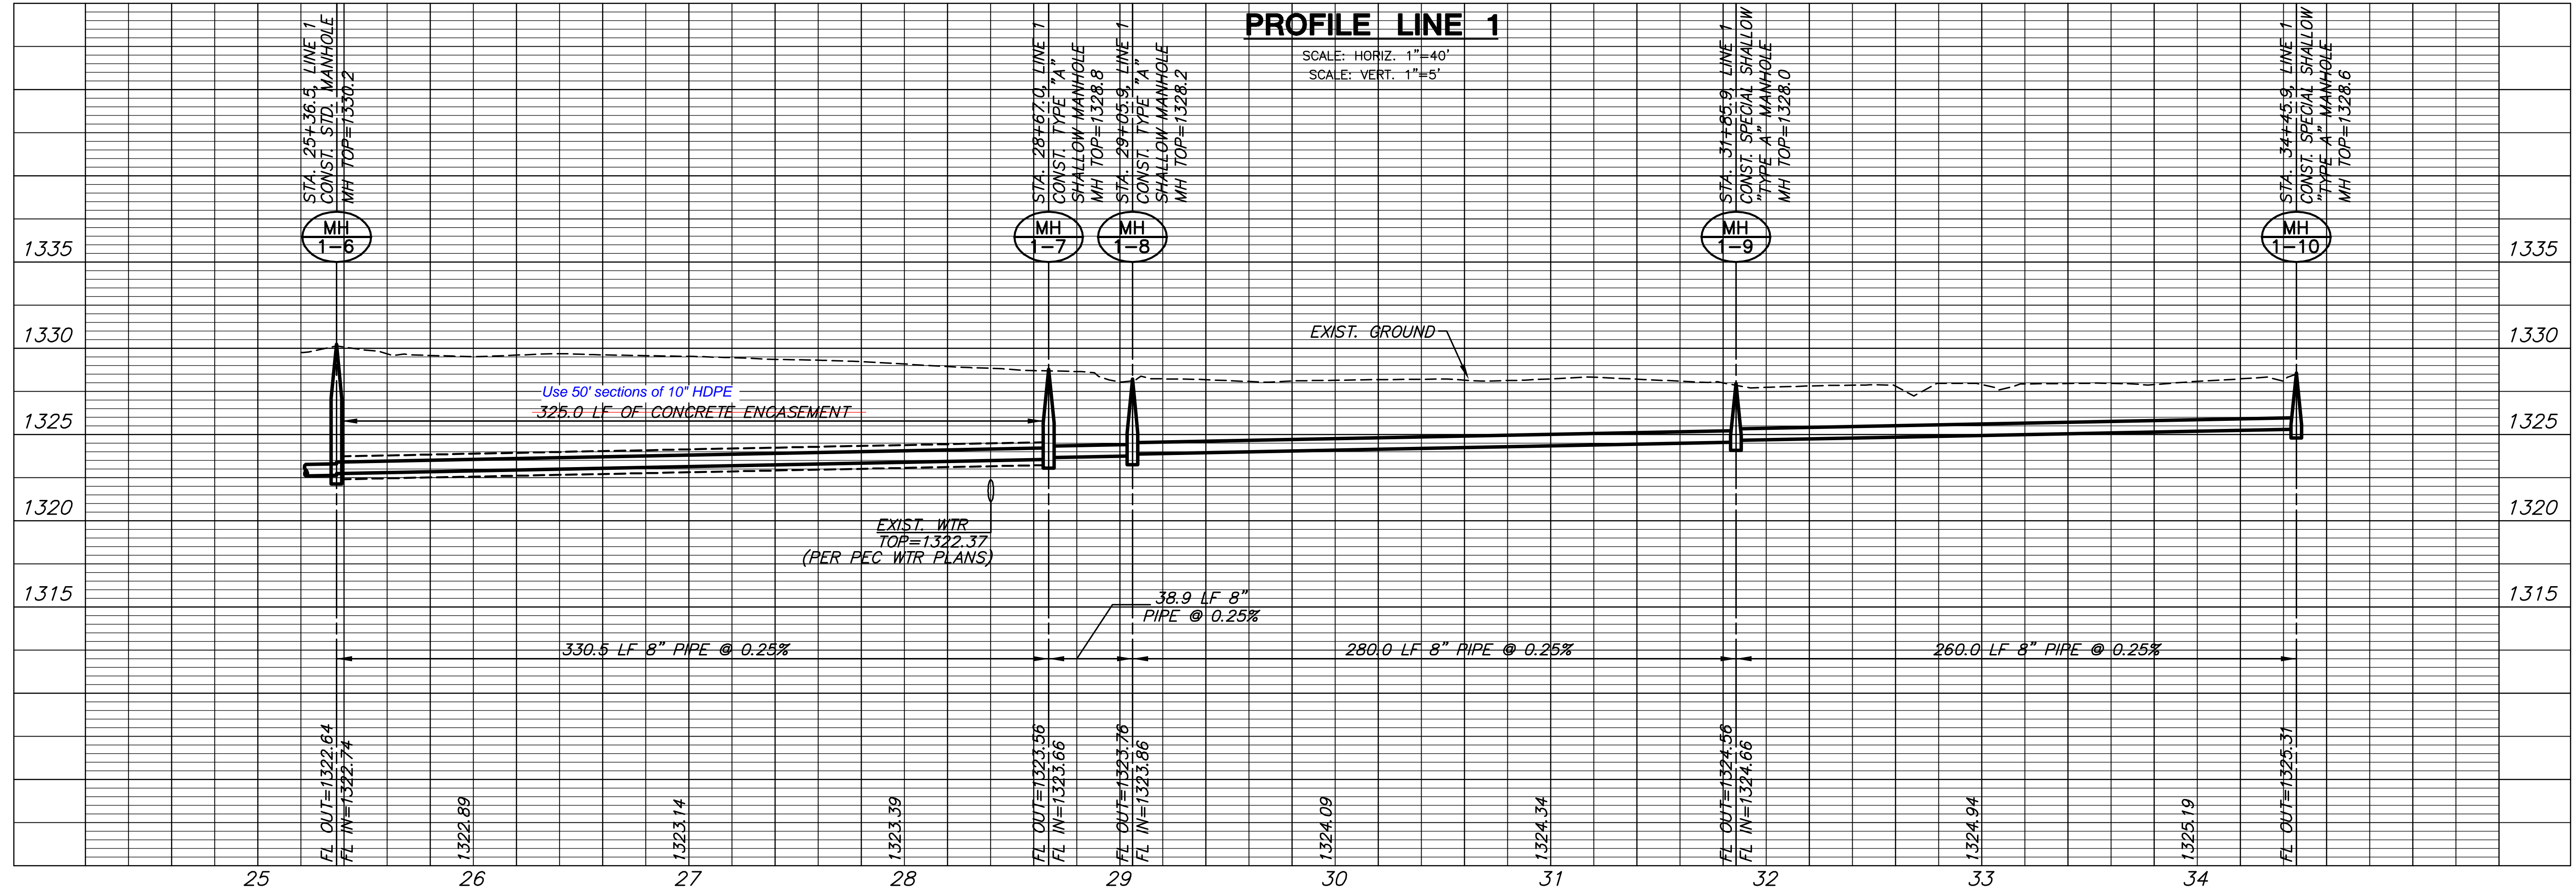

PROFILE LINE 1

SCALE: HORIZ. 1"=40'
SCALE: VERT. 1"=5'

LINE 1
SHEET TITLE
07428
PROJECT NUMBER

DESIGN BY: JS
DRAWN BY: JWC
CHECKED BY: MAB

ISSUED: June 2009
REVISED:

SHEET NO.
7 of 14