


PLAN LINE 2

☒ TREE REMOVAL

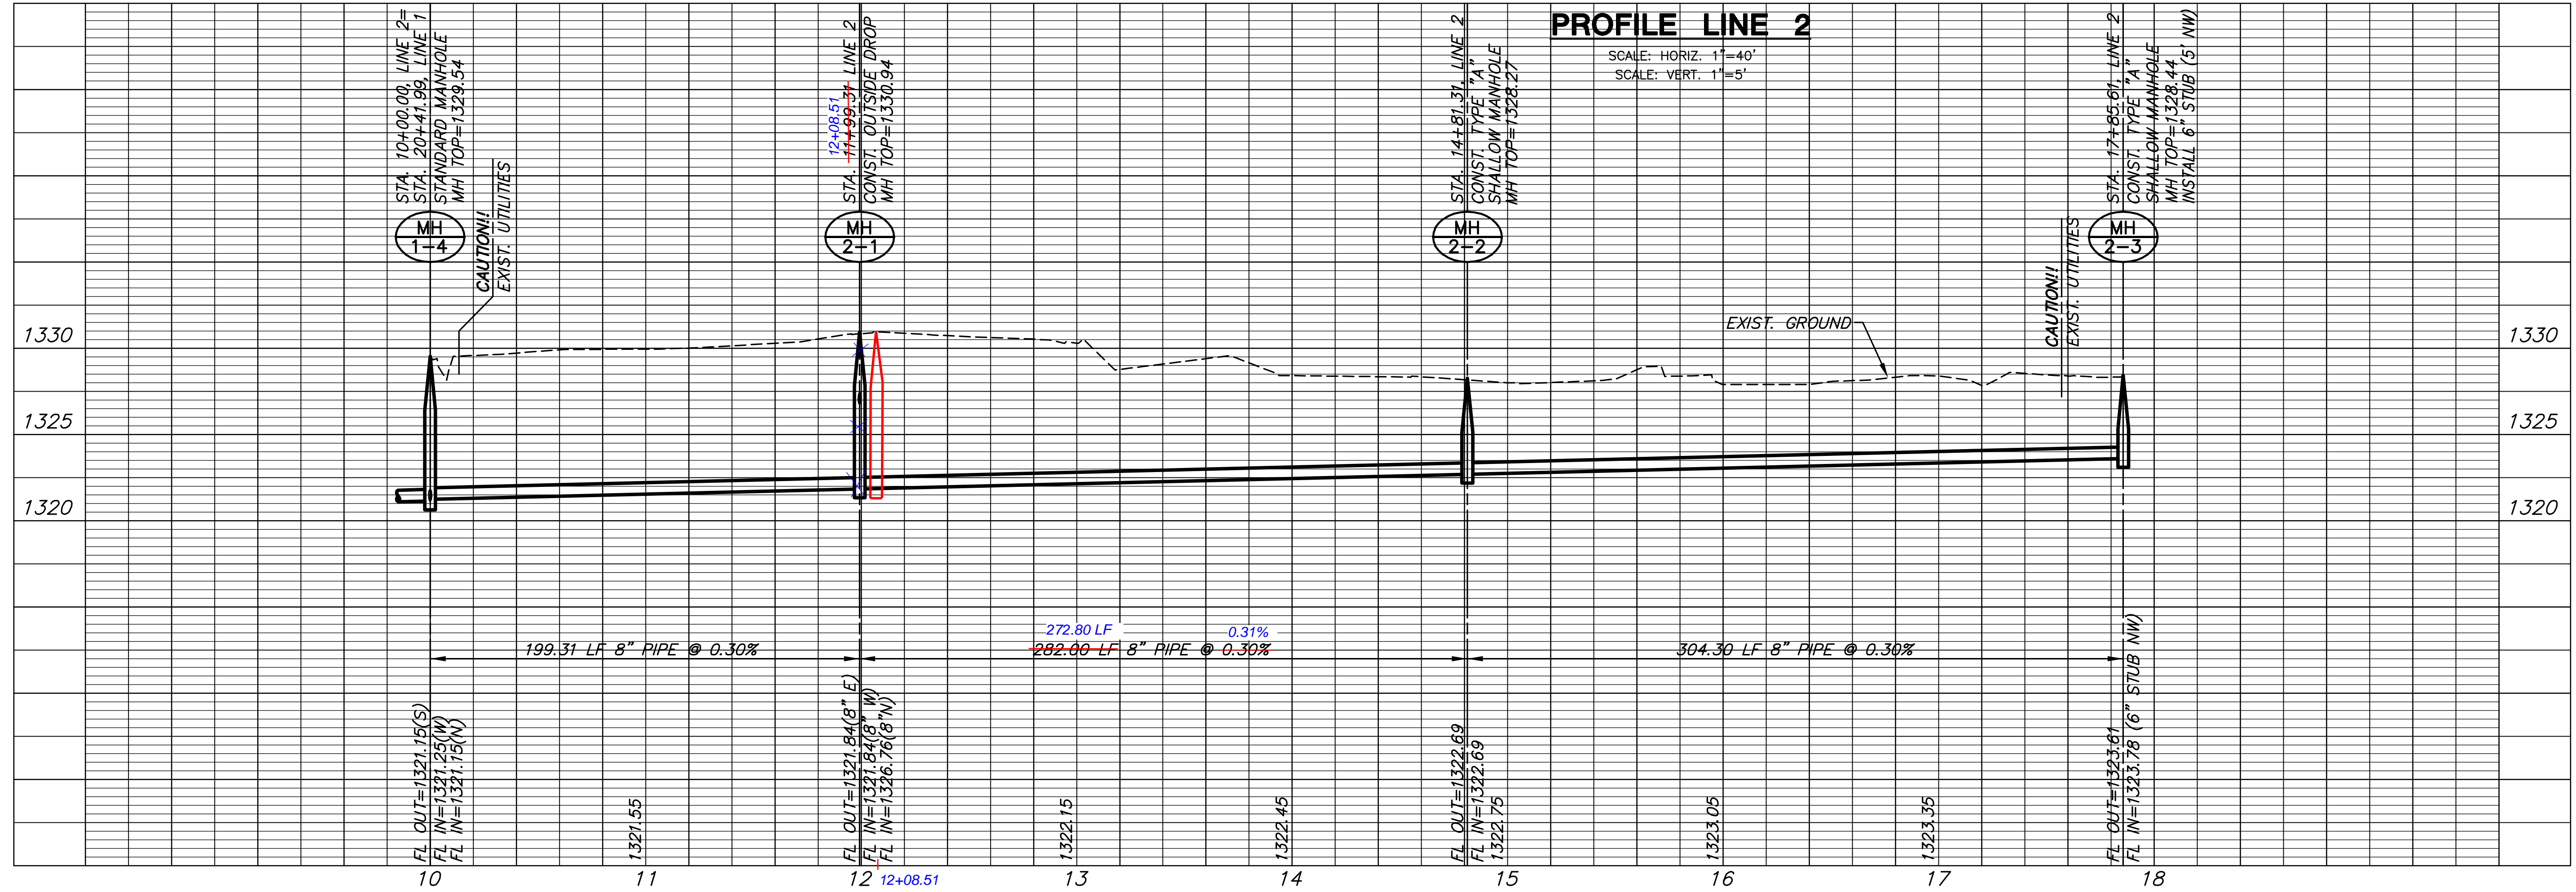

PROFILE LINE 2

PLOTTED: Tuesday, June 30, 2009 @ 01:45PM

LINE 2
SHEET TITLE
07428
PROJECT NUMBER

DESIGN BY JS
DRAWN BY JWC
CHECKED BY MAB

ISSUED June 2009
REVISED

SHEET NO.
8 of 14

J:\CIVIL\07428 LAT 23.DWG\SAN\07428B4.DWG