




**SANITARY SEWER LIFT STATION AND FORCE MAIN**  
**BOTANICA - THE WICHITA GARDENS**  
**STREETS AND UTILITIES**

**SANITARY SERVICE LINE 1**  
SHEET TITLE  
468-84683  
PROJECT NUMBER

DESIGN BY: **AJK**  
DRAWN BY: **DMU**  
CHECKED BY: **AJK**

ISSUED: **July 2010**  
REVISED: **11/04/10**

SHEET NO.  
**5 of 29**

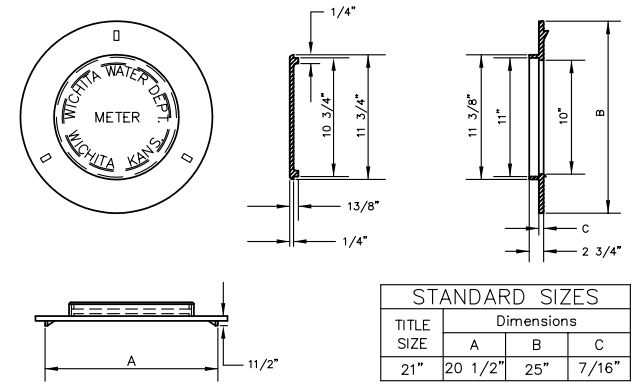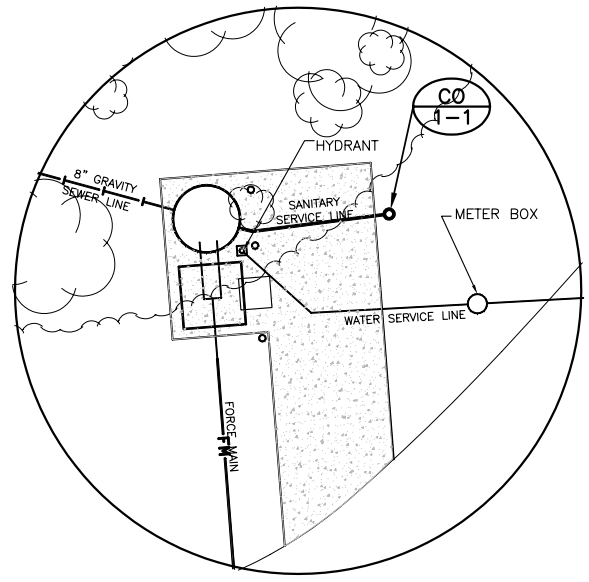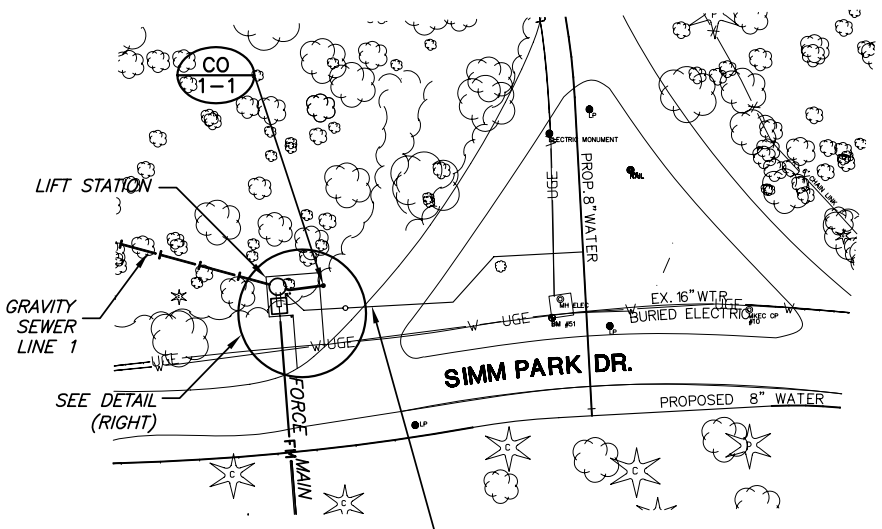


Other Approved Ring And Lids:  
Ford Meter Box Co. Inc. 21" Ring & Lid Catalog No. C-4

**RING & LID FOR METER BOXES**

N.T.S.



**NOTE:**  
CONTRACTOR TO VERIFY  
DEPTH AND LOCATION OF  
EXISTING UTILITIES PRIOR  
TO CONSTRUCTION.

**PLAN SERVICE LINE 1**

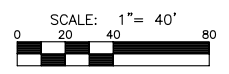

**DETAIL**  
SCALE: 1"=10'


**PROFILE SERVICE LINE 1**

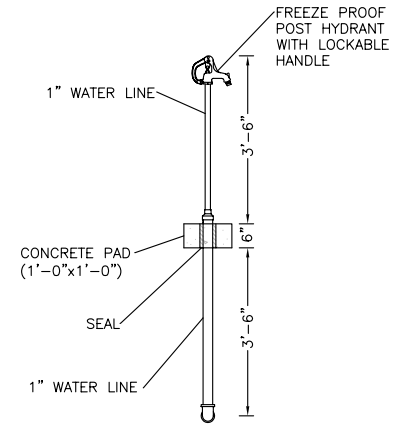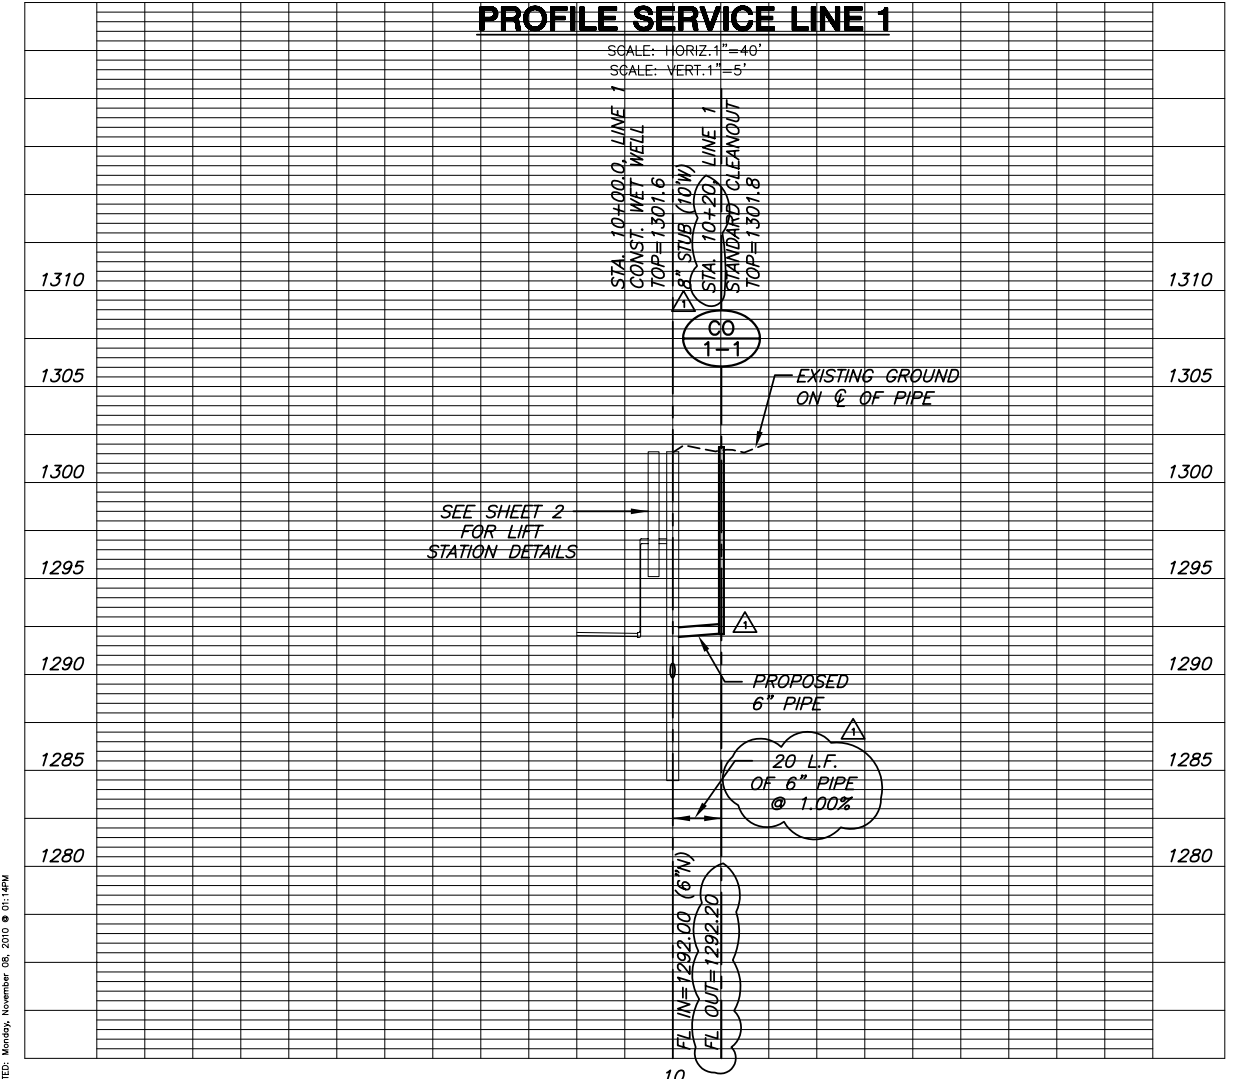

CONTRACTOR SHALL INSTALL RPZ  
BACKFLOW PREVENTOR AND VAULT  
BELOW FREEZE LINE (3.5 FEET)

**HYDRANT DETAIL**

ELEVATION - LOOKING EAST  
N.T.S.

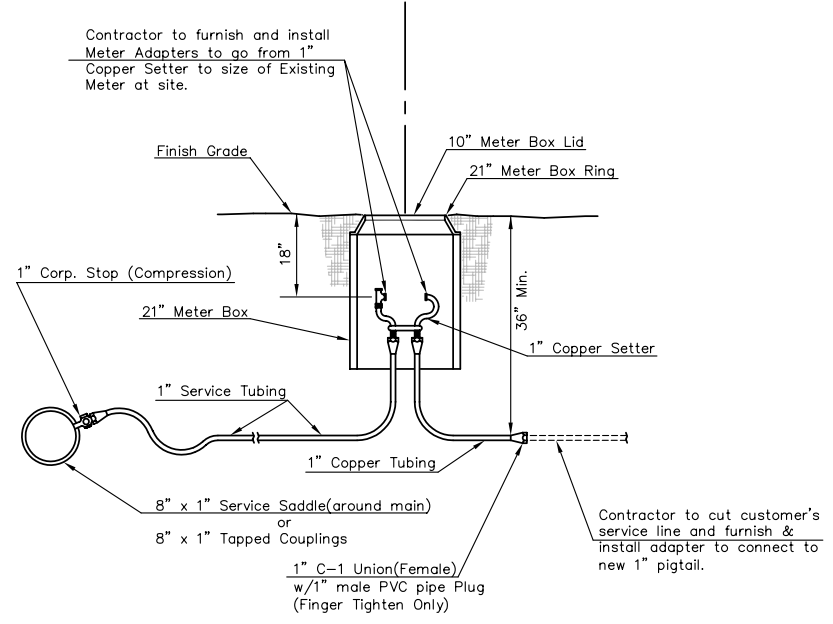

**TYPICAL METER SETTING**

**LONG SERVICE 1"**

N.T.S.