


SANITARY SEWER LIFT STATION AND FORCE MAIN  
**BOTANICA - THE WICHITA GARDENS**  
STREETS AND UTILITIES

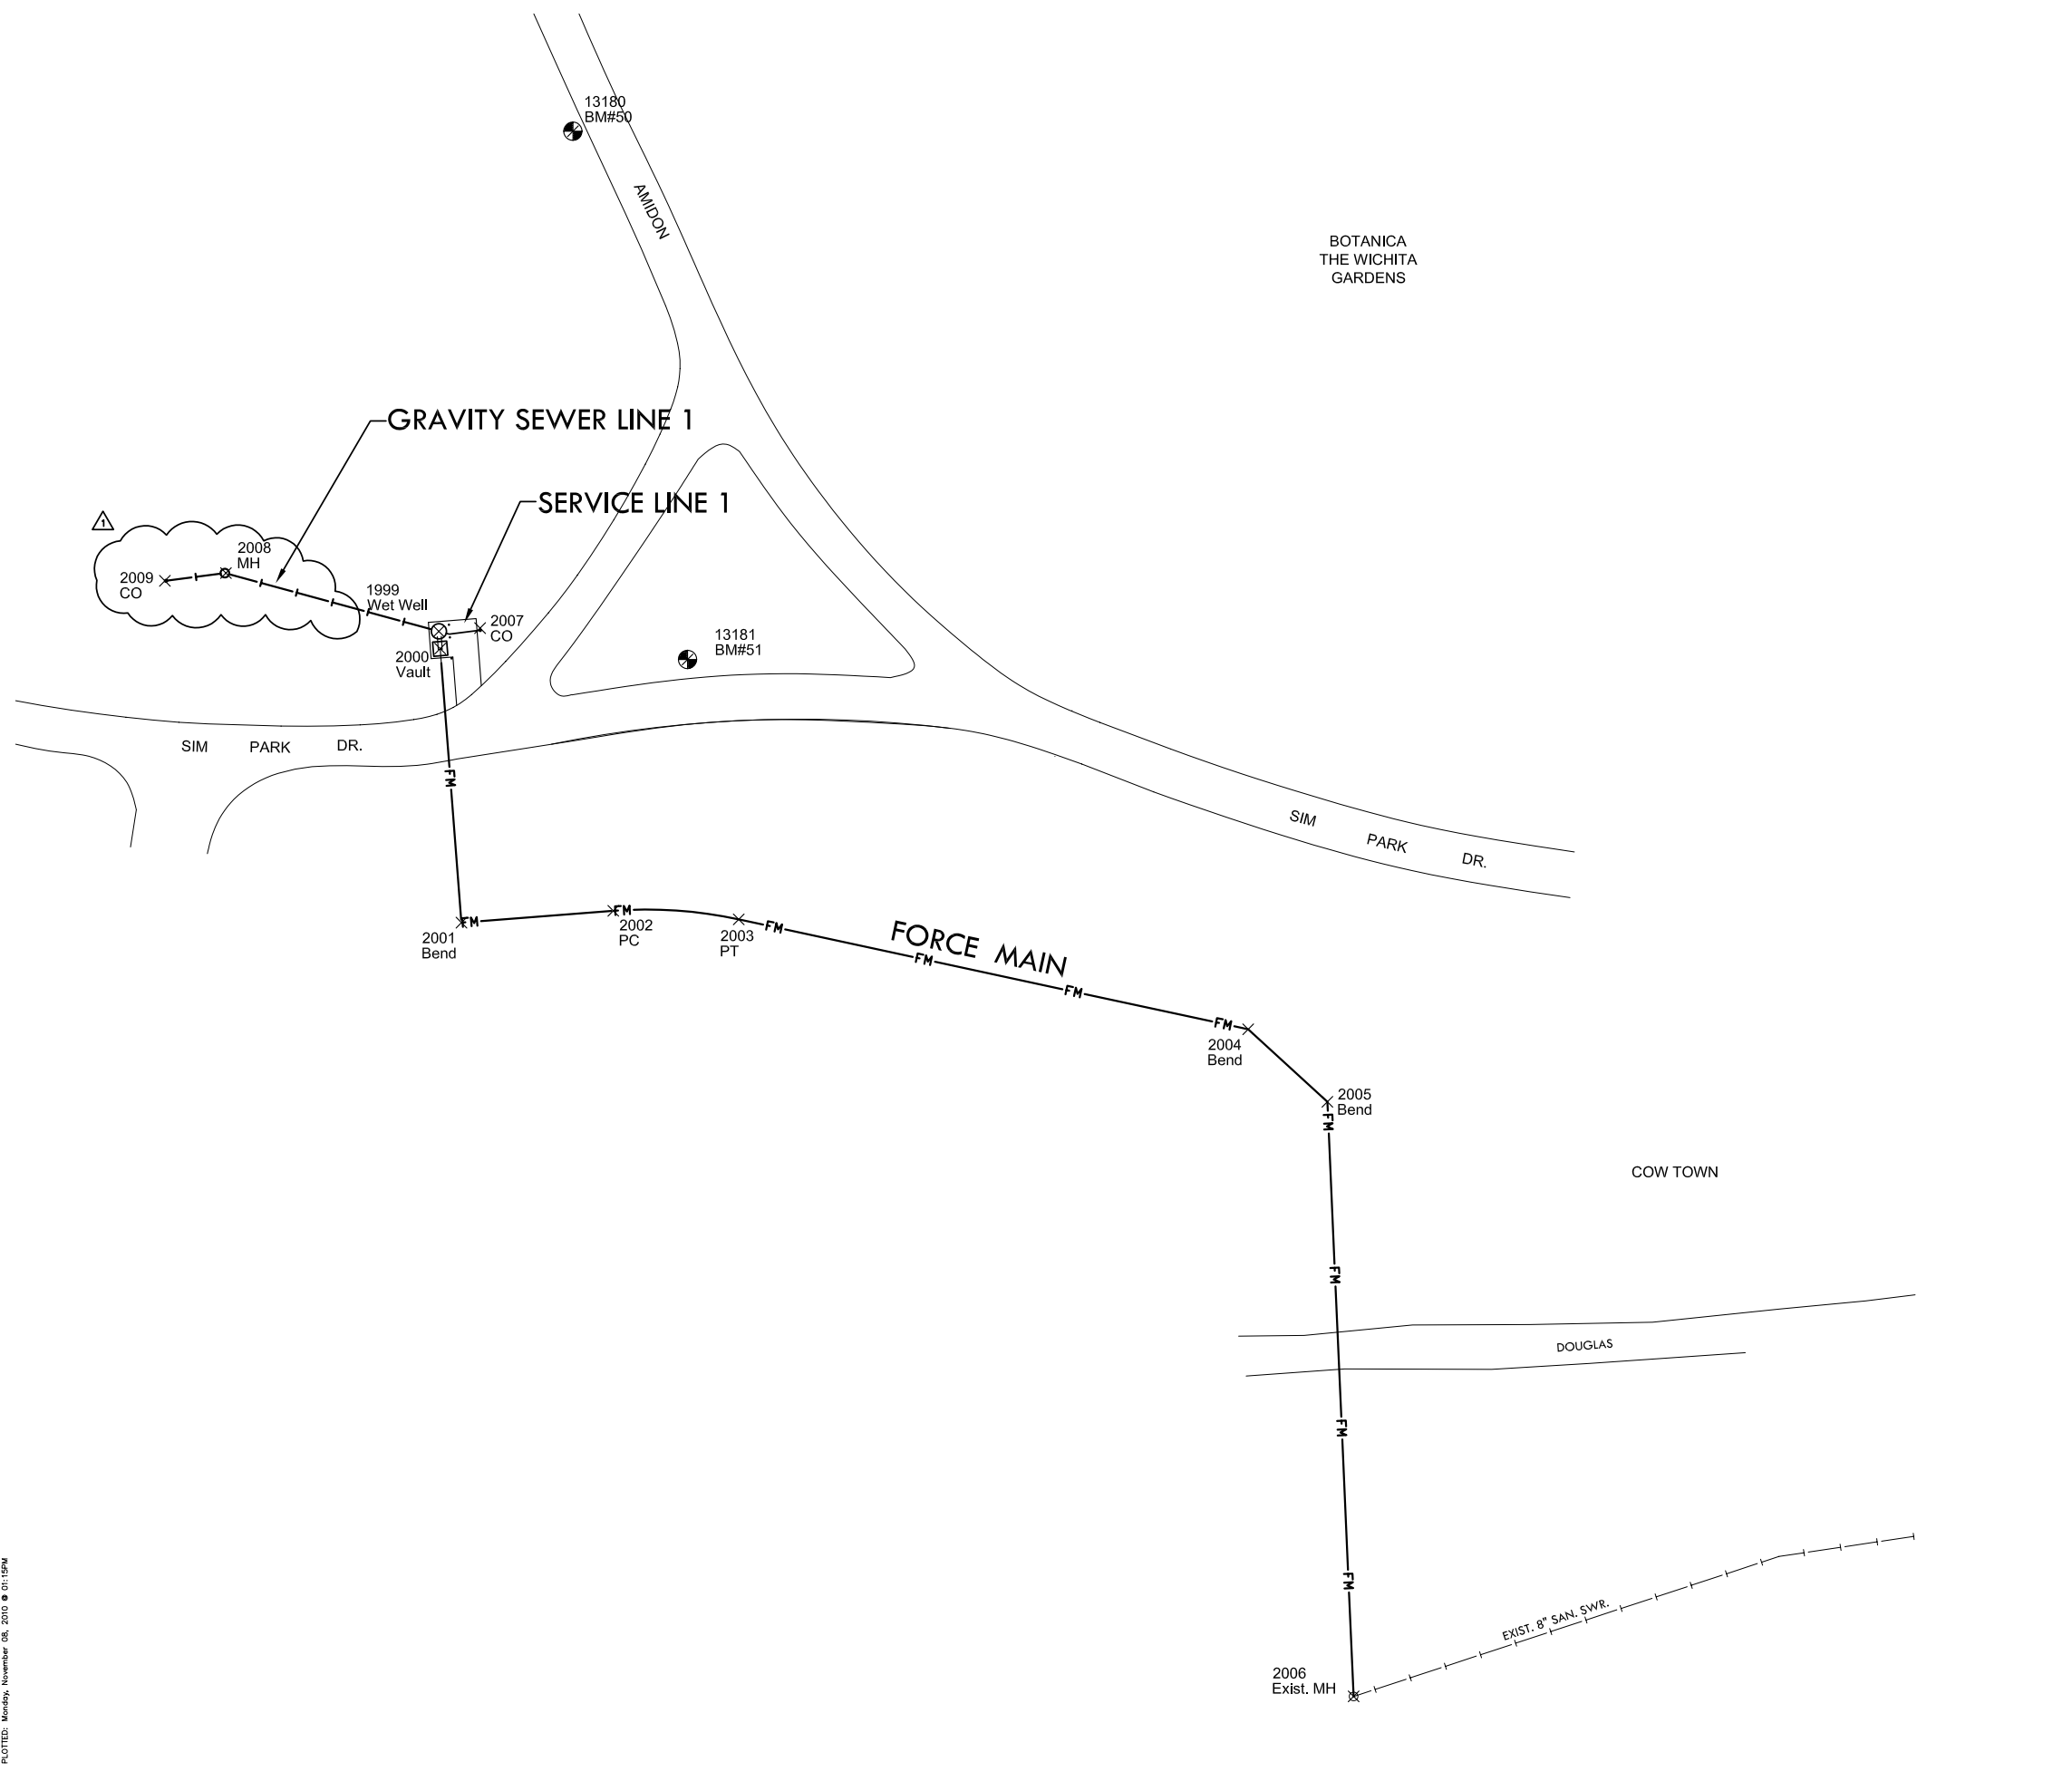

Control Points			
Point No.	Northing	Easting	Description
13180	1689086.87	1640976.10	BM#50
13181	1688844.05	1641028.79	BM#51

Force Main Points			
Number	Northing	Easting	Description
1999	1688856.98	1640914.47	Wet Well
2000	1688849.00	1640915.09	Vault
2001	1688723.07	1640924.85	Bend
2002	1688728.48	1640994.64	PC
2003	1688724.58	1641052.29	PT
2004	1688674.04	1641286.47	Bend
2005	1688640.71	1641322.88	Bend
2006	1688367.37	1641334.93	Exist. MH
2007	1688858.45	1640933.41	CO
2008	1688883.73	1640816.61	MH
2009	1688880.19	1640788.52	CO

**BUBBLE MAP**  
SHEET TITLE  
**468-84683**  
PROJECT NUMBER

DESIGN BY  
**DFL**  
DRAWN BY  
**DMU/KKL**  
CHECKED BY  
**GJA**

ISSUED  
**July 2010**  
REVISED  
**11/04/10**

SHEET NO.  
**6 of 29**