APPROVED AS NOTED BY CITY ENGINEER OF WICHITA

Sanitary Sewer Juliann Kellman 11-4-10

NOTE TO CONTRACTORS

Installation, inspection and testing for this project is to be provided by a Licensed Consulting Engineering Firm under contract with the Owner/Developer. Said Inspection to be in accordance with the City of Wichita standard construction engineering practices and certified by a Licensed Professional Engineer. No work shall be performed in dedicated easements or or public right-of-way by the Contractor without such inspection nor shall any work be commenced without written authorization by the City Engineer. All Construction and Materials shall comply with the City of Wichita Specifications and Standards (on file and available in the City Engineer's Office).

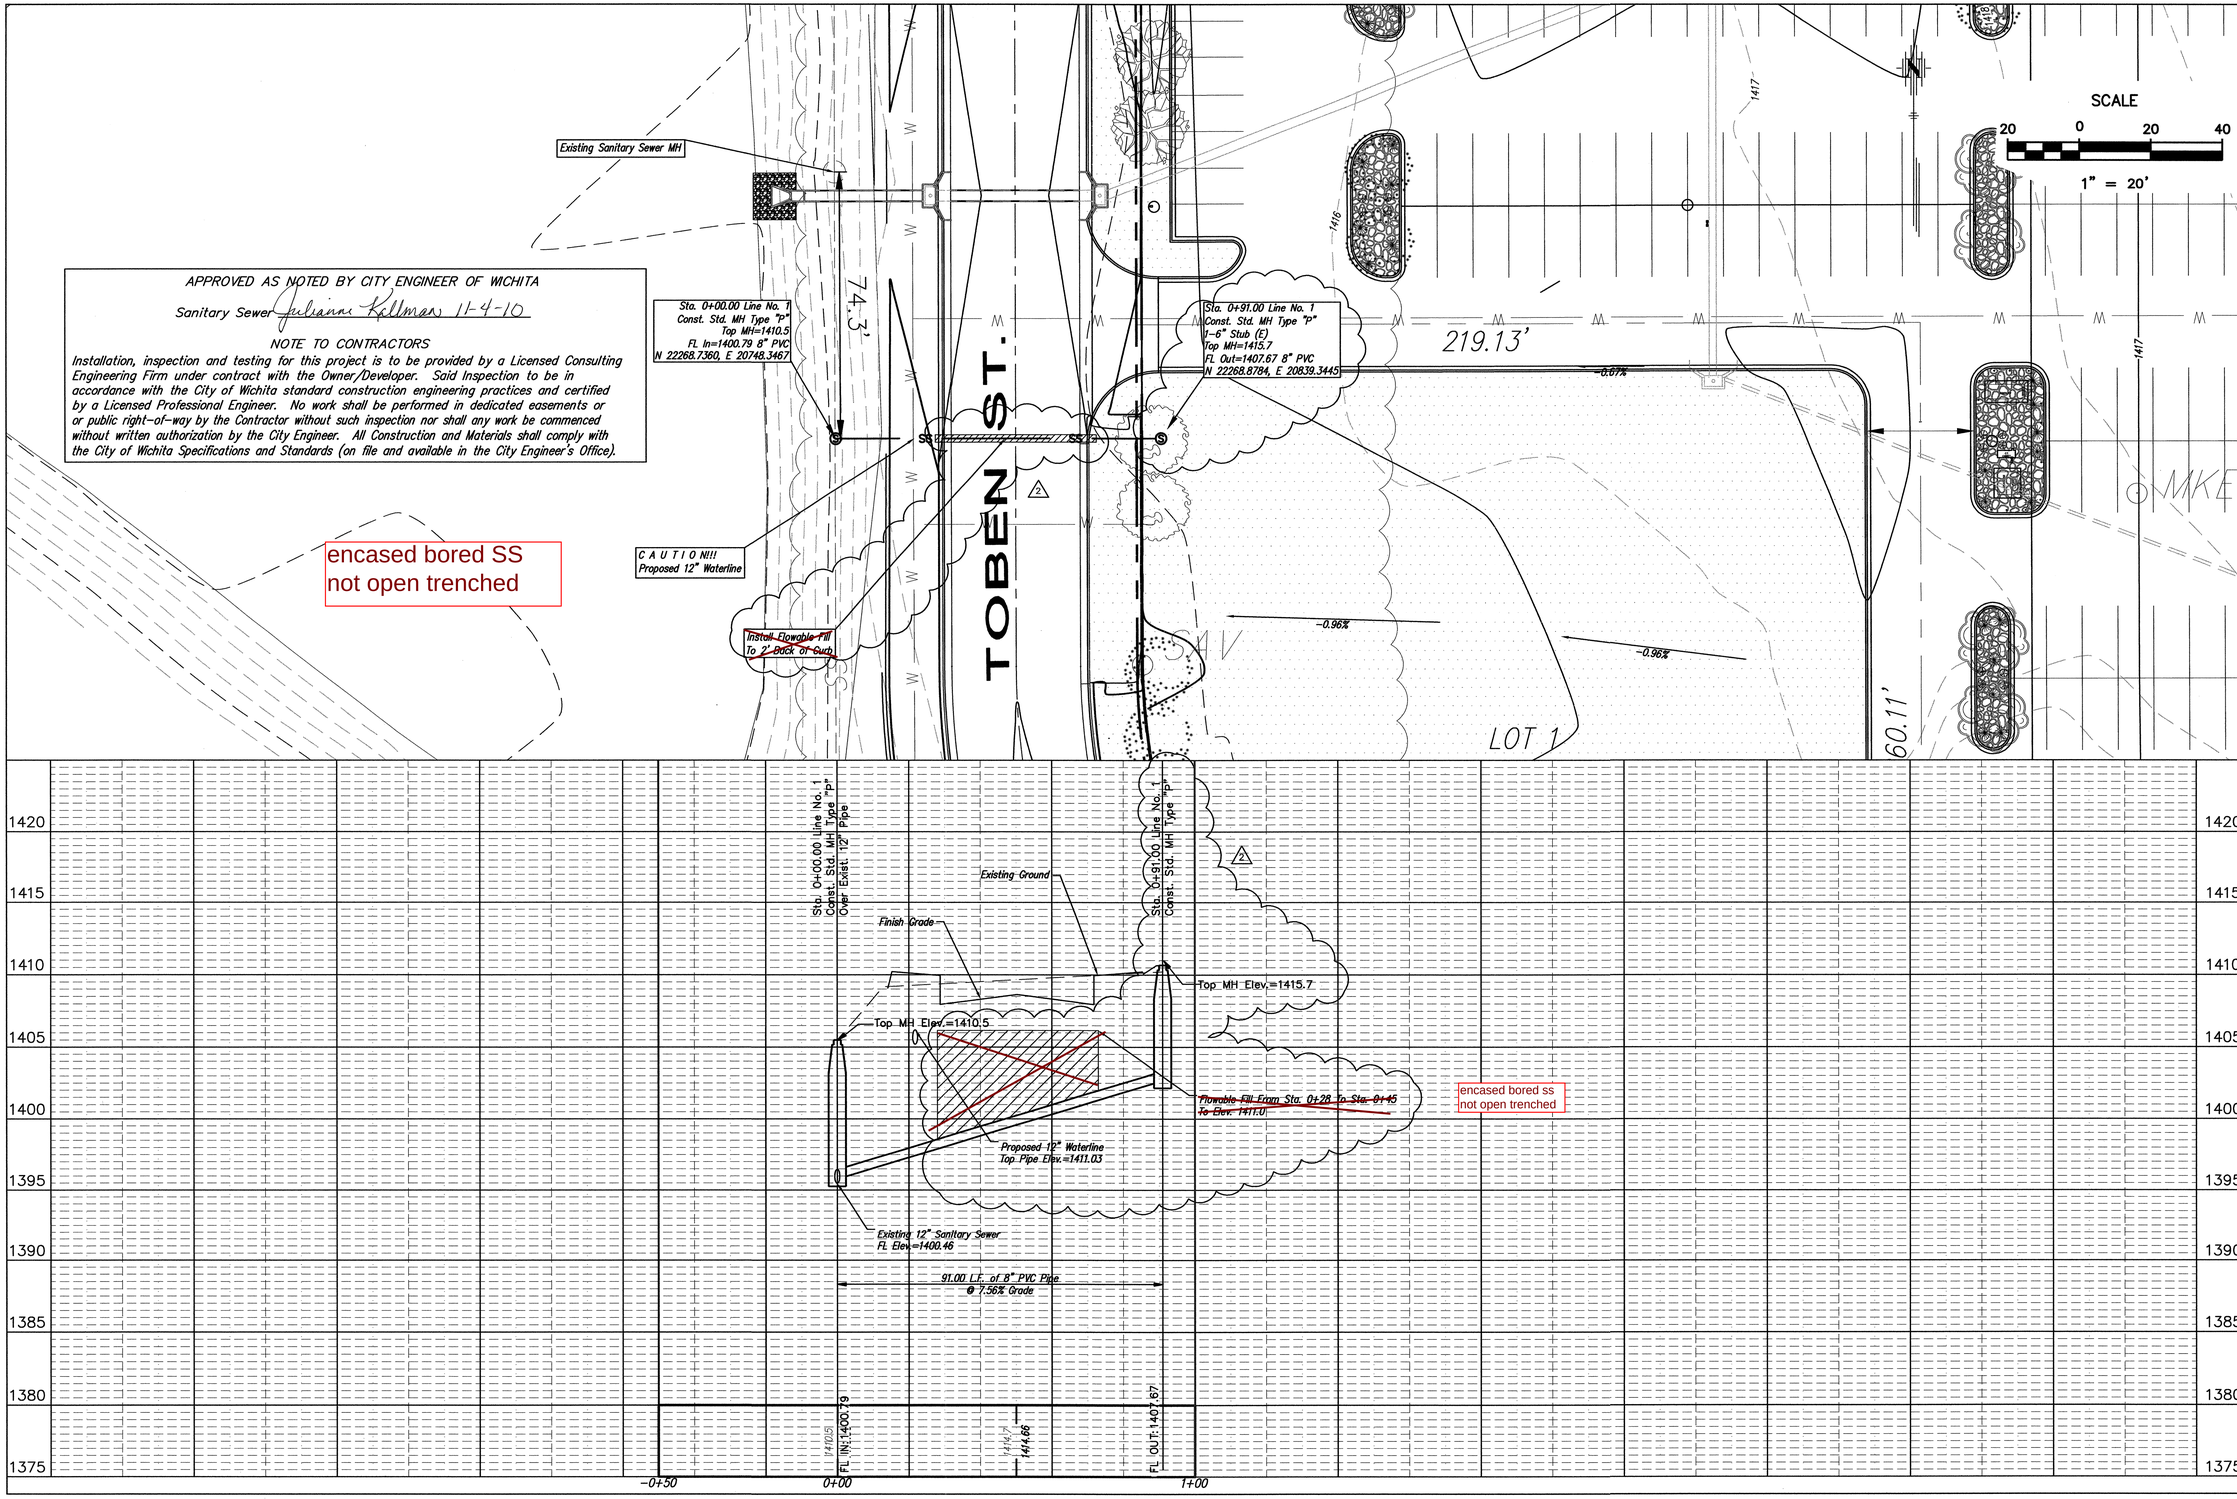

No.	Date	By	Approved	Revision
2	11/03/2010	SS	TA	Replaced cleanout with manhole and sand fill with flowable fill
1	07/15/2010	SS	TA	Add SS Line to 2042PPS

FIREPOINT ADDITION

CITY OF WICHITA, KANSAS

JAMES L. ARMOUR, P.E. - CITY ENGINEER

POE & ASSOCIATES, INC.
CONSULTING ENGINEERS
5940 E. Central, Suite 200 □ Wichita, KS 67208-4242
Phone 316/685-4114 □ FAX 316/685-4444

FINAL

Engineer: BLB

Designer: ELS

Poe Job No.: Grading-Revised Site.dwg

Date: APRIL 15, 2010

Sheet 10A of 23