


**STORM WATER SEWER #659  
GREENWICH OFFICE PARK  
SECOND ADDITION**

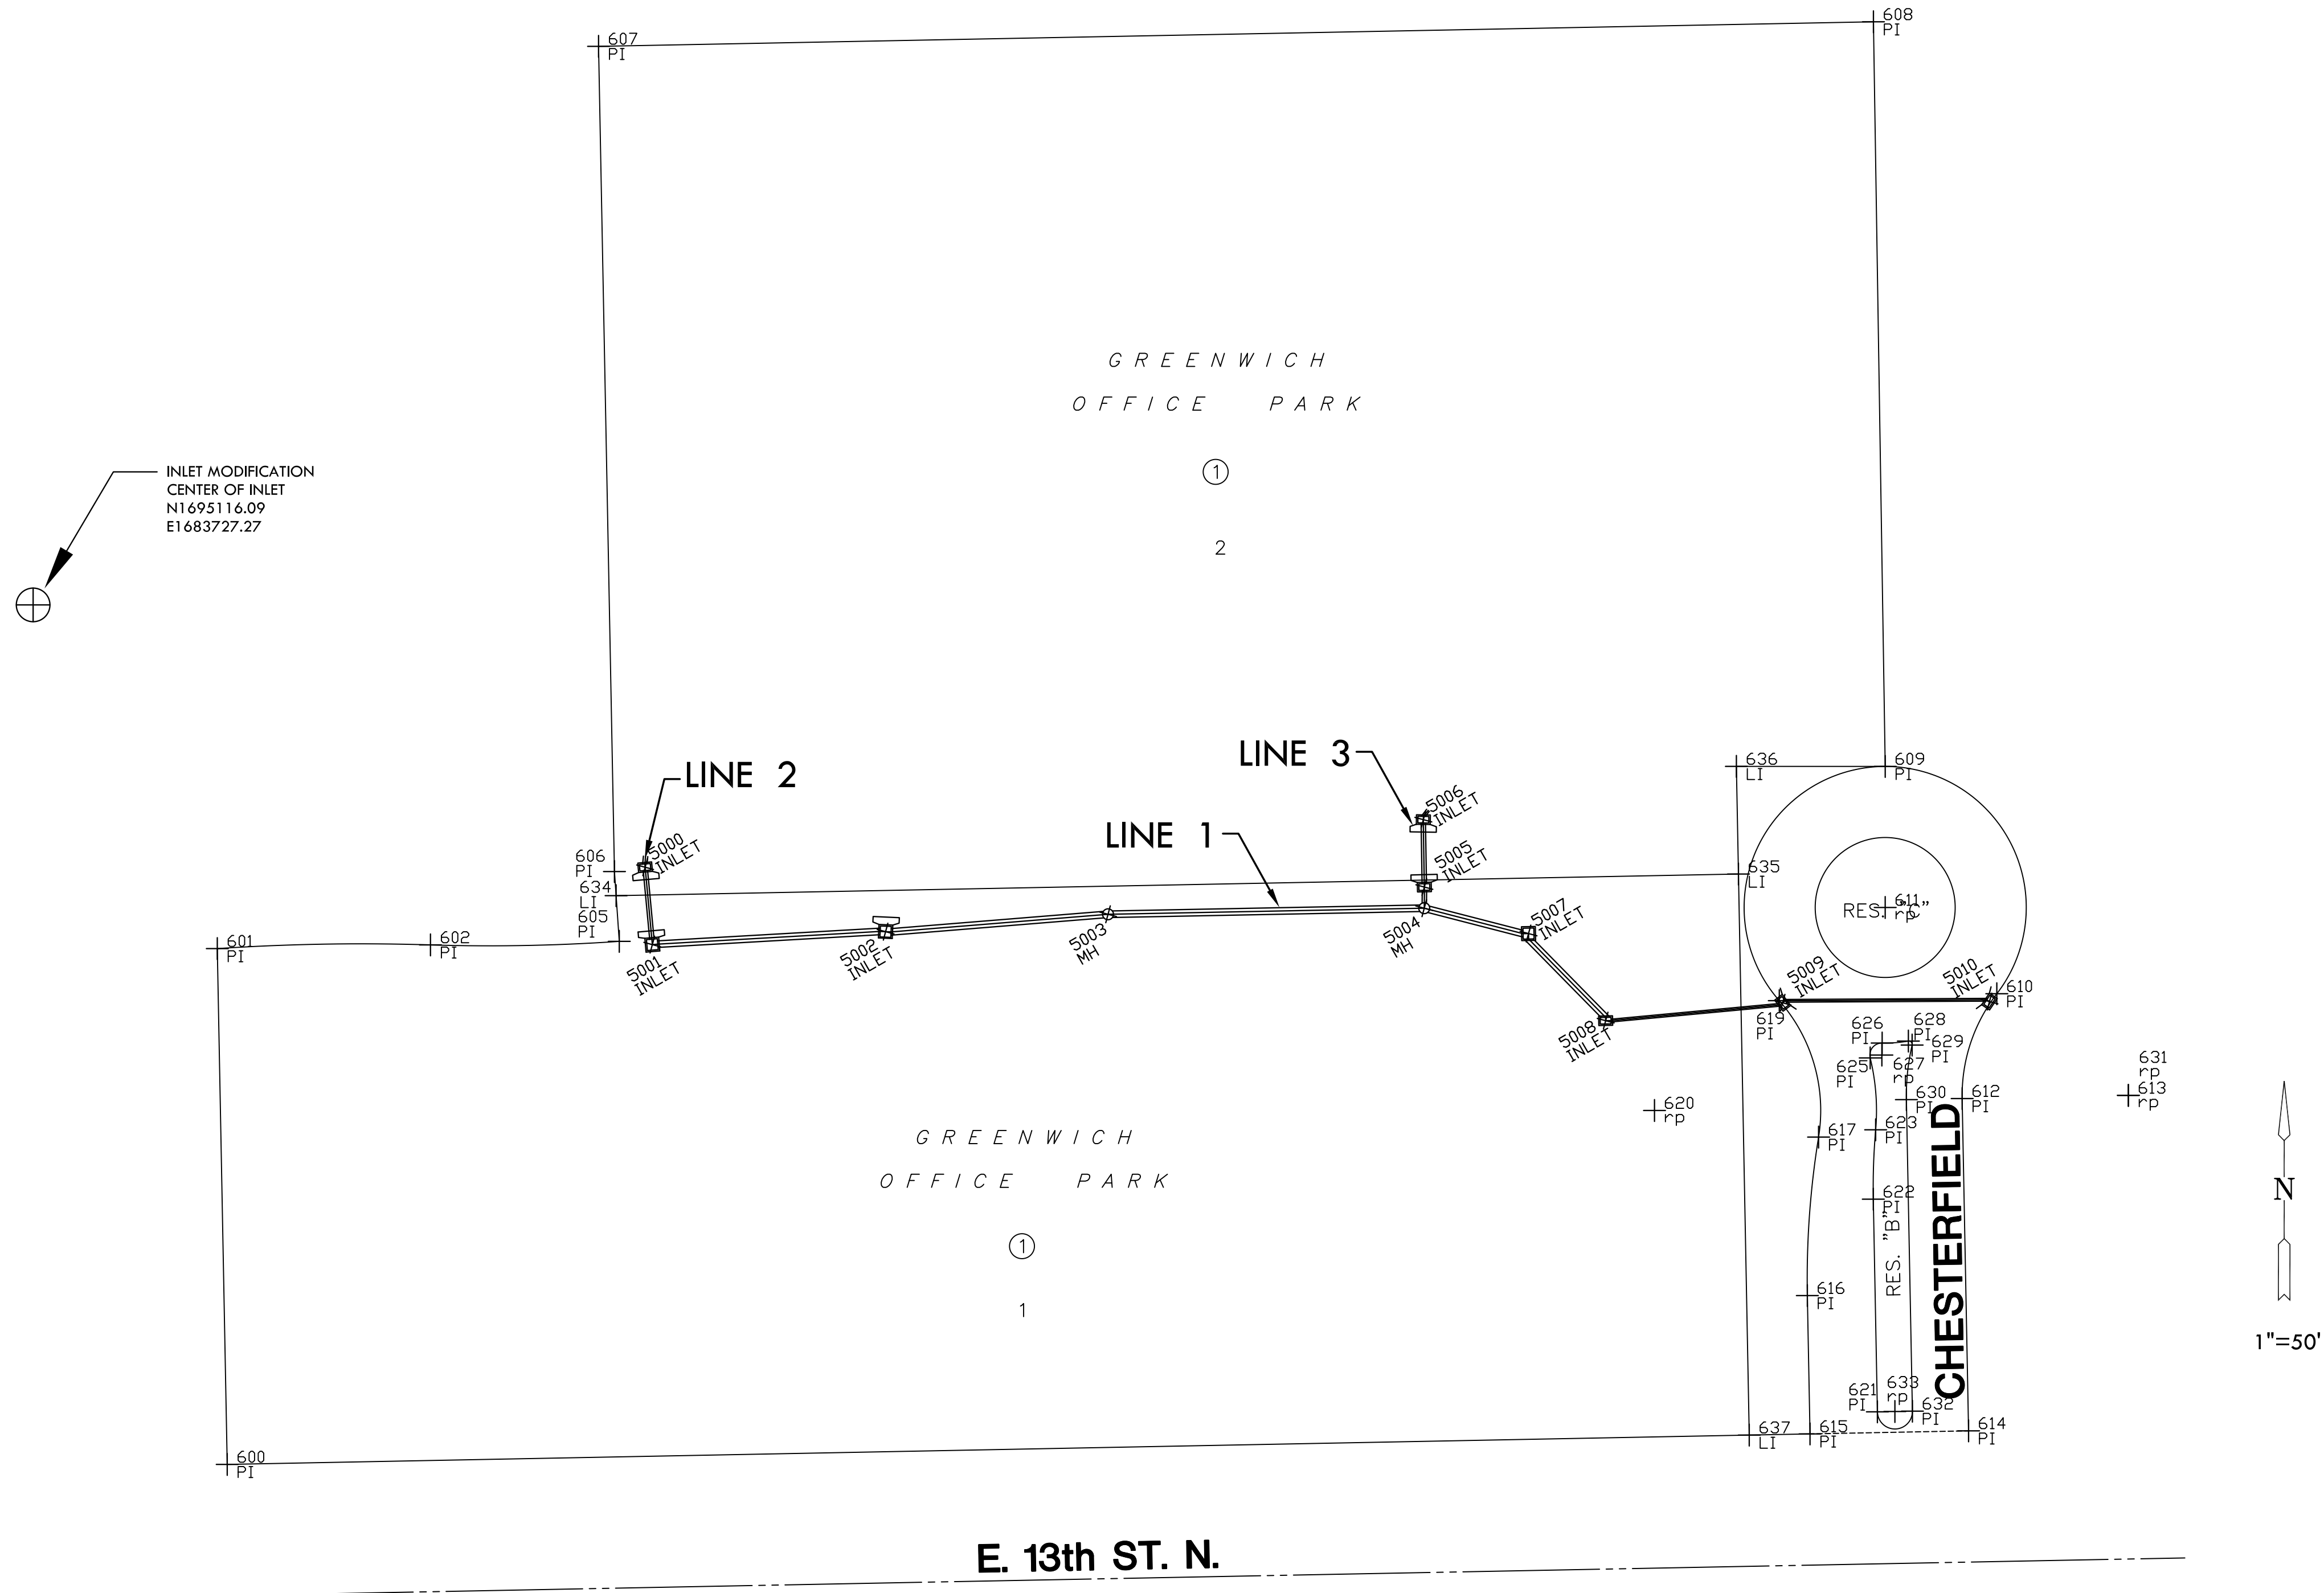

PLAT IRONS			
Point #	Northing	Eastng	Desc.
600	1694501.23	1684297.79	PI
601	1694737.08	1684293.25	PI
602	1694738.77	1684390.71	PI
603	1693739.26	1684359.30	rp
604	1695600.34	1684417.78	rp
605	1694740.38	1684477.03	PI
606	1694772.30	1684474.83	PI
607	1695149.62	1684467.56	PI
608	1695160.85	1685050.42	PI
609	1694820.38	1685055.81	PI
610	1694716.44	1685106.84	PI
611	1694755.88	1685055.80	rp
612	1694668.50	1685090.99	PI
613	1694669.97	1685166.98	rp
614	1694516.57	1685093.92	PI
615	1694515.17	1685021.43	PI
616	1694578.41	1685020.21	PI
617	1694650.88	1685025.35	PI
618	1694586.19	1685424.14	rp
619	1694713.26	1685007.38	PI
620	1694663.05	1684950.33	rp
621	1694525.26	1685052.24	PI
622	1694622.50	1685050.37	PI
623	1694654.22	1685051.44	PI
624	1694628.25	1685348.81	rp
625	1694687.09	1685048.94	PI
626	1694693.89	1685054.41	PI
627	1694688.39	1685054.29	rp
628	1694694.79	1685066.40	PI
629	1694692.97	1685068.12	PI
630	1694668.01	1685065.49	PI
631	1694669.97	1685166.98	rp
632	1694525.57	1685068.24	PI
633	1694525.42	1685060.24	rp
634	1694761.28	1684475.59	LI
635	1694771.17	1684988.72	LI
636	1694820.39	1684987.77	LI
637	1694514.63	1684993.64	LI

STORM WATER SEWER POINTS			
Point #	Northing	Eastng	Desc.
5000	1694774.28	1684488.85	INLET
5001	1694738.90	1684492.15	INLET
5002	1694744.82	1684598.79	INLET
5003	1694752.76	1684700.49	MH
5004	1694755.55	1684845.06	MH
5005	1694765.22	1684845.11	INLET
5006	1694796.04	1684844.65	INLET
5007	1694743.95	1684892.74	INLET
5008	1694704.12	1684928.01	INLET
5009	1694712.28	1685008.93	INLET
5010	1694712.85	1685103.48	INLET

PLOTTED: Tuesday, March 15, 2011 @ 11:24AM

J:\PROJECTS\2010\10356 - REGENT PARK-ALF\_1001060356\CAD\CIVIL\SWSS\PUBLIC\10356\_B.MXD

**BUBBLE MAP**  
SHEET TITLE  
**468-84725**  
PROJECT NUMBER

JTC / LES / DFL  
DESIGNED / DRAWN / CHECKED

ISSUED  
**March 2011**  
REVISED

SHEET NO.  
**8 of 14**