


Point #	Raw Description	Northing	Easting
1	Iron	5058.9334	5619.8443
2	Iron	5059.0780	5535.8444
3	Iron	5119.0779	5535.9477
4	Iron	5178.1113	5610.0494
5	Iron	5178.2214	5546.0495
6	Iron	5220.8722	5546.1229
7	Iron	5220.7621	5610.1228
8	Iron	5366.3558	5537.7478
9	Iron	5315.2681	5499.1984
10	Iron	5483.2419	5471.8246
11	Iron	5745.0004	5821.0462
12	Iron	5774.2369	5464.1144
13	Iron	5830.9396	5493.2333
14	Iron	5451.2521	5412.2187
15	Iron	5535.0219	5405.3736
16	Iron	5801.7032	5550.1651
17	Iron	5448.7321	5359.0619
18	Iron	5461.4097	5305.3943
19	Iron	5568.3457	5264.5438
20	Iron	5400.0232	5141.6534
21	Iron	5399.7837	5199.6529
22	Iron	5328.7874	5199.3597
23	Iron	5329.0270	5141.3602
24	Iron	5219.5769	5220.1748
25	Iron	5277.5769	5250.2730
26	Iron	5277.3318	5395.0601
27	Iron	5219.2484	5444.3177
28	Iron	7057.1946	5212.4987
29	Iron	6993.1951	5212.2344
30	Iron	7056.3396	5419.4970
31	Iron	6992.3402	5419.2326
32	Iron	6923.0599	5486.9512
33	Iron	6784.5655	5550.3756
34	Iron	6784.8298	5486.3761
35	Iron	6716.2961	5619.6252
36	Iron	6652.2937	5619.9281
37	Iron	6714.5815	5958.1204
38	Iron	6650.5823	5957.7962
39	Iron	6481.7335	6124.9431
40	Iron	6481.4094	6188.9423
41	Iron	5736.6461	6185.1698
42	Iron	5736.9703	6121.1706
43	Iron	5660.8361	5937.1195
44	Iron	5615.3953	5892.0514
45	Iron	5748.4837	5678.9561
46	Iron	5808.9203	5700.0135
47	Iron	6022.8303	5326.8159
48	Iron	5974.1147	5285.3093
49	Iron	6022.8303	5326.8159
50	Iron	6077.4518	5262.7077
51	Iron	6194.5443	5208.9357
52	Iron	6194.8086	5144.9362
53	Iron	6679.4042	5146.9359
54	Iron	6743.4037	5147.2021
55	Iron	6679.9034	5026.9388
56	Iron	6743.9028	5027.2031
57	Iron	6679.8902	5007.0821
58	Iron	6743.9995	5007.3059
59	Iron	7269.7767	5149.3762
60	Iron	7269.5124	5213.3757
61	Iron	7401.2315	5281.4394
62	Iron	7401.4947	6061.0522
63	Iron	7336.4947	6060.9917
64	Iron	7268.1503	6128.9665
65	Iron	7267.8261	6192.9257
66	Iron	7053.2214	6127.8379
67	Iron	6996.2635	5921.9568
68	Iron	6995.2222	6127.5441
69	Iron	6893.4041	6191.0292
70	Iron	6892.6949	6331.0274
71	Iron	6829.4049	6190.7050
72	Iron	6828.6958	6330.7032
73	Iron	6647.5861	6154.7340
74	Iron	6647.2663	6137.1301
75	Iron	6672.3967	6090.3444
76	Iron	6369.7350	6124.3758
77	Iron	6305.7358	6124.0516
78	Iron	6306.8096	5912.0543
79	Iron	6370.8088	5912.3785
80	Iron	6239.4791	5779.7116
81	Iron	6239.1549	5843.7108
82	Iron	5833.8618	5841.6578
83	Iron	5834.1860	5777.6587
84	Iron	5802.6147	5769.7044
85	Iron	5772.5764	5866.2172
86	Iron	5754.4378	5816.5760
87	Iron	5784.4761	5760.0632
88	Iron	5059.9997	5000.2485
89	Iron	7541.4673	5010.4972
90	Iron	7540.2530	6334.3074
91	Iron	5057.7633	6321.7329

Point #	Elevation	Northing	Easting
8500	1347.500	6099.4143	6187.0074
8501	1348.800	6189.4131	6187.4632
8502	1350.100	6279.4119	6187.9191
8503	1350.800	6369.4108	6188.3750
8504	1351.500	6459.4096	6188.8308
8505	1352.100	6549.4084	6179.0976
8506	1353.100	6628.7263	6137.1301
8507	1353.800	6729.4073	6189.9806
8508	1354.300	6829.4049	6190.7050
8509	1354.300	6853.7288	6126.8274
8510	1352.100	6854.2353	6026.8286
8511	1351.200	6854.6912	5936.8298
8512	1349.500	6855.1470	5846.8310
8513	1349.500	6855.5220	5772.8055
8514	1350.700	6855.9380	5690.6716
8515	1354.600	6856.6472	5550.6733
8516	1343.500	6342.6431	5344.5485
8517	1344.000	6437.6423	5344.9409
8518	1345.500	6532.6415	5345.3333
8519	1346.600	6622.6407	5345.7050
8520	1346.500	6678.6631	5345.9364
8521	1347.000	6712.6399	5346.0767
8522	1348.500	6802.6392	5346.4485
8523	1349.500	6892.6384	5346.8202
8524	1353.900	6992.6375	5347.2332
8525	1346.000	6511.6073	5755.0897
8526	1344.700	6214.6393	5644.5840
8527	1345.000	6352.1615	5645.2806
8528	1346.000	6486.8693	5781.3600
8529	1346.000	6511.3490	5806.0890
8530	1346.500	6511.1514	5845.0885
8531	1347.000	6510.7462	5925.0875
8532	1347.900	6510.2650	6020.0863
8533	1352.000	6509.7451	6122.7352
8534	1347.000	6512.0632	5665.0908
8535	1347.000	6512.1645	5645.0911
8536	1347.000	6512.8476	5510.2342
8537	1347.000	6527.3677	5495.8470
8538	1351.700	6854.4379	5986.8292
8539	1350.000	6959.6247	5691.0998
8540	1351.000	6991.3879	5691.2310
8541	1351.000	7088.6004	5639.7516
8542	1351.000	7116.5009	5624.9767
8543	1351.000	7174.9613	5531.0275
8544	1351.200	7197.0291	5495.5634
8545	1352.000	7196.7903	5401.0769
8546	1352.900	7197.1537	5313.0777
8547	1354.700	7197.2960	5213.0774

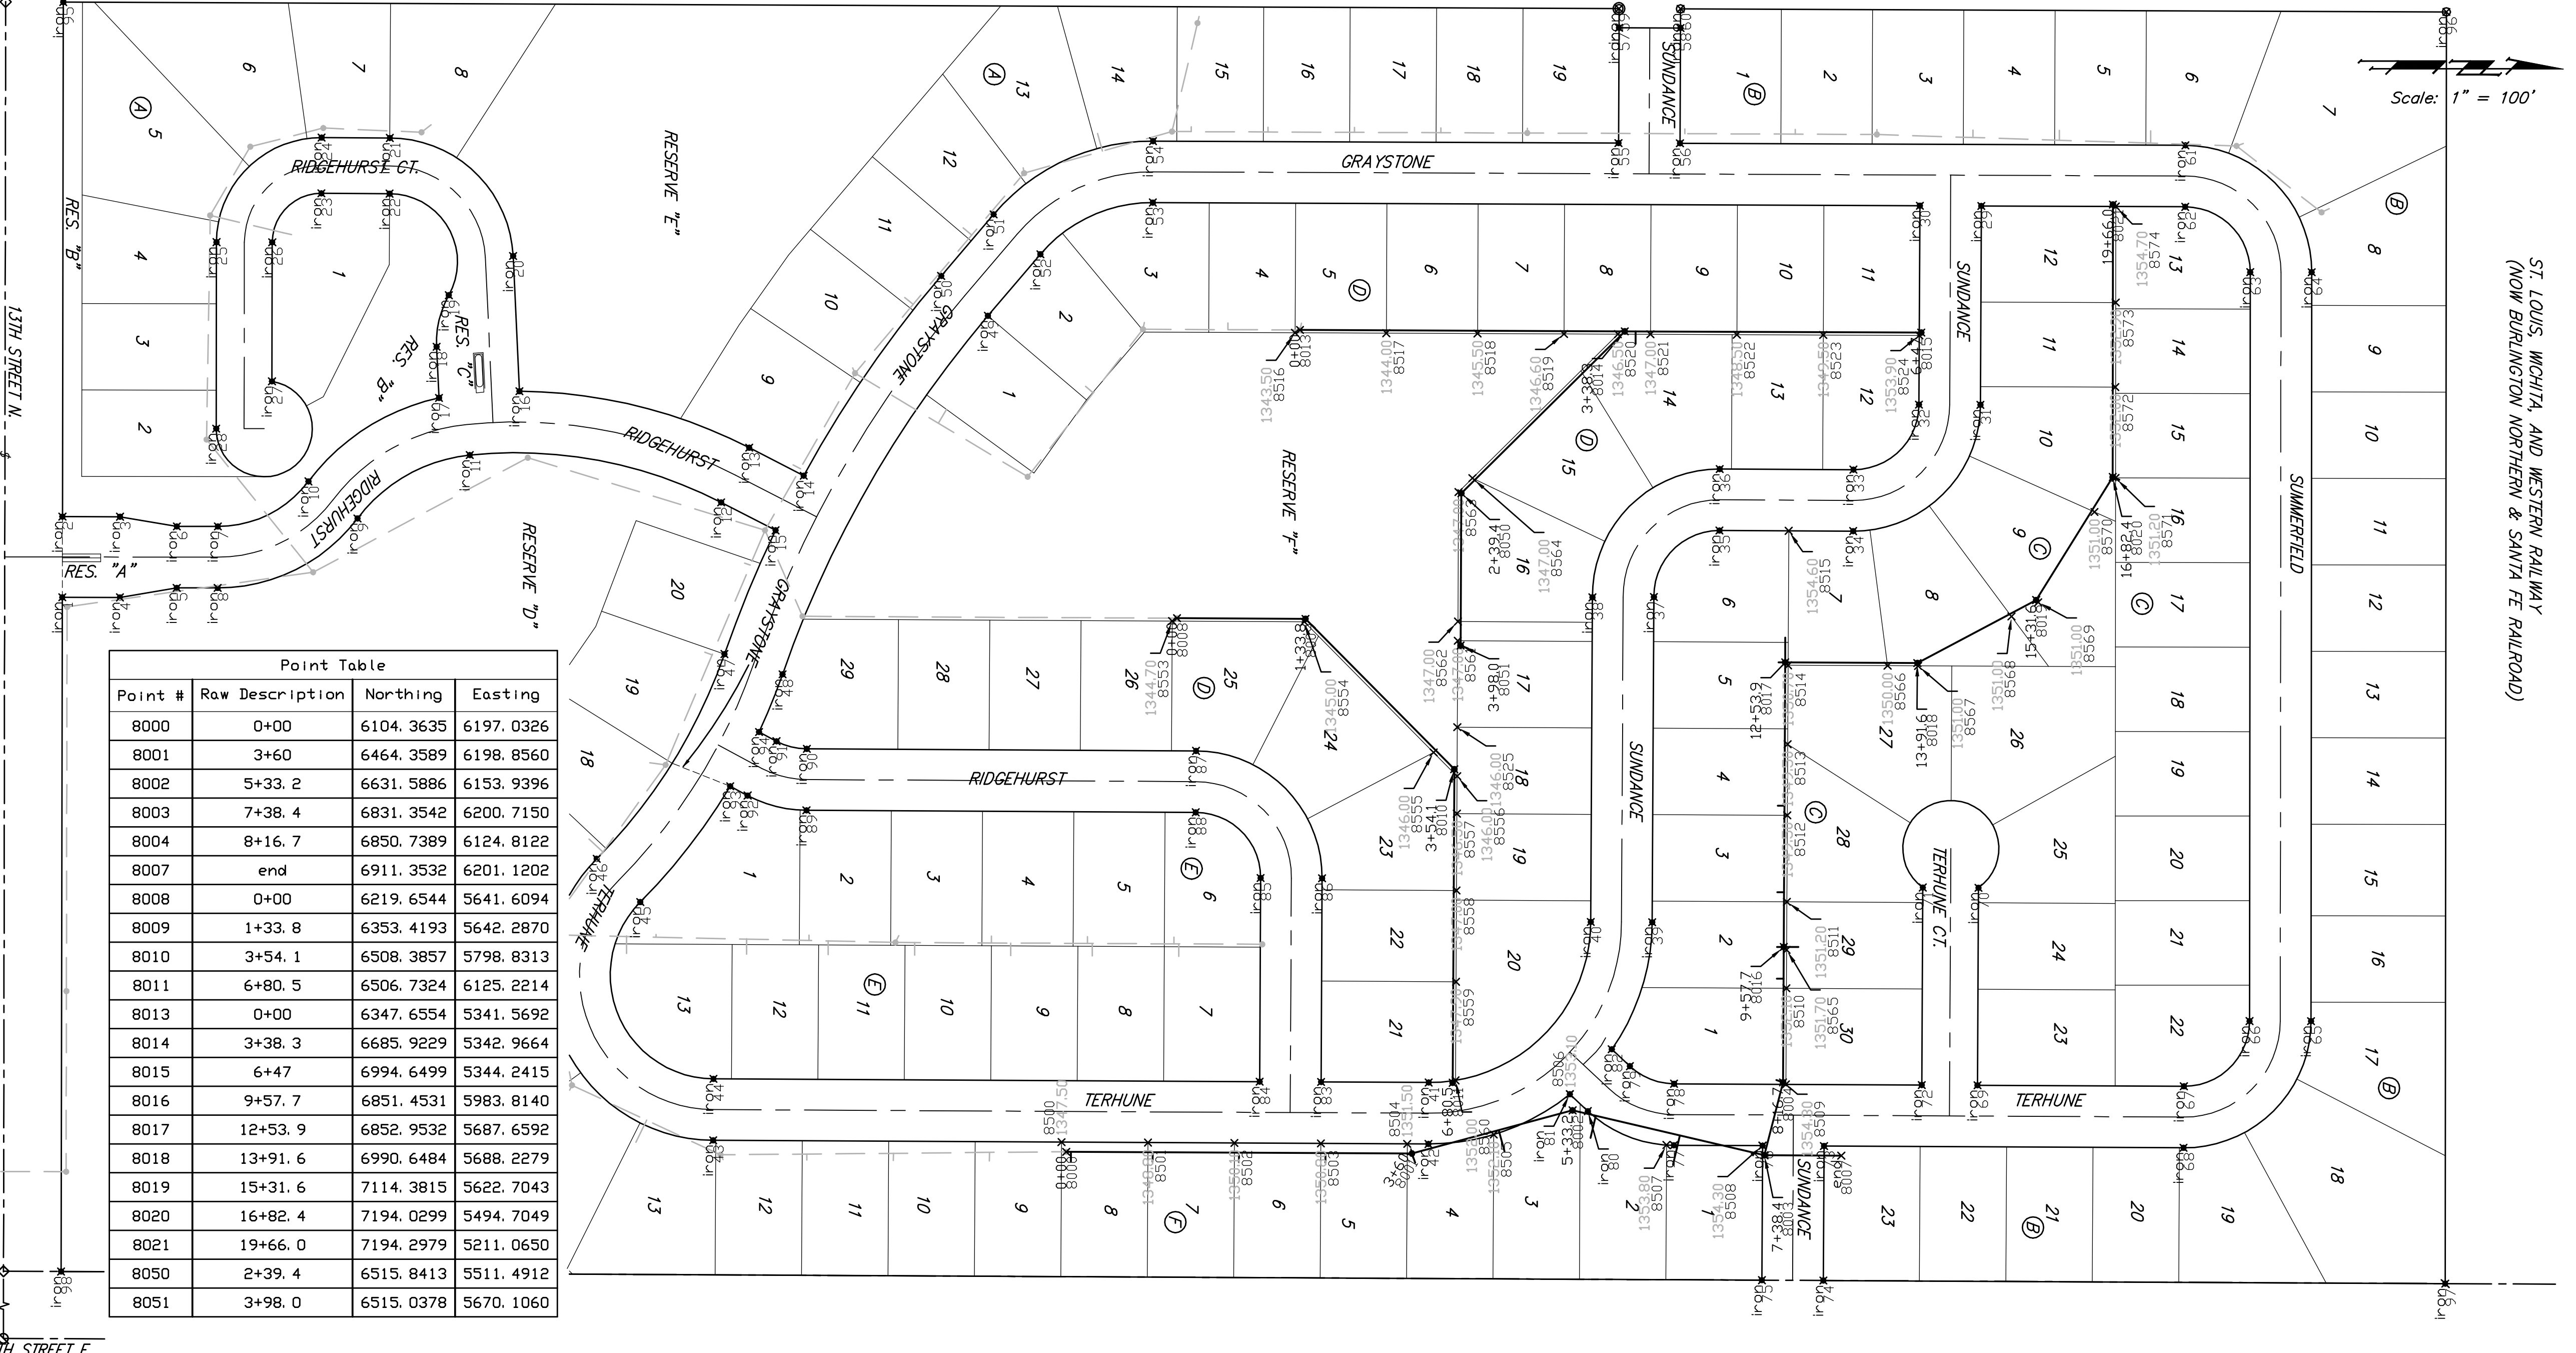

Point #	Raw Description	Northing	Easting
8000	0+00	6104.3635	6197.0326
8001	3+60	6464.3589	6198.8560
8002	5+33.2	6631.5886	6153.9396
8003	7+38.4	6831.3542	6200.7150
8004	8+16.7	6850.7389	6124.8122
8007	end	6911.3532	6201.1202
8008	0+00	6219.6544	5641.6094
8009	1+33.8	6353.4193	5642.2870
8010	3+54.1	6508.3857	5798.8313
8013	0+00	6347.6554	5341.5692
8014	3+38.3	6685.9229	5342.9664
8015	6+47	6994.6499	5344.2415
8016	9+57.7	6851.4531	5983.8140
8017	12+53.9	6852.9532	5687.6592
8018	13+91.6	6990.6484	5688.2279
8019	15+31.6	7114.3815	5622.7043
8020	16+82.4	7194.0299	5494.7049
8021	19+66.0	7194.2979	5211.0650
8050	2+39.4	6515.8413	5511.4912
8051	3+98.0	6515.0378	5670.1060