DESCRIPTION:
AS-BUILT SURVEY OF THE PARK AND RIDE PARKING LOT LOCATED AT MID-CONTINENT AIRPORT IN WICHITA, KANSAS.

SURVEYORS CERTIFICATE:
I HEREBY CERTIFY THAT THIS SURVEY WAS MADE UNDER MY SUPERVISION ON SEPTEMBER 18, 2011.

LEGEND

EL – ELEVATION
FL – FLOW LINE
FLR – FLOOR
HH – HAND HELD
TC – TOP OF CURB

LEVID P. DORZWEILER
REGISTERED
LS-885
10-18-2011
KANSAS
LAND SURVEYOR

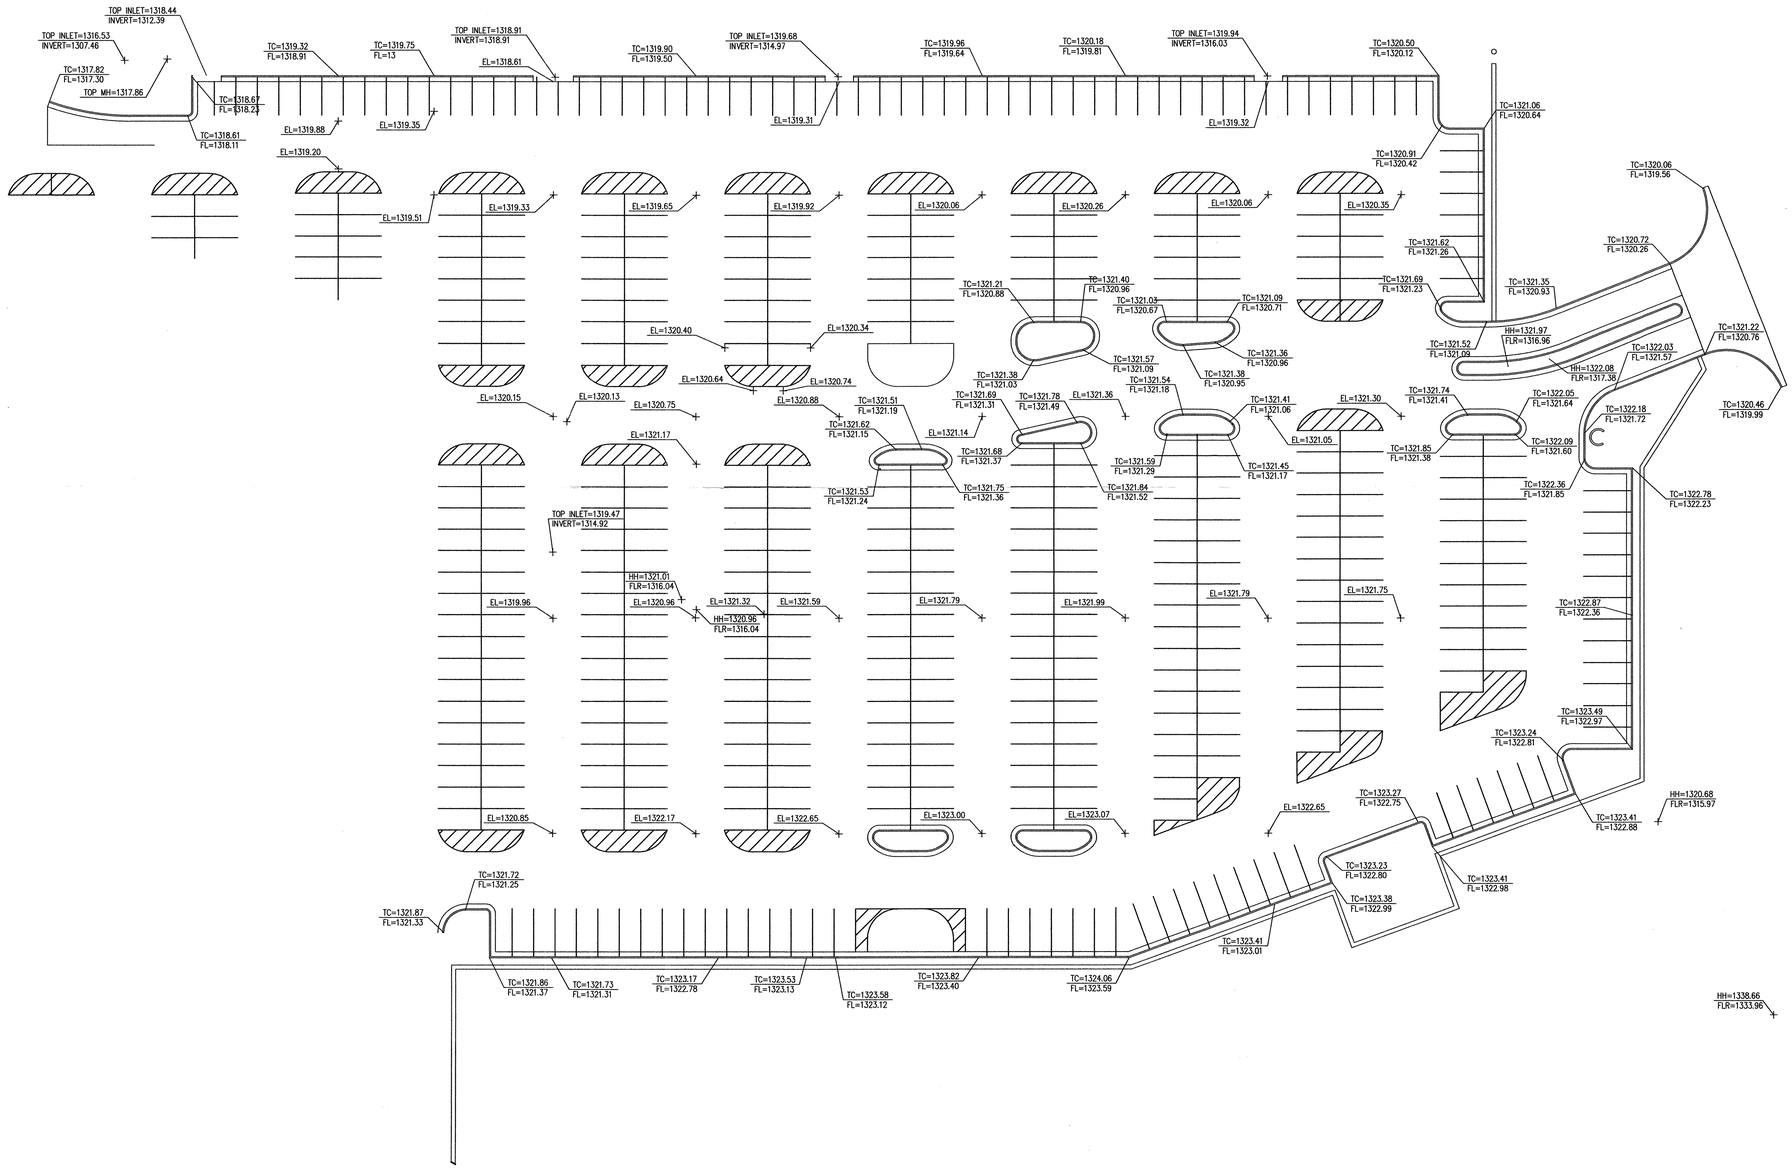

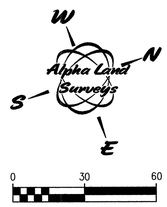

SURVEY FOR:
RUGGLES AND BOHM

SURVEY TYPE:
PARK & RIDE ASBUILT

Alpha Land Surveys, Inc.
ONE EAST NINTH AVENUE
HUTCHINSON, KANSAS 67501
PH: (620) 728-0012 FAX: (620) 728-0413

SURVEY DATE: 9/18/2011	PLOT DATE: 10/10/2011
DRAWN BY: LPD/RB	PROJ. NO.: 110088S
CHECKED BY: RDB	SHEET 1 OF 1