



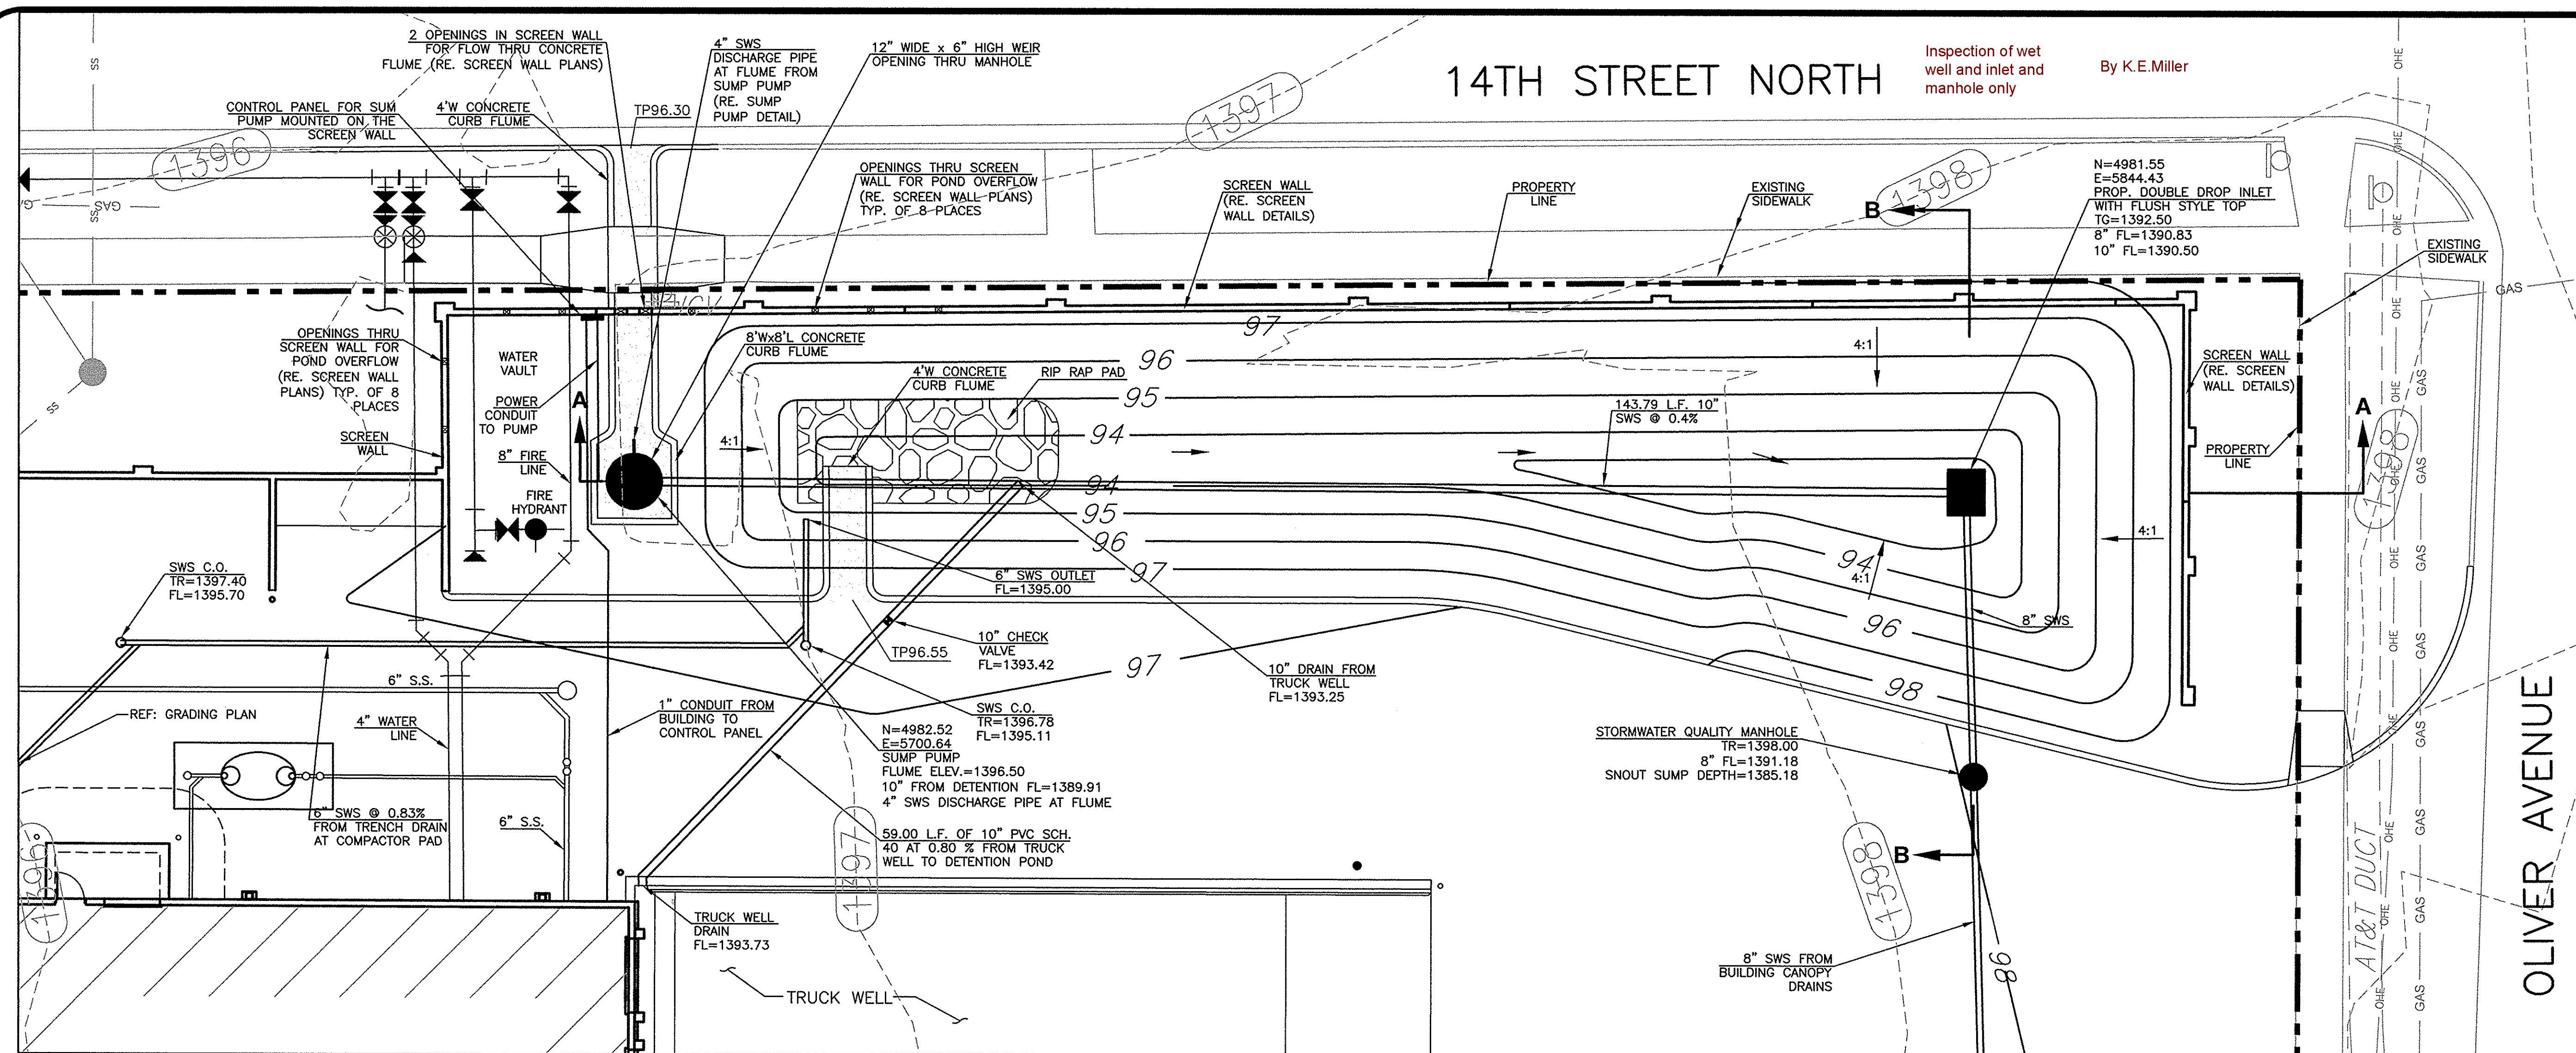

DETENTION POND PLAN
SCALE: 1"=10'-0"

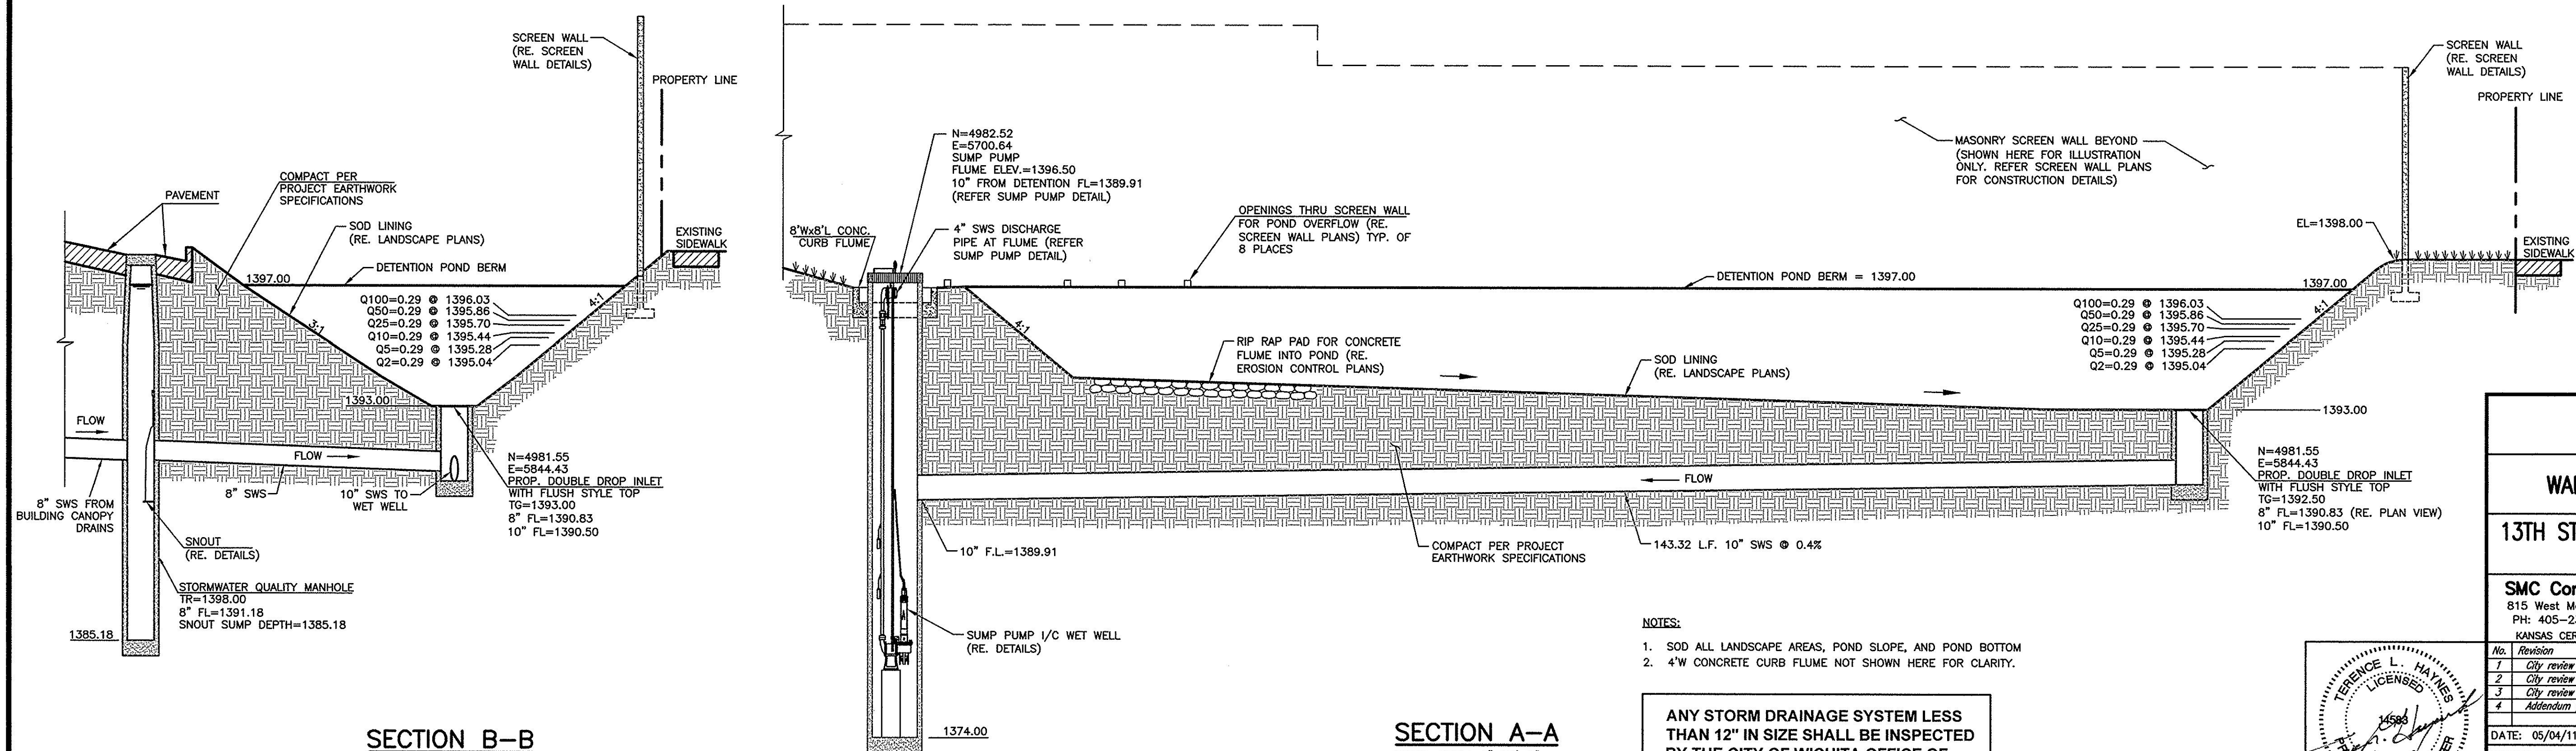

DETENTION POND PLAN			
WALMART MARKET #5873-01			
13TH STREET NORTH & OLIVER AVENUE WICHITA, KANSAS			
SMC Consulting Engineers, P.C.			
815 West Main - Oklahoma City, OK 73106			
PH: 405-232-7715 Fax: 405-232-7859			
KANSAS CERTIFICATE OF AUTHORIZATION NO. E-335 EXP. DEC. 2011			
No.	Revision	By	Date
1	City review comments	MDS	08/28/11
2	City review comments	MDS	07/20/11
3	City review comments	MDS	08/12/11
4	Addendum #1 - SMC review comments	MDS	08/26/11
DATE: 05/04/11		SHEET NO.	
DRAWN BY: TN		C-9.6	
PROJECT NO.: 4936.30		ENGINEER: TERENCE L. HAYNES, P.E. #14583	