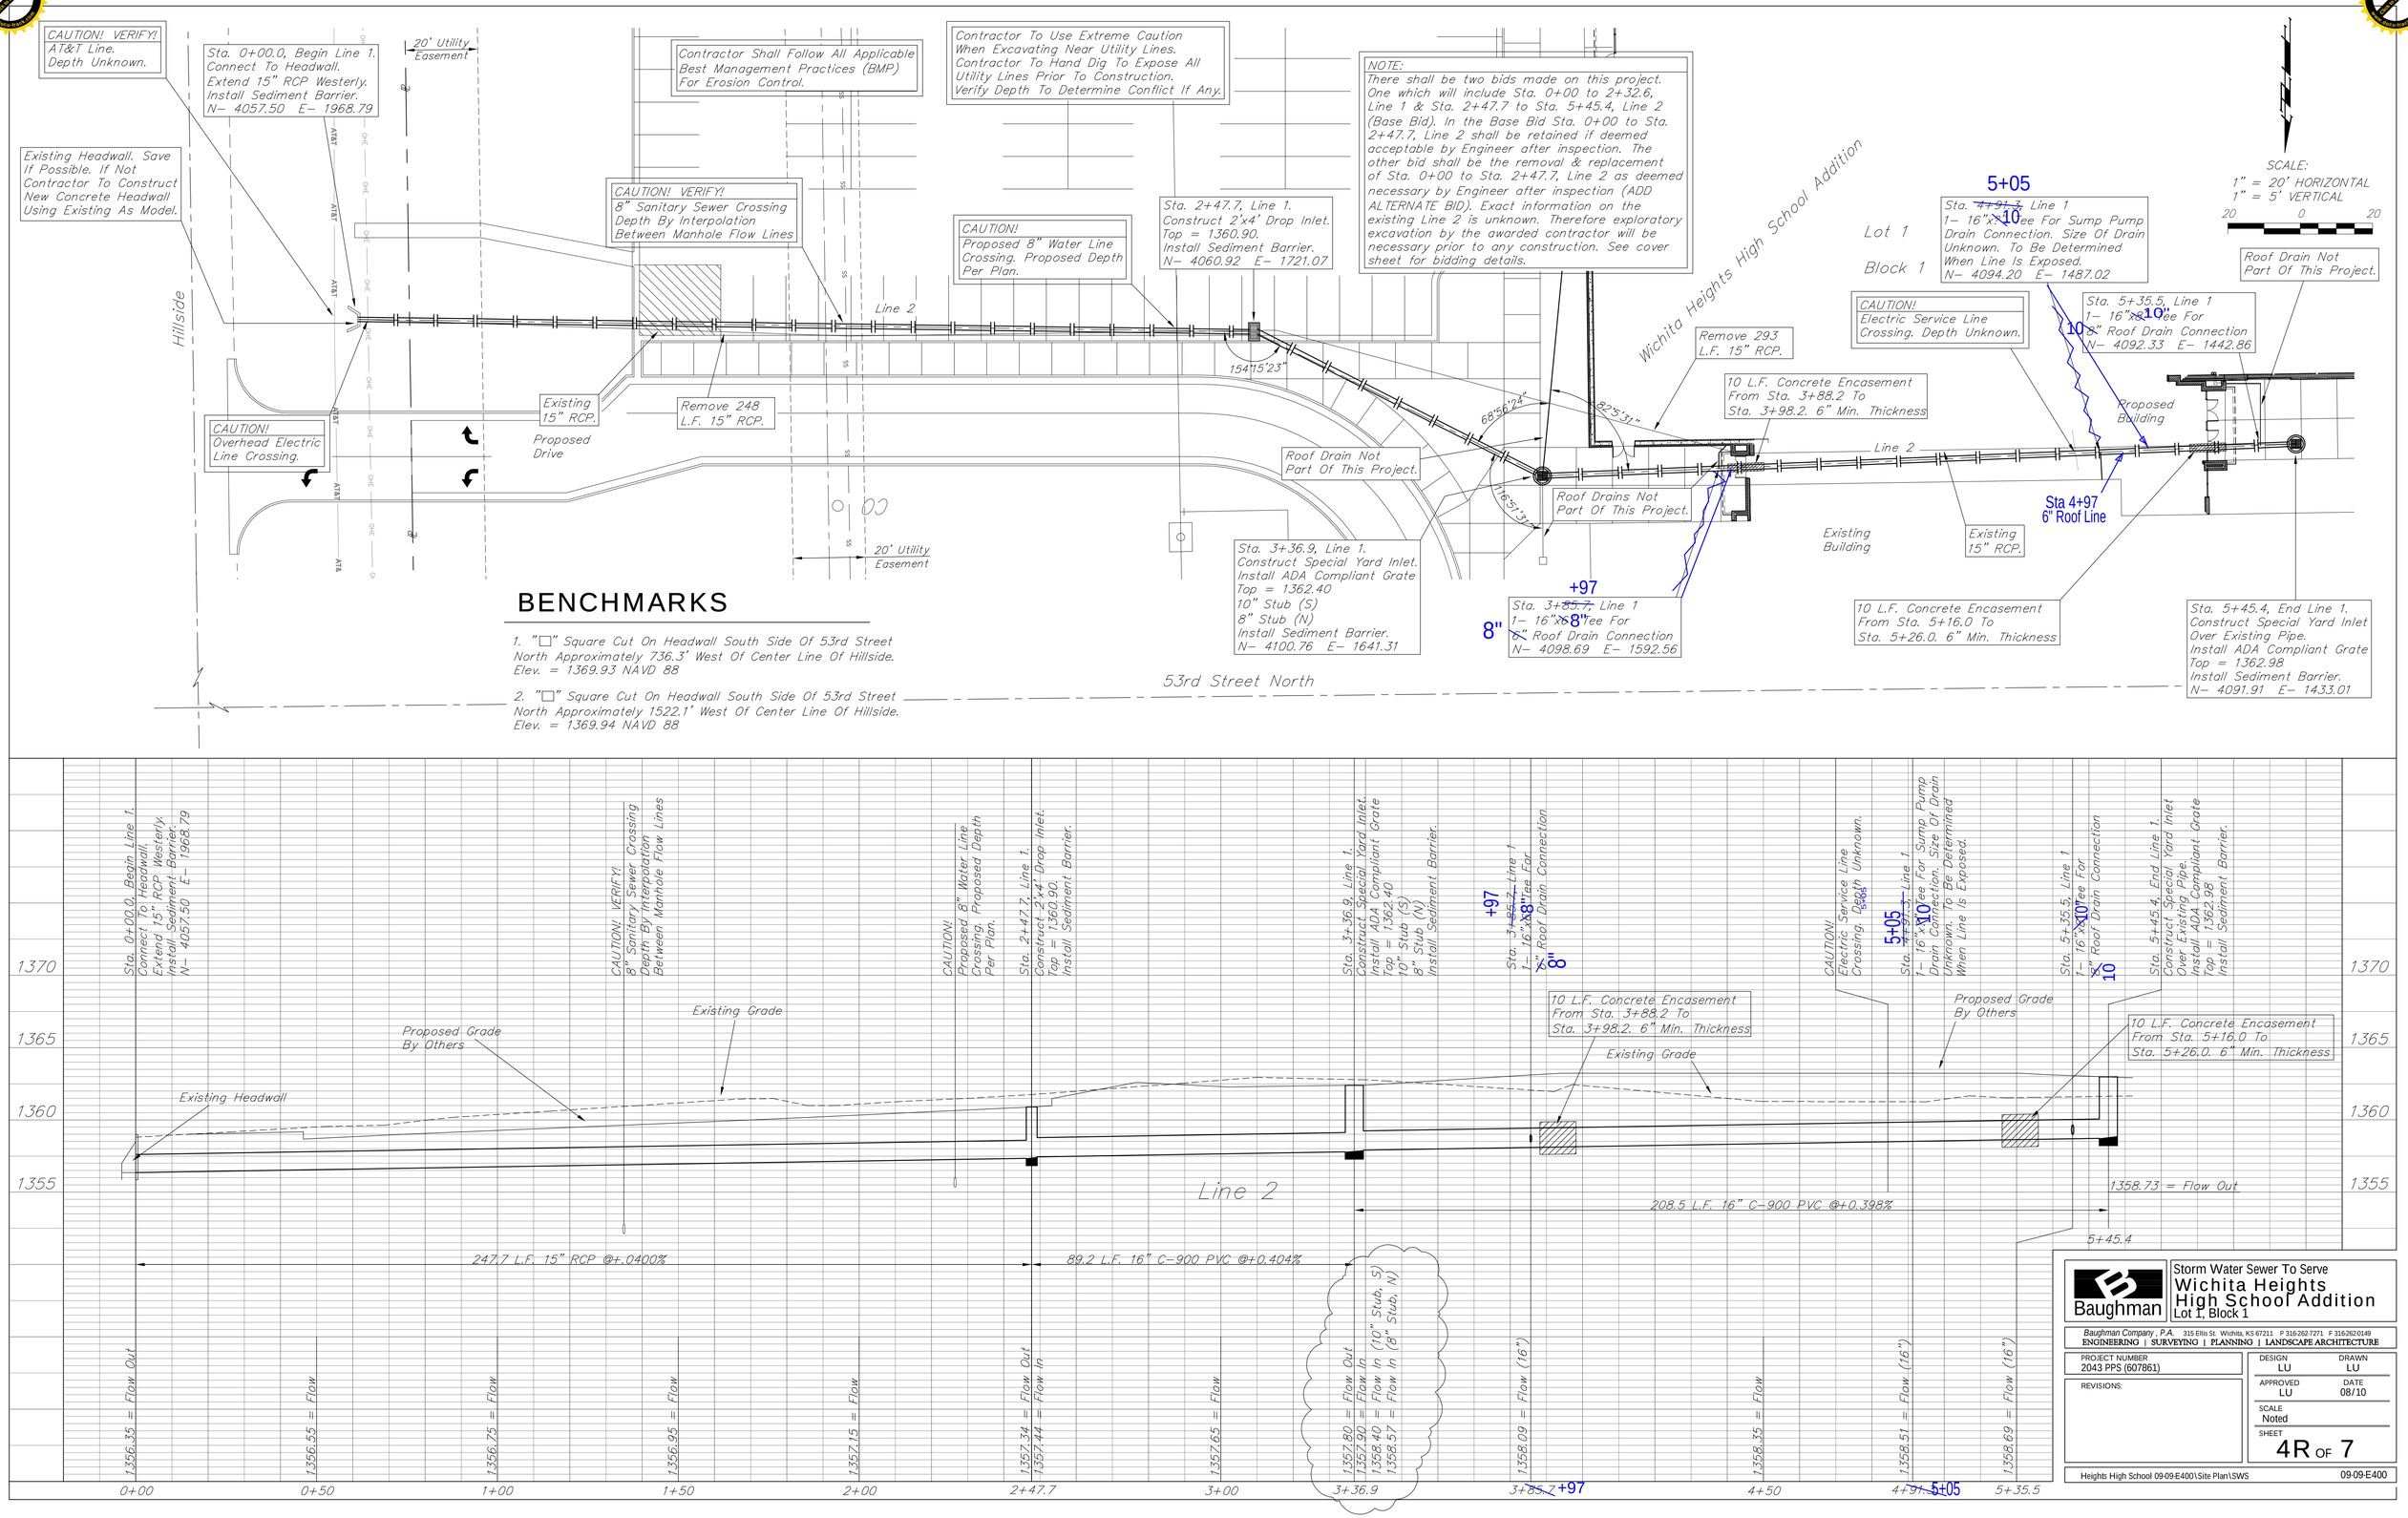

Baughman

Storm Water Sewer To Serve
Wichita Heights High School Addition
Lot 1, Block 1

Baughman Company, P.A. 315 Ellis St. Wichita, KS 67211 P 316.262.7271 F 316.262.0149
ENGINEERING | SURVEYING | PLANNING | LANDSCAPE ARCHITECTURE

PROJECT NUMBER 2043 PPS (607861)	DESIGN LU / DRAWN LU
REVISIONS:	APPROVED LU / DATE 08/10
	SCALE Noted
	SHEET 4R OF 7

Heights High School 09-09-E400\Site Plan\SWS 09-09-E400