
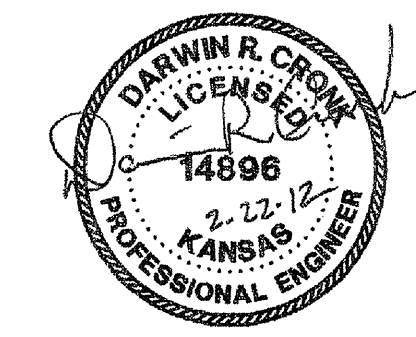


See Sh. No. C022 for Section A-A

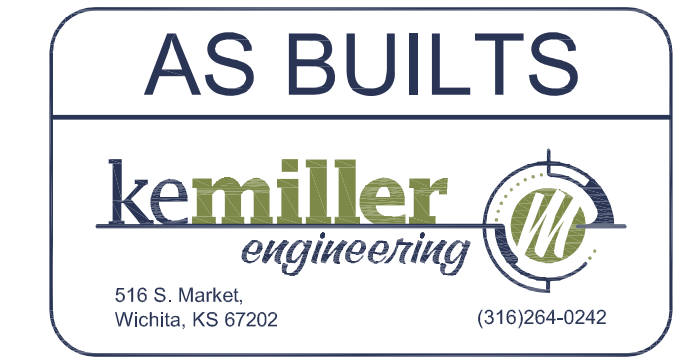

LEGEND

- BC = Back of Curb
- EP = Edge of Pavement
- FL = Flow Line
- Pv = Pavement
- SW = Sidewalk
- TC = Top of Curb
- TW = Top of Wall

THE WICHITA AIRPORT AUTHORITY
MID-CONTINENT AIRPORT
TYLER ROAD LOT
DITCH GRADING PLAN

LEARJET PARKING LOTS
Professional Engineering Consultants, P.A.
303 S. TOPEKA • WICHITA, KANSAS 67202
316-262-2691 • FAX 316-262-3003
Date JANUARY 2012 Job No. 11394-004

Sheet 02-15-2012 10:20:53 AM BY DILL
 Plot Scale 1:1 02-23-2012 4:12:35 PM by CHIEF L. McDONALD
 F:\2011\11394\004\Draw\plans\11394-004-006.dwg