


PLAN	CHECKED	DATE
	CHECKED	

PROFILE	CHECKED	DATE
	CHECKED	

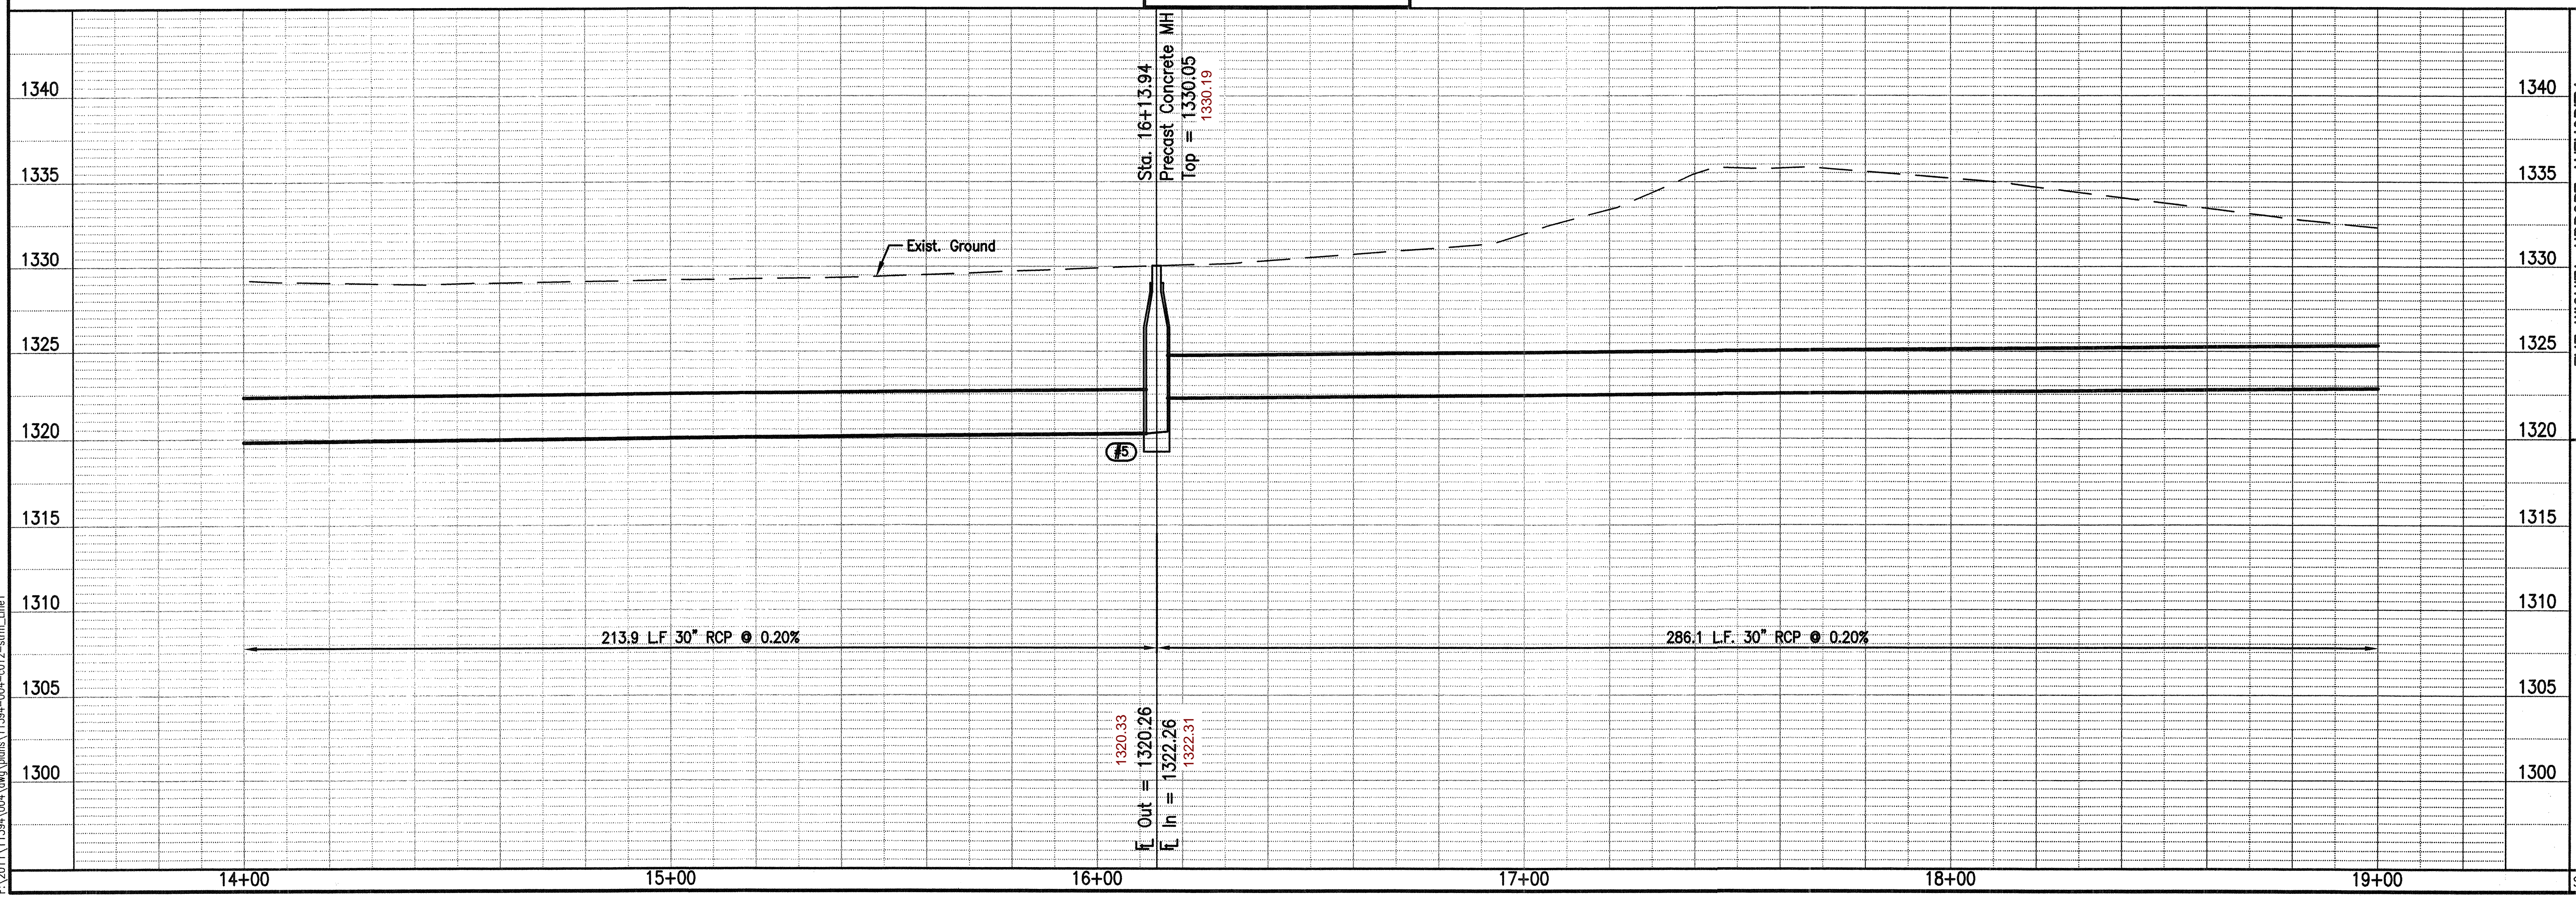

THE WICHITA AIRPORT AUTHORITY
MID-CONTINENT AIRPORT
STORM SEWER LINE 1
LEARJET PARKING LOTS

Professional Engineering Consultants, P.A.
803 S. TOPBEKA • WICHITA, KANSAS 67202
316-265-2691 • FAX 316-265-3003

Job No. 11394-004
Date Oct. 2011

Designed By DMR
Drawn By DJL

Saved 01-13-2012 11:46:27 AM by DMS
Plot Scale 1:1 02-22-2012 11:06:33 AM by CJET L. MCDONALD
P:\2011\11394\004\Drawings\11394-004-012-smc.dwg