SHEET NO.	TOTAL SHEETS
C019	–

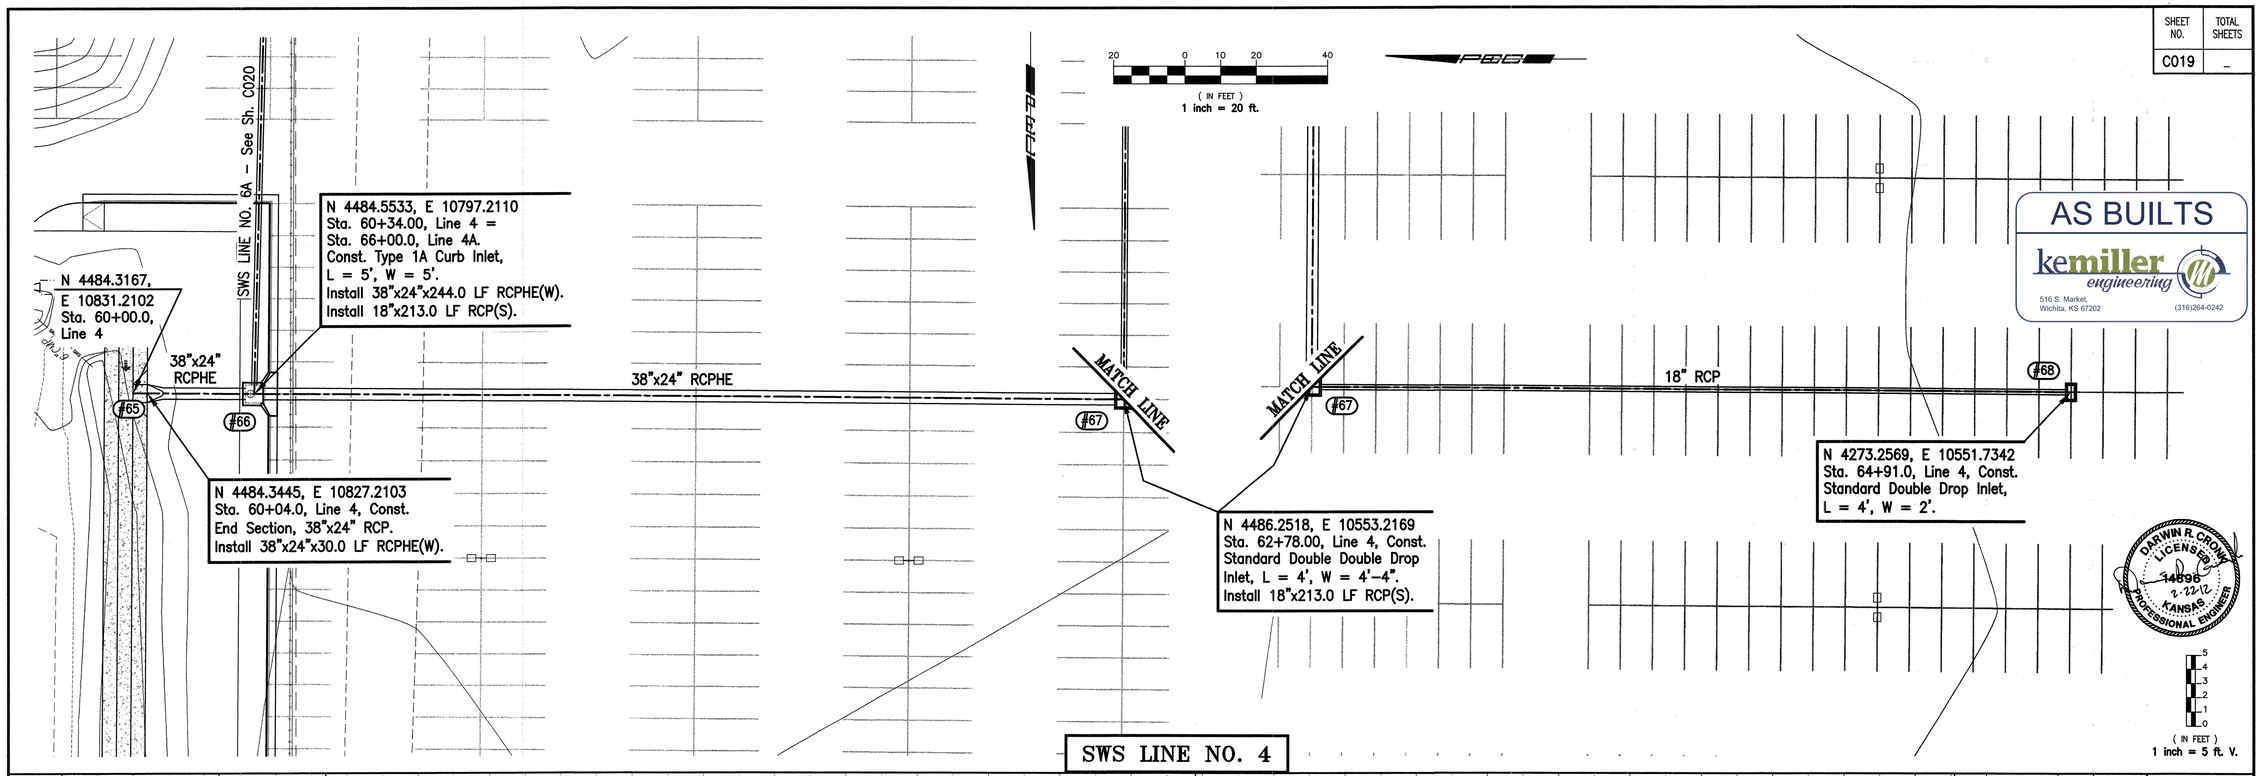

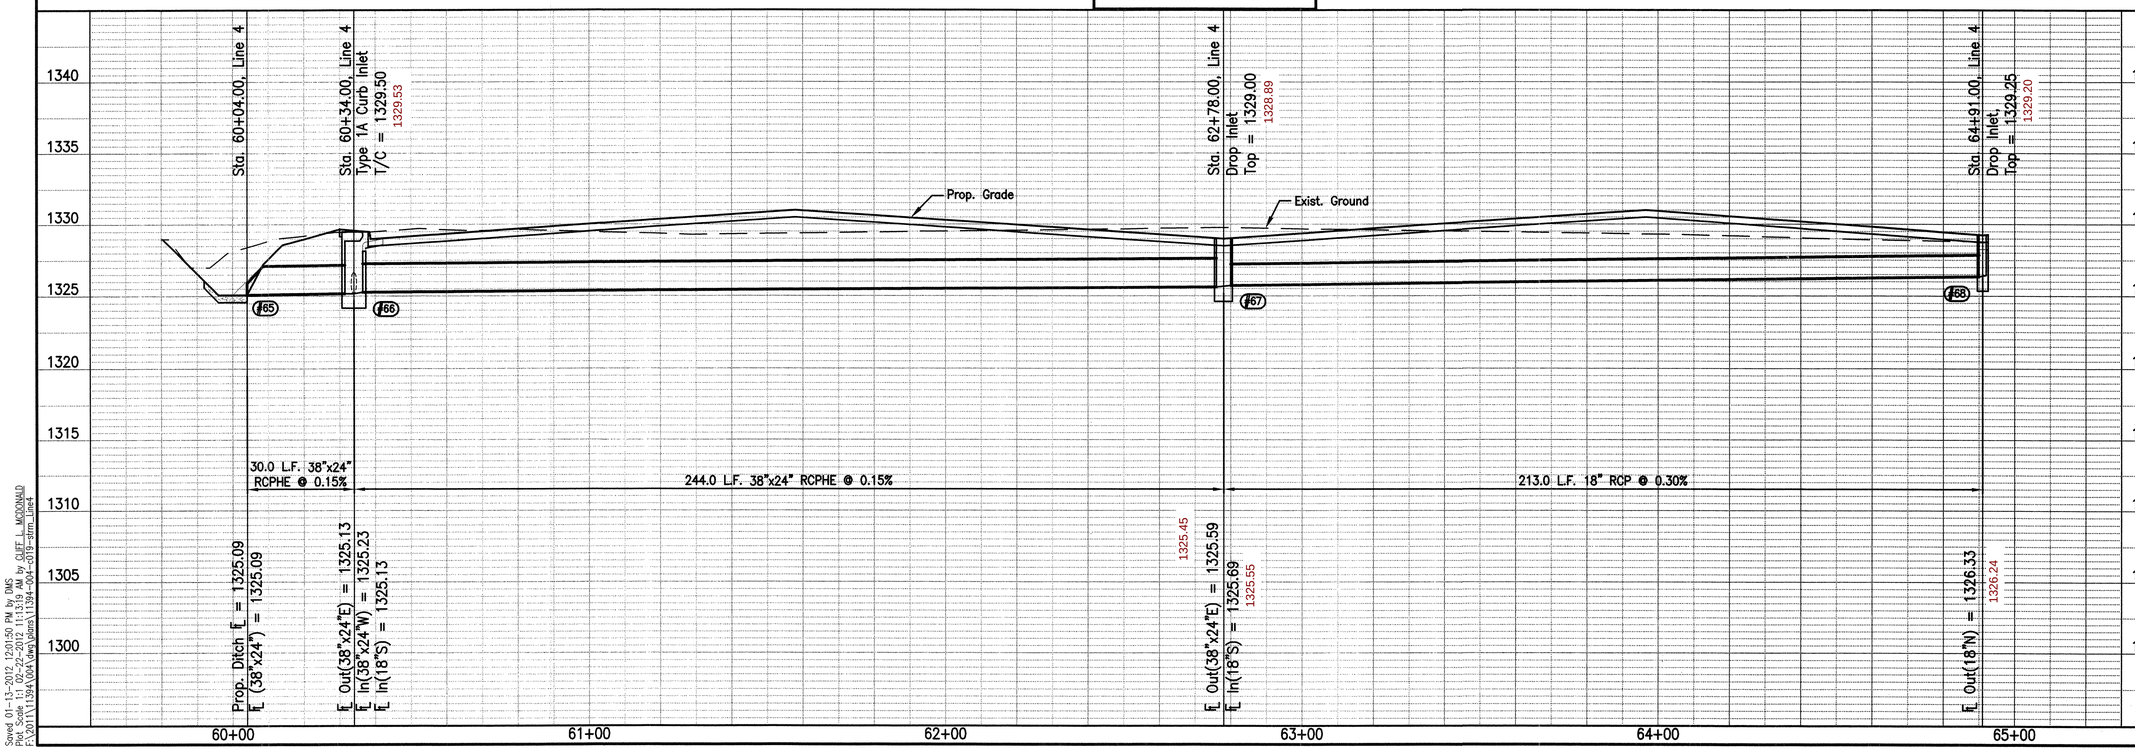

PLAN	BY	DATE
CHECKED		
CHECKED		

PROFILE	BY	DATE
CHECKED		
CHECKED		

Saved 01-13-2012 12:01:50 PM by DMS
Plot Scale 1:1 02-22-2012 11:13:19 AM by QUEF_L_MCDONALD
F:\2011\11394\04A\dwg\plans\11394-004-C019-strm_Line4

THE WICHITA AIRPORT AUTHORITY
MID-CONTINENT AIRPORT
STORM SEWER LINE 4
LEARJET PARKING LOTS

Professional Engineering Consultants, P.A.
303 S. TOPEKA • WICHITA, KANSAS 67202
316-262-2691 • FAX 316-262-3003

Designed By DAR
Drawn By DJL
Job No. 11394-004
Date Oct. 2011
Sheet of --