

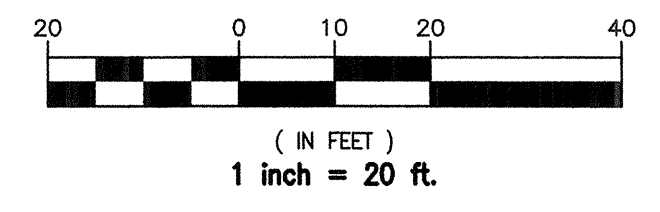





DATE	BY	CHECKED	CHECKED
		PLAN	

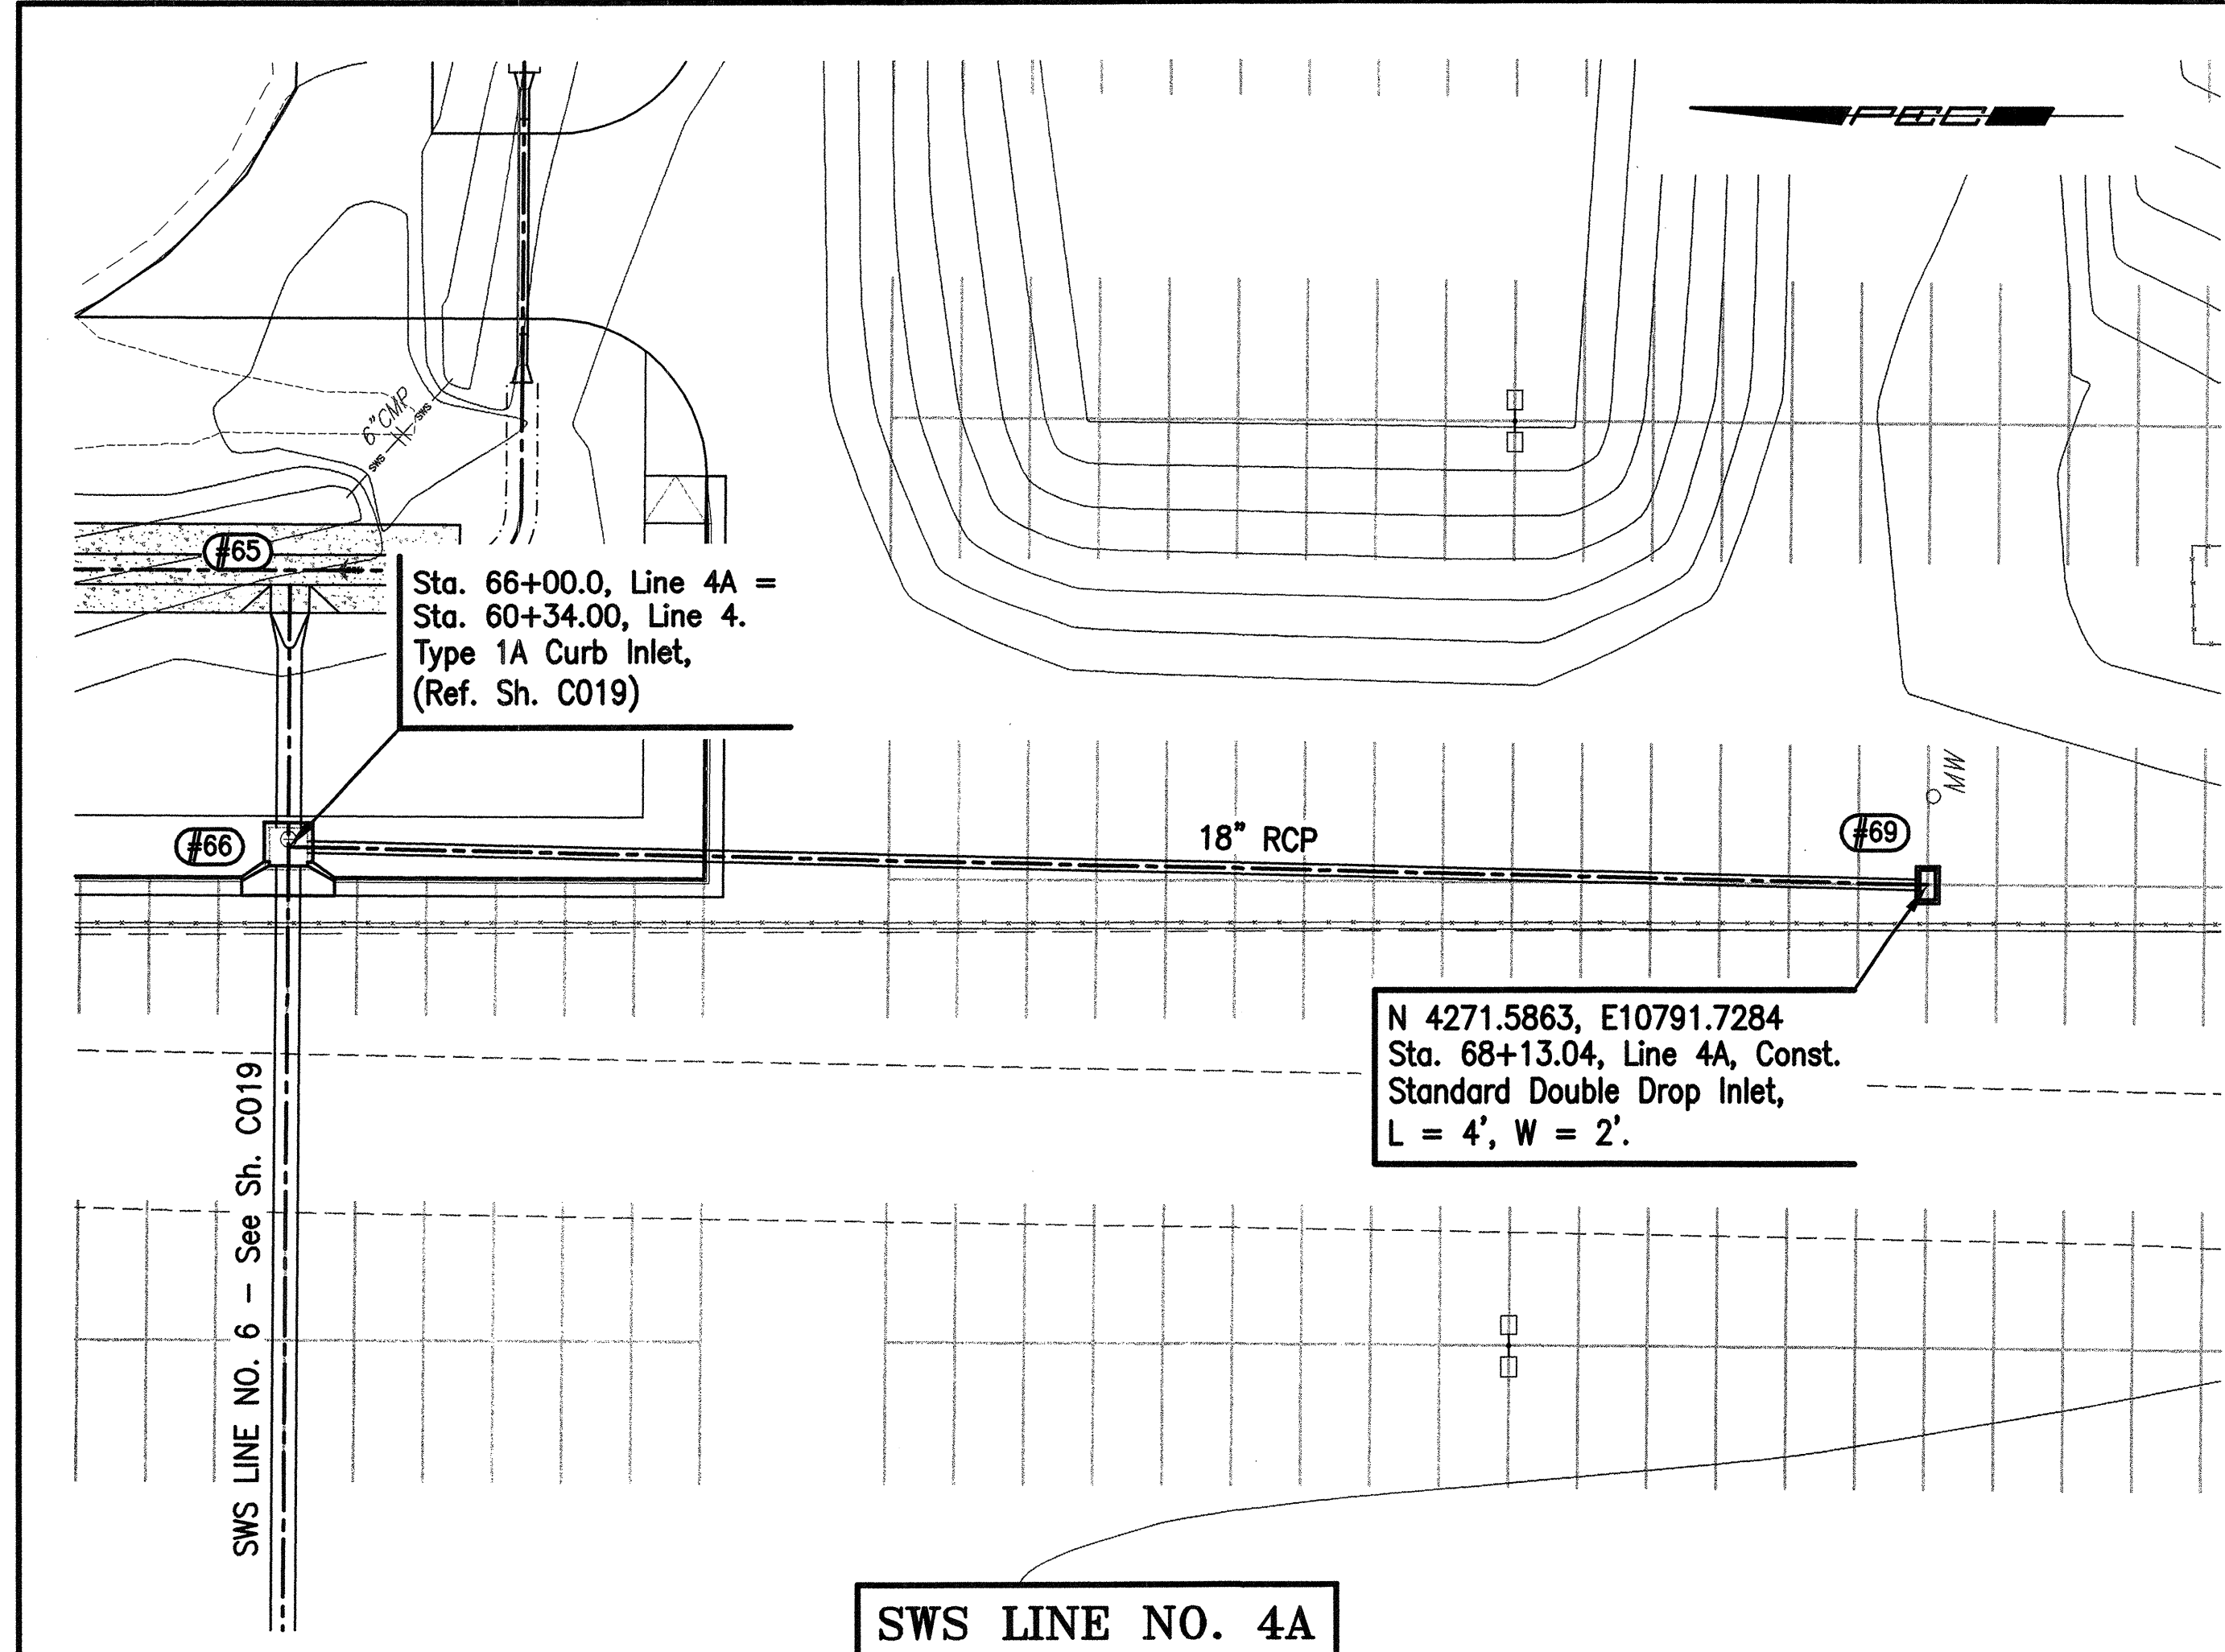

DATE	BY	CHECKED	CHECKED
		PROFILE	

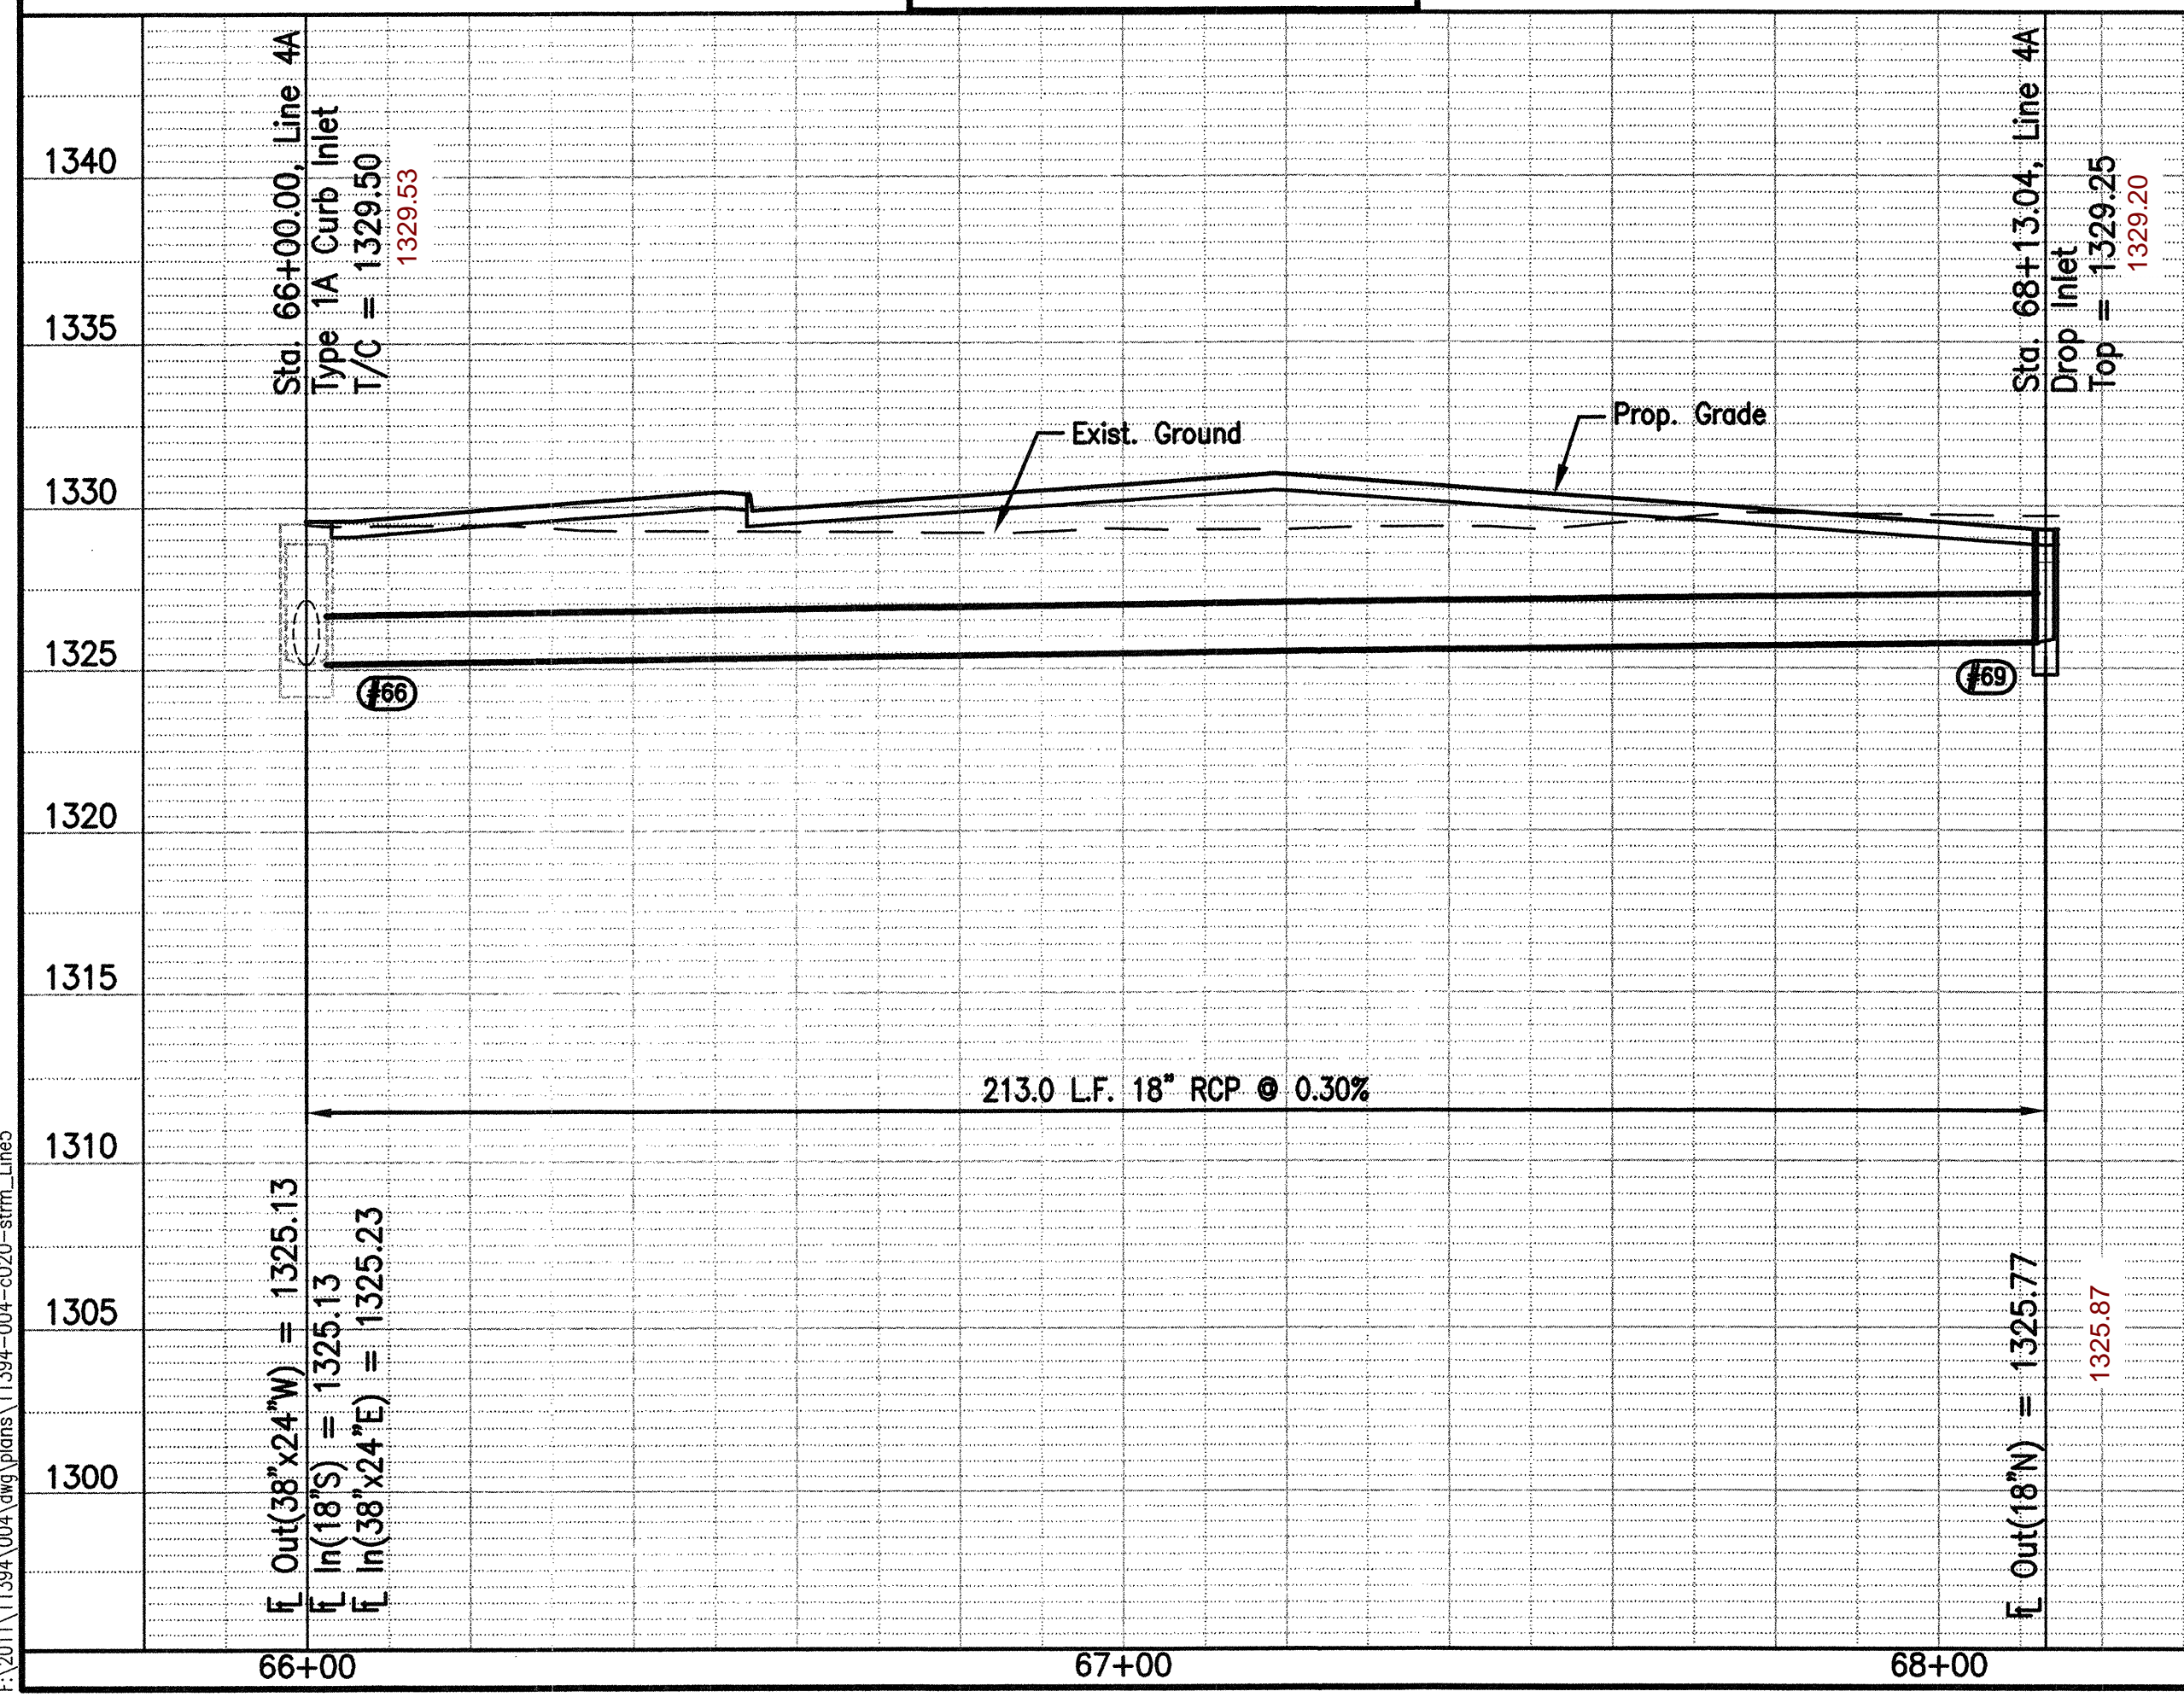

SWS LINE NO. 5

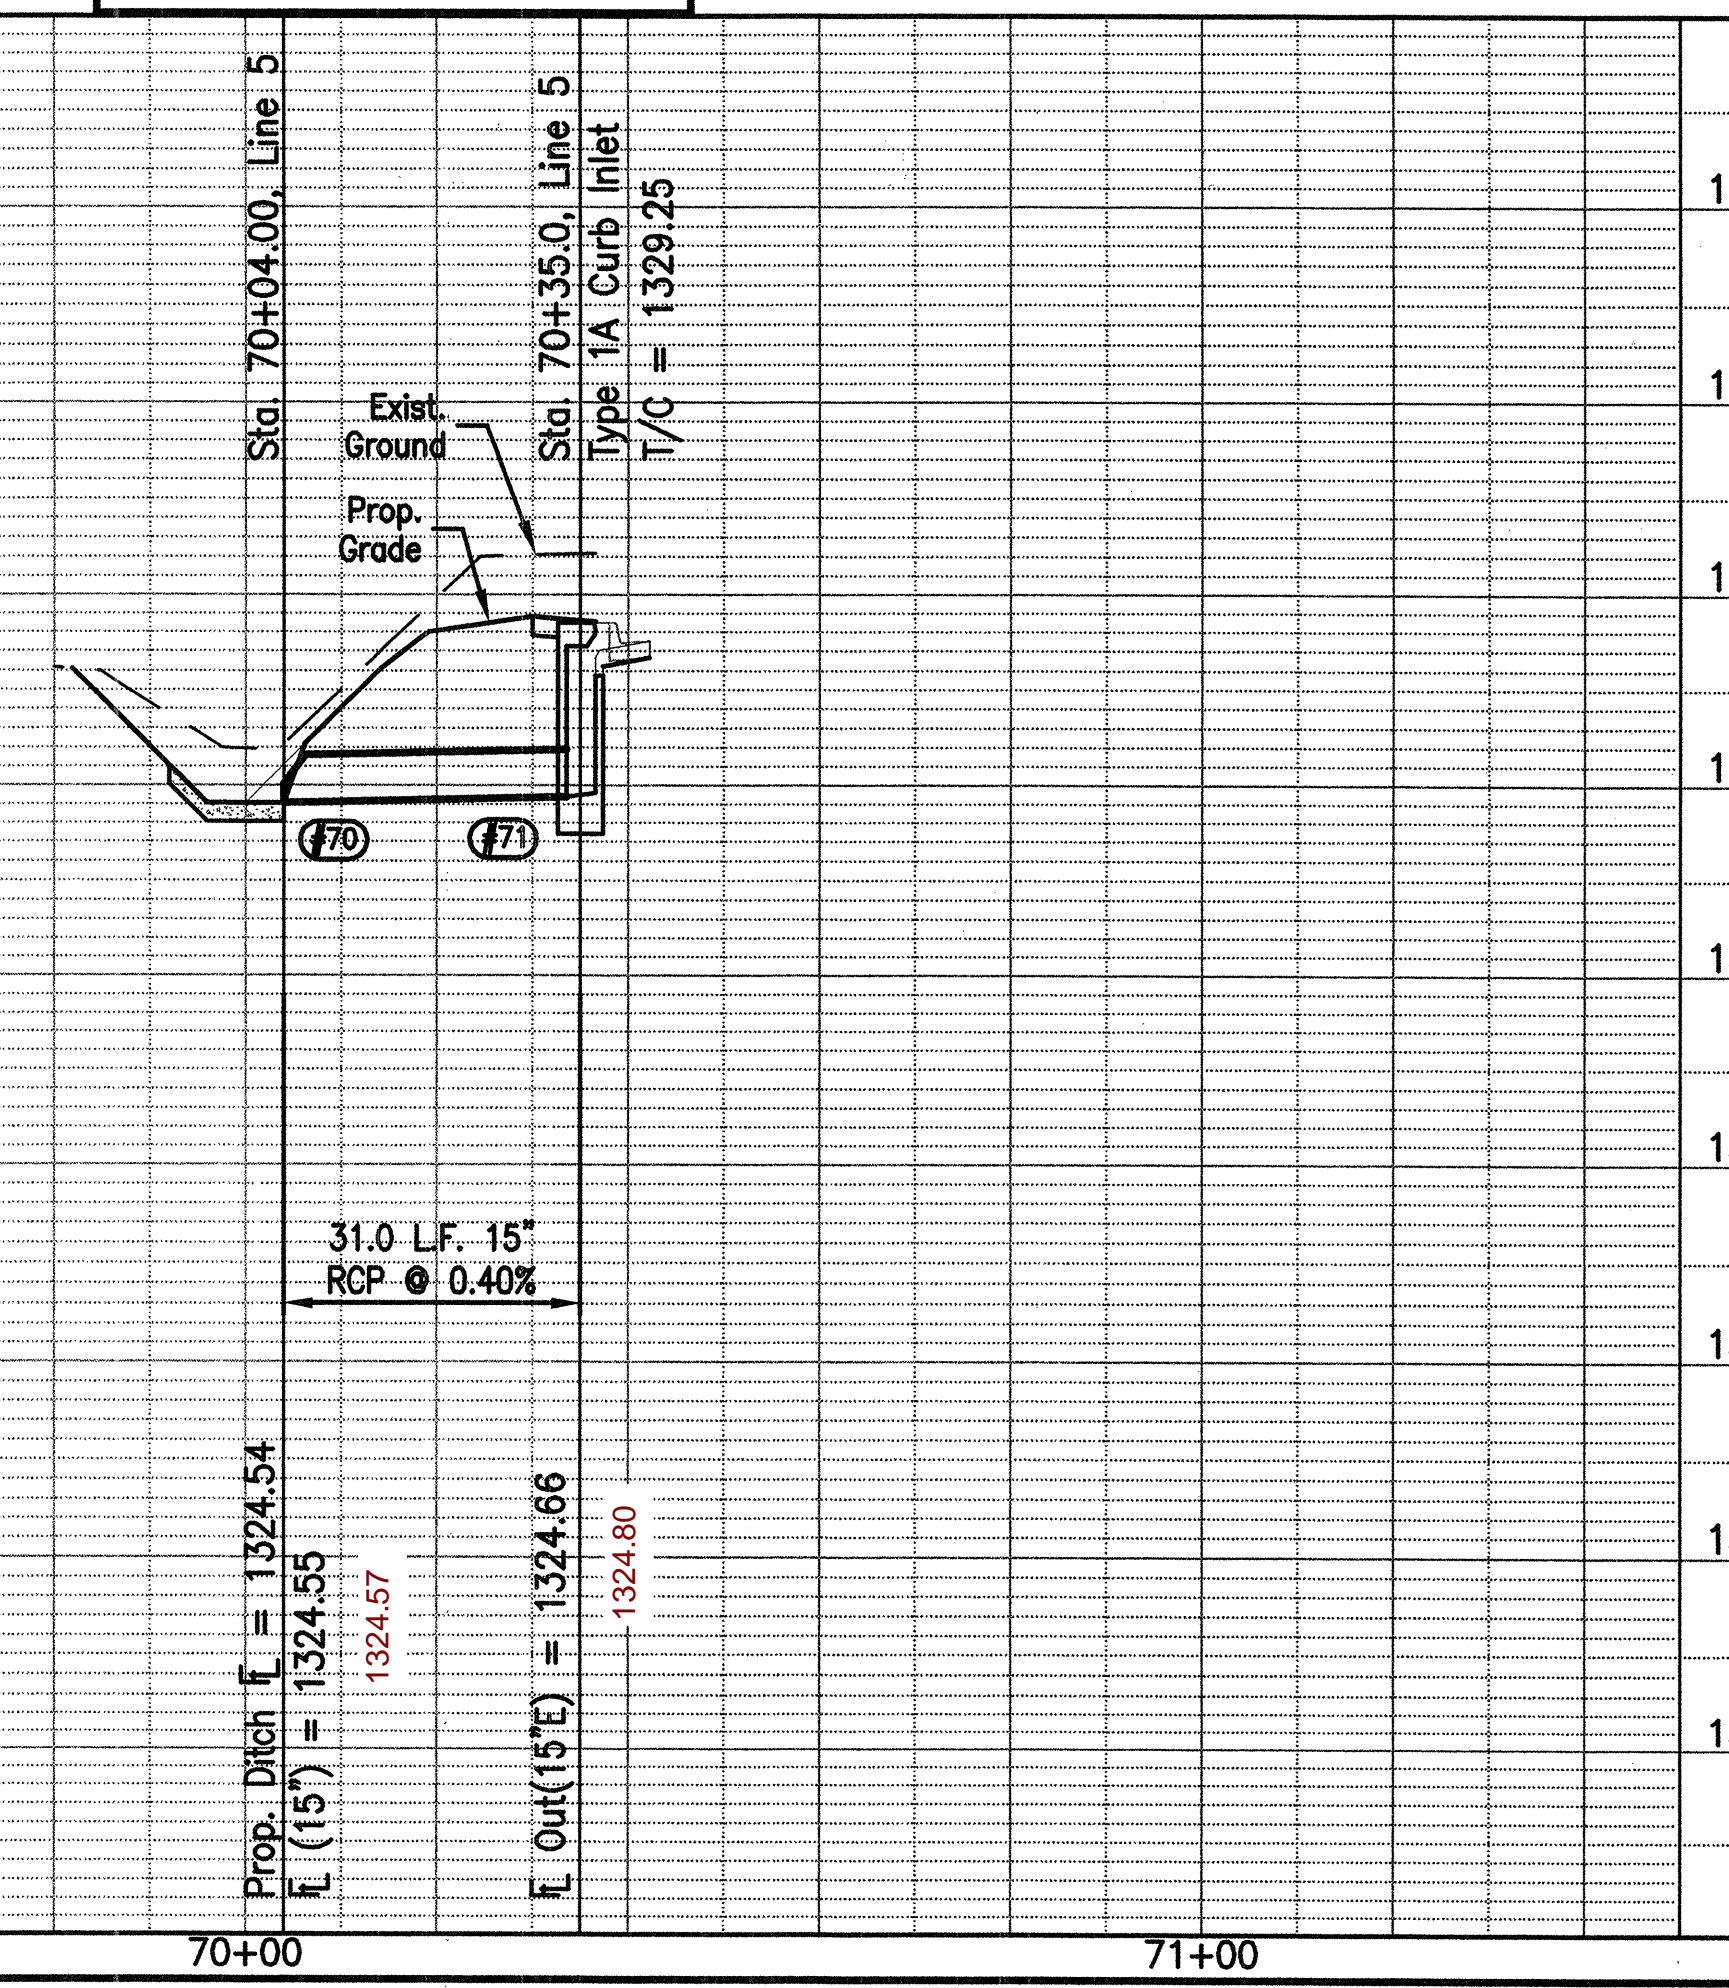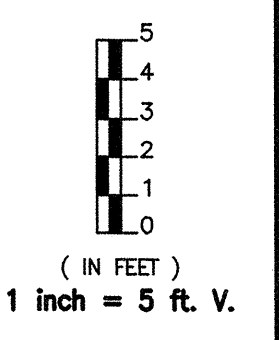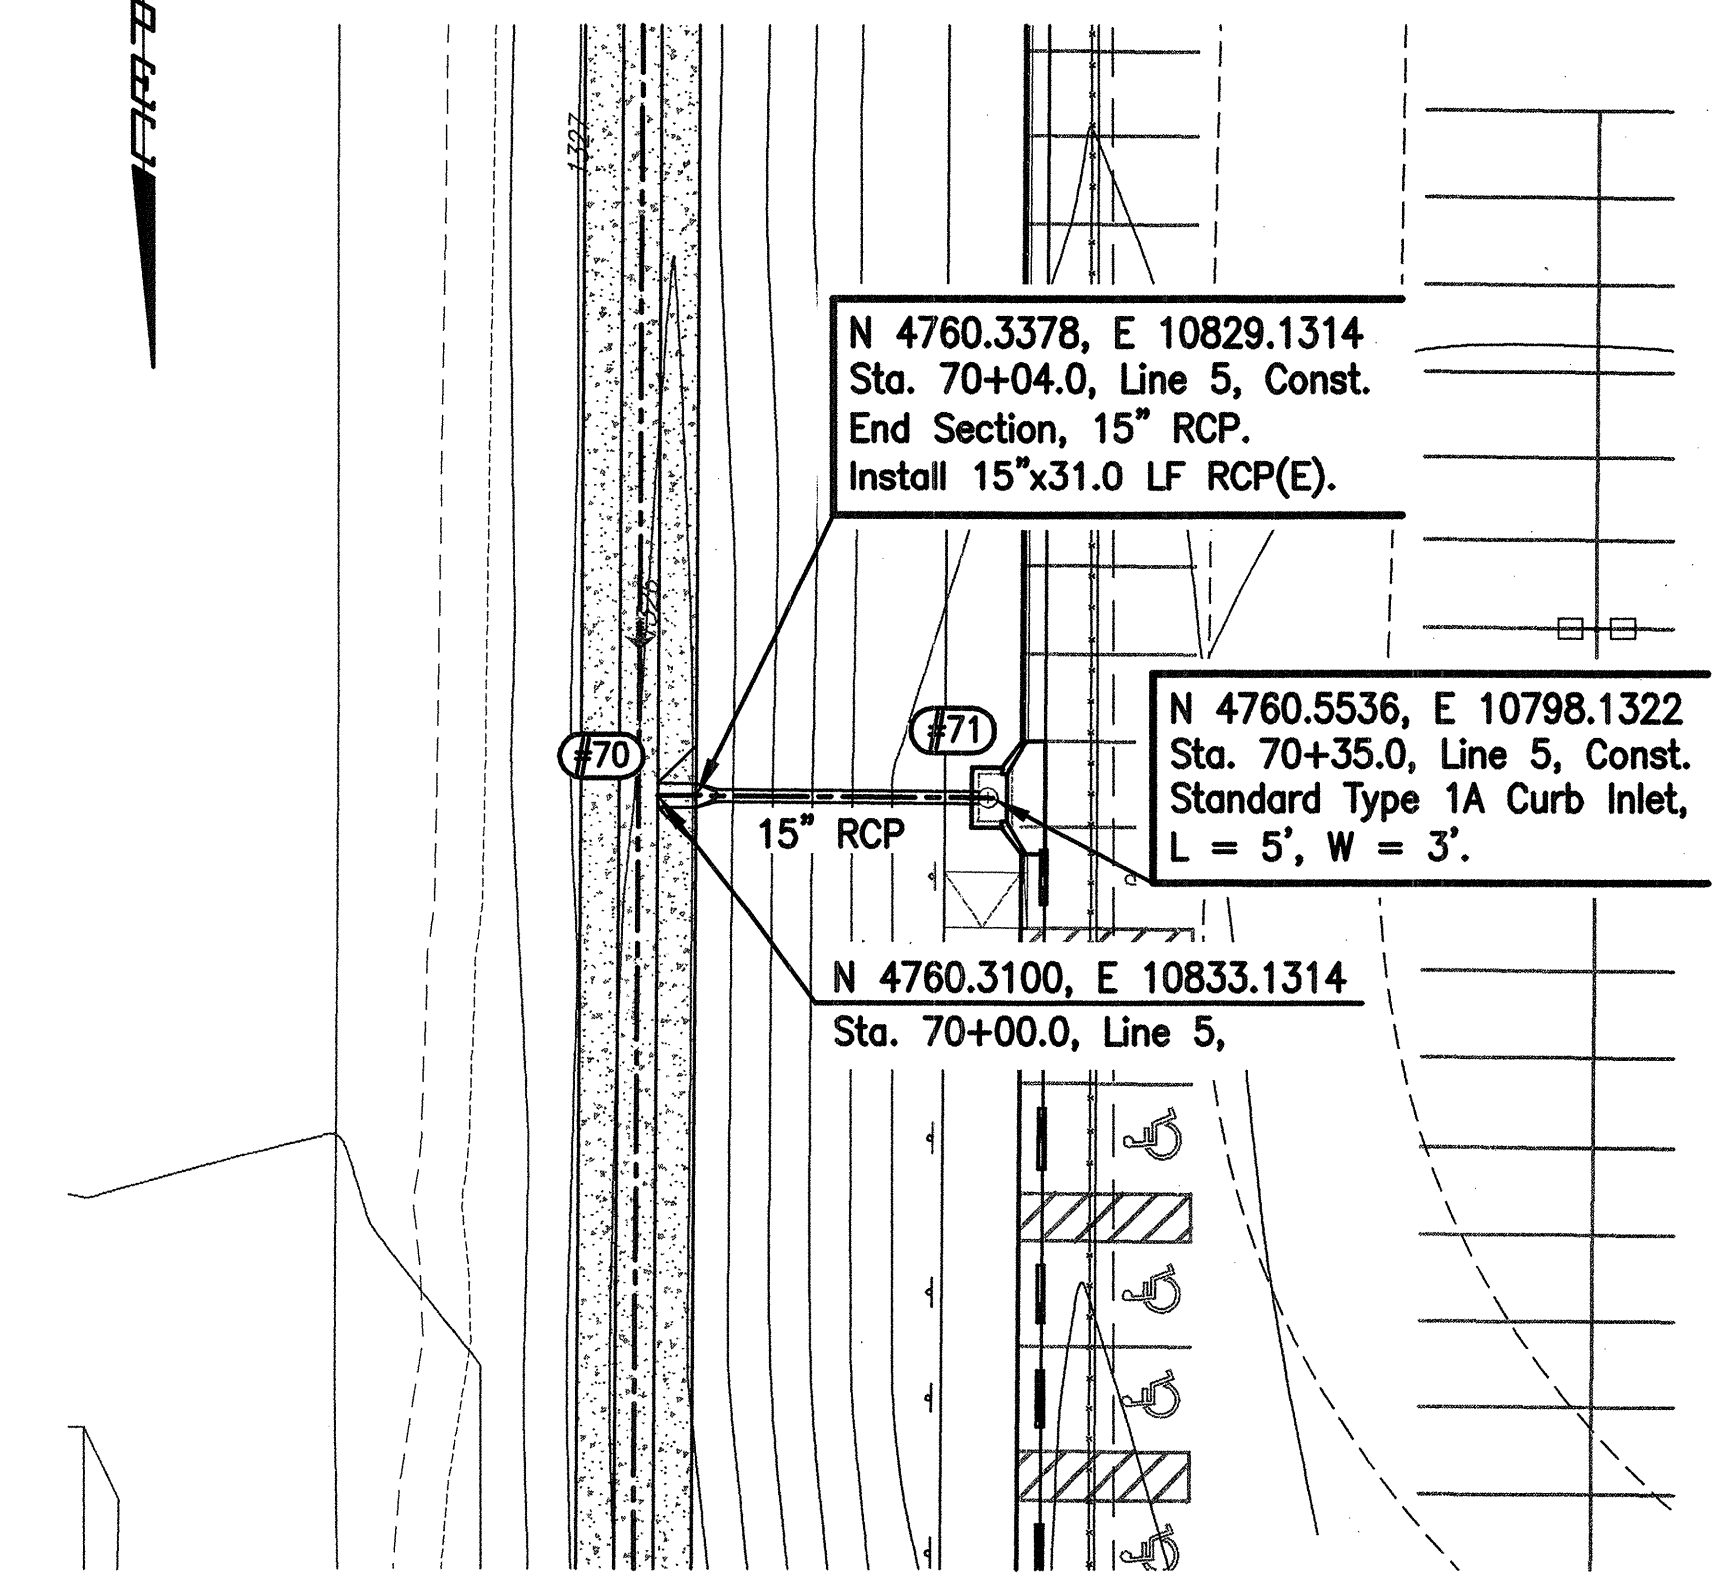

Save: 01-13-2012 12:04:41 PM by DMS
Plot Scale: 1:1 02-22-2012 11:03:43 AM by GUFF, L. WOODWARD
P:\2011\1394-004\eng\plans\1394-004-020-stm-1.ln

Professional Engineering Consultants, P.A.
303 S. TOPICKA • WICHITA, KANSAS 67202
316-262-2691 • FAX 316-262-3003

Job No. 11394-004 Date Oct. 2011

Designed By DAR Drawn By DUL

THE WICHITA AIRPORT AUTHORITY
MID-CONTINENT AIRPORT
STORM SEWER LINES 4A & 5
LEARJET PARKING LOTS

