



**SANITARY SEWER PLANS FOR  
GREENWICH BUSINESS CENTER  
PHASE 1**

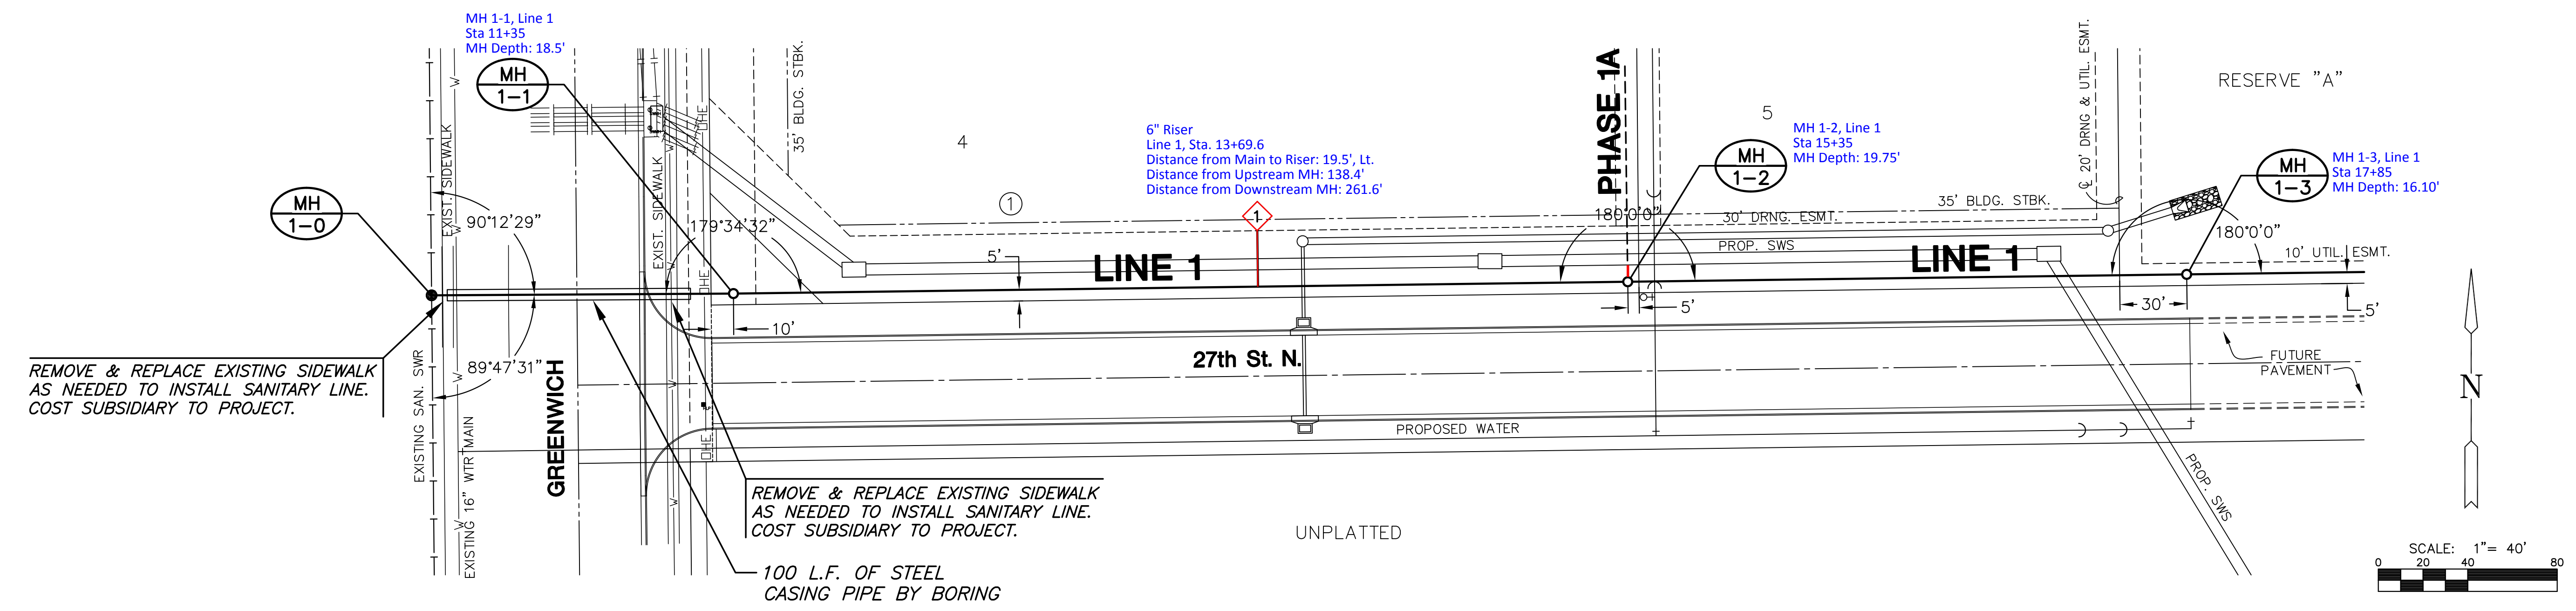

**PLAN LINE 1  
PROFILE LINE 1**

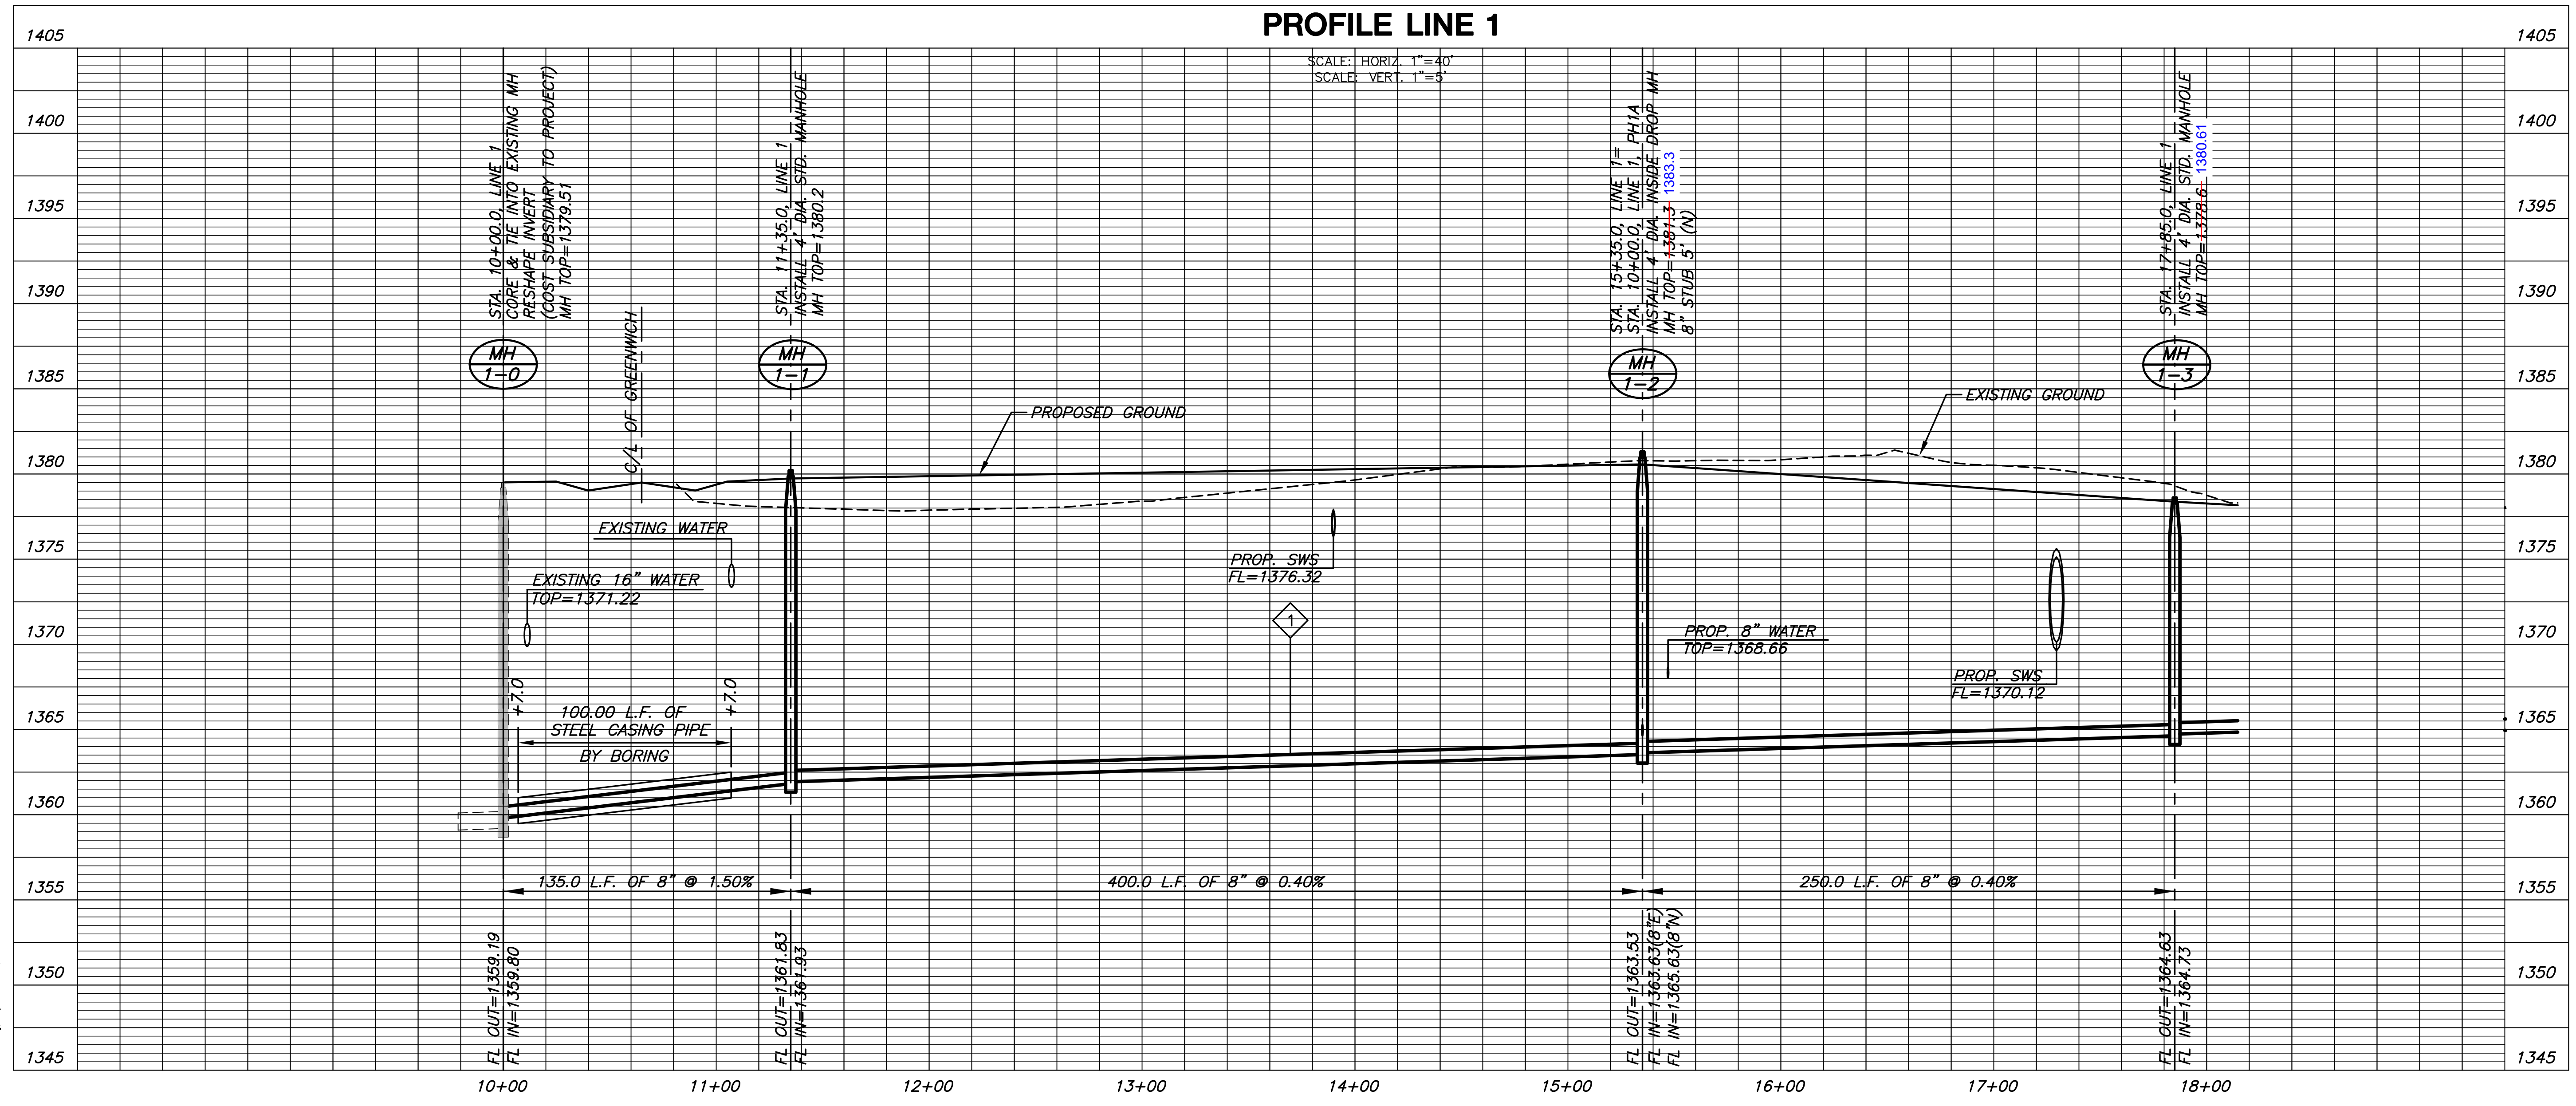

**LINE 1**  
SHEET TITLE  
**468-84742**  
PROJECT NUMBER

DFL / JWC / GJA  
DESIGNED / DRAWN / CHECKED

ISSUED  
**September 2011**  
REVISED

SHEET NO.  
**4 of 12**

PLOT DATE: Wednesday, September 14, 2011 @ 10:03 AM

J:\CIVIL\050389\JWC\CIVIL\3D\SAN\050389\_B1.DWG