


PLAN LINE 1
PROFILE LINE 1

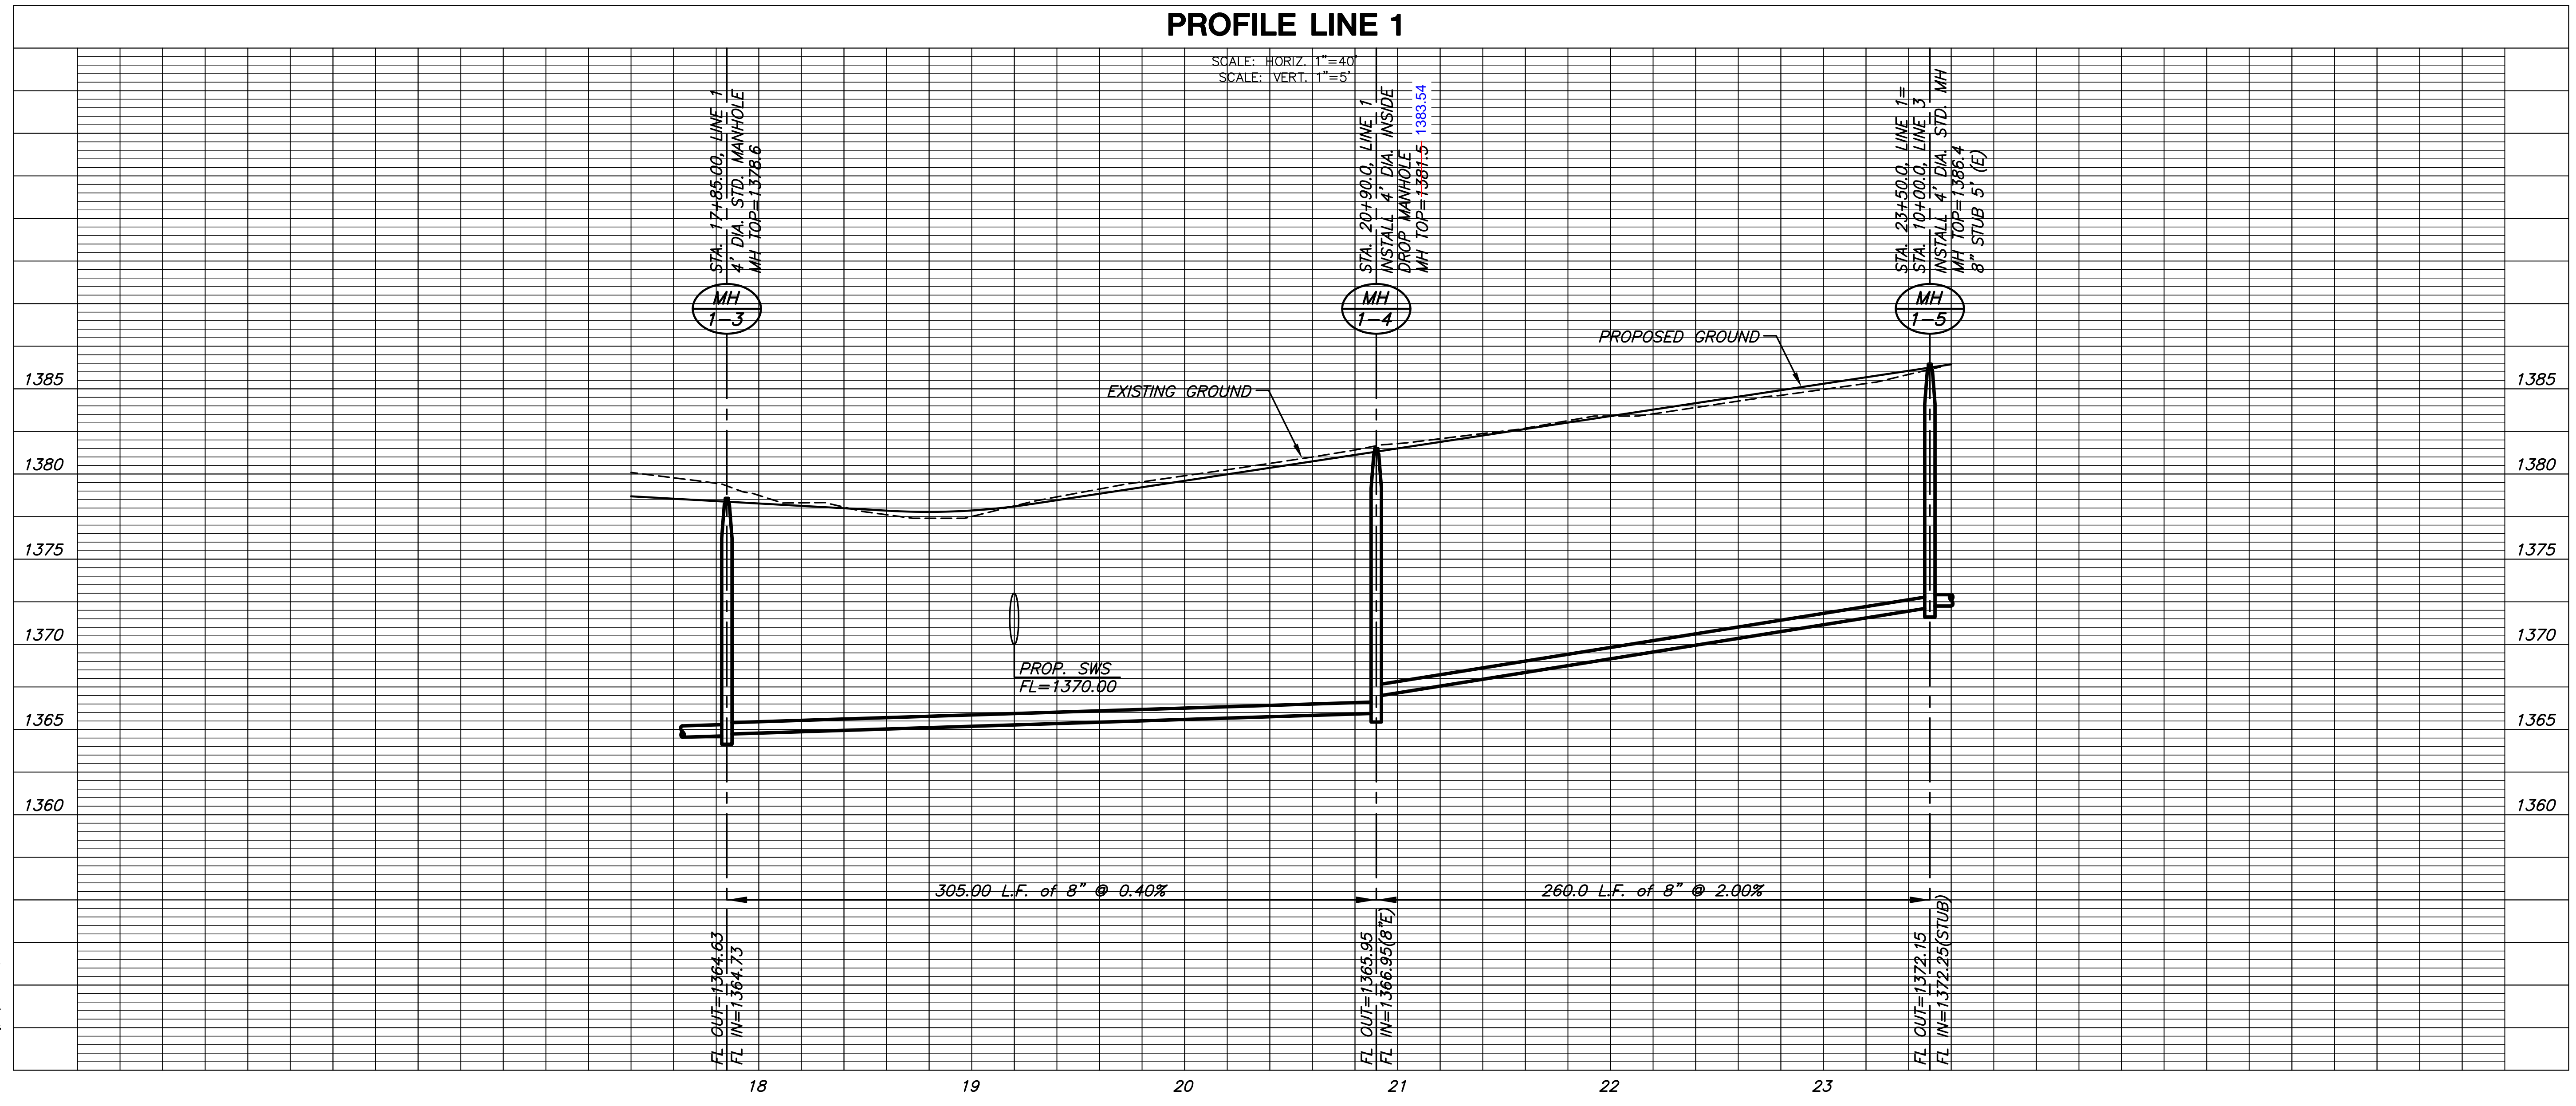

SANITARY SEWER PLANS FOR
GREENWICH BUSINESS CENTER
PHASE 1

LINES 1, 2, & 3
SHEET TITLE
468-84742
PROJECT NUMBER

DFL / JWC / GJA
DESIGNED / DRAWN / CHECKED

ISSUED
September 2011
REVISED

SHEET NO.
5 of 12