


PLAN LINE 1

PLAN LINE 3

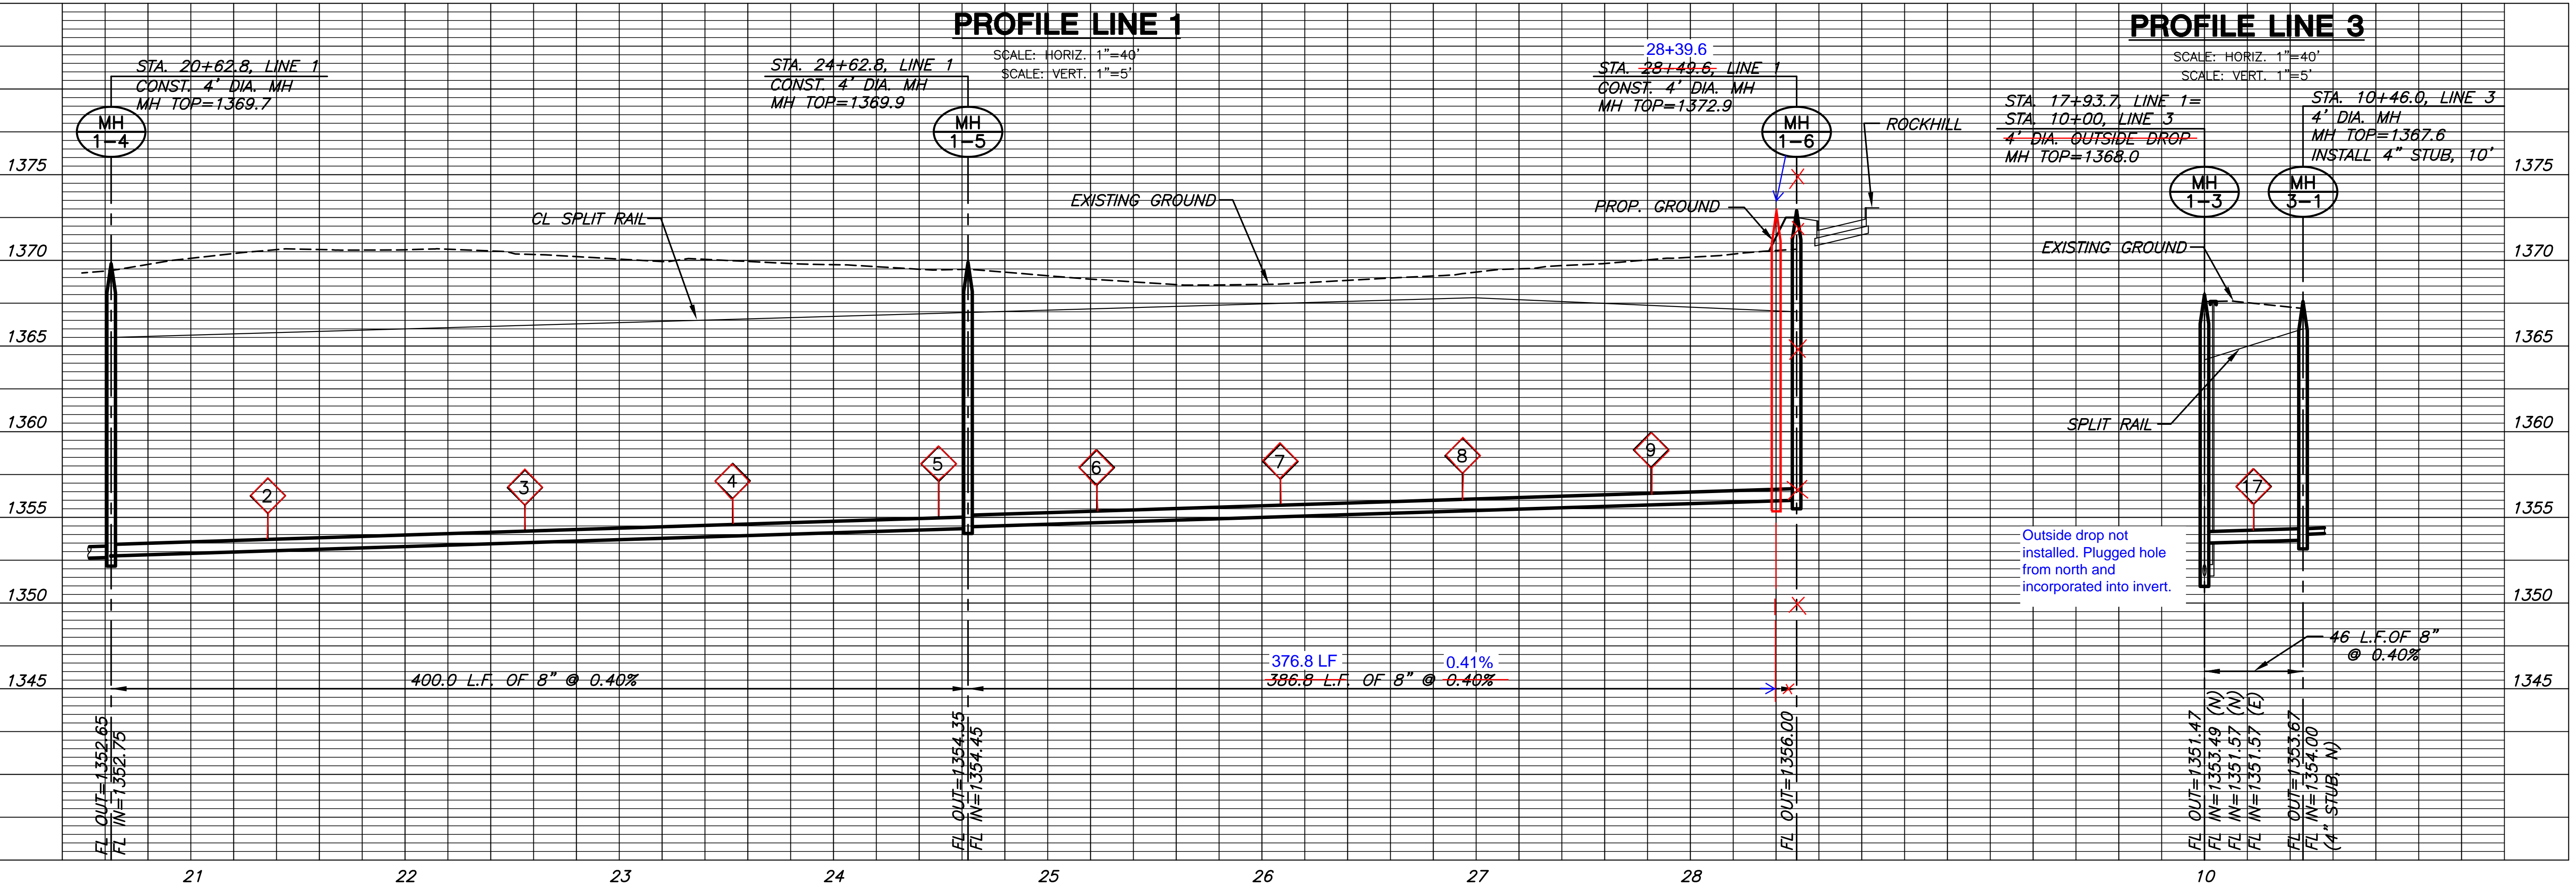

PLOTTER: Tumbler, May 28, 2012 @ 10:02AM

J:\CIVIL\05291\DWG\SAN\PH2_05291_B2.DWG