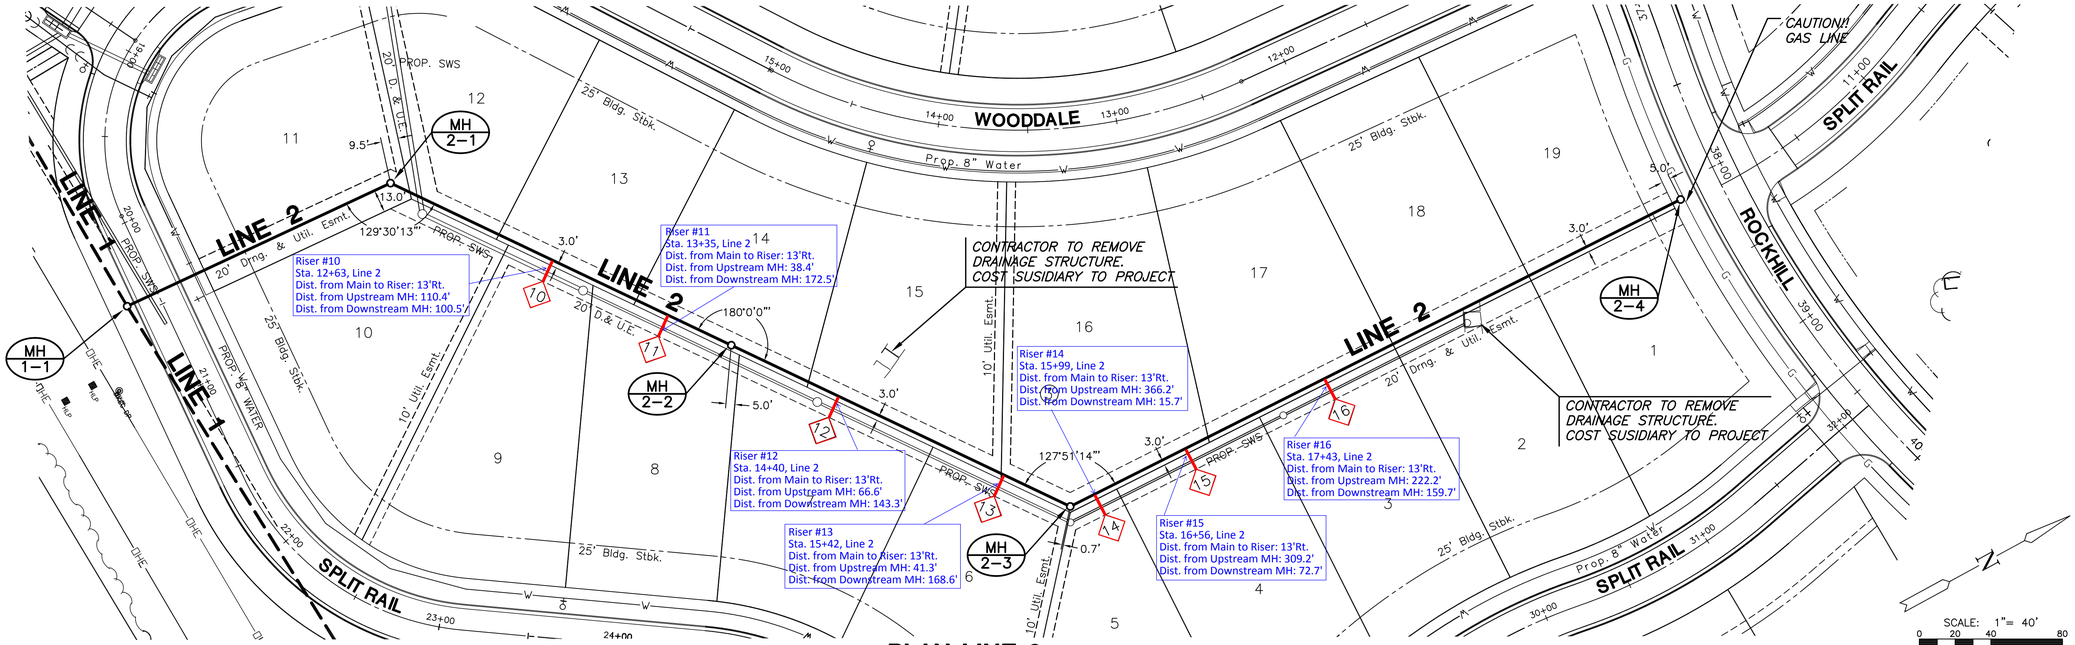

PLAN LINE 2

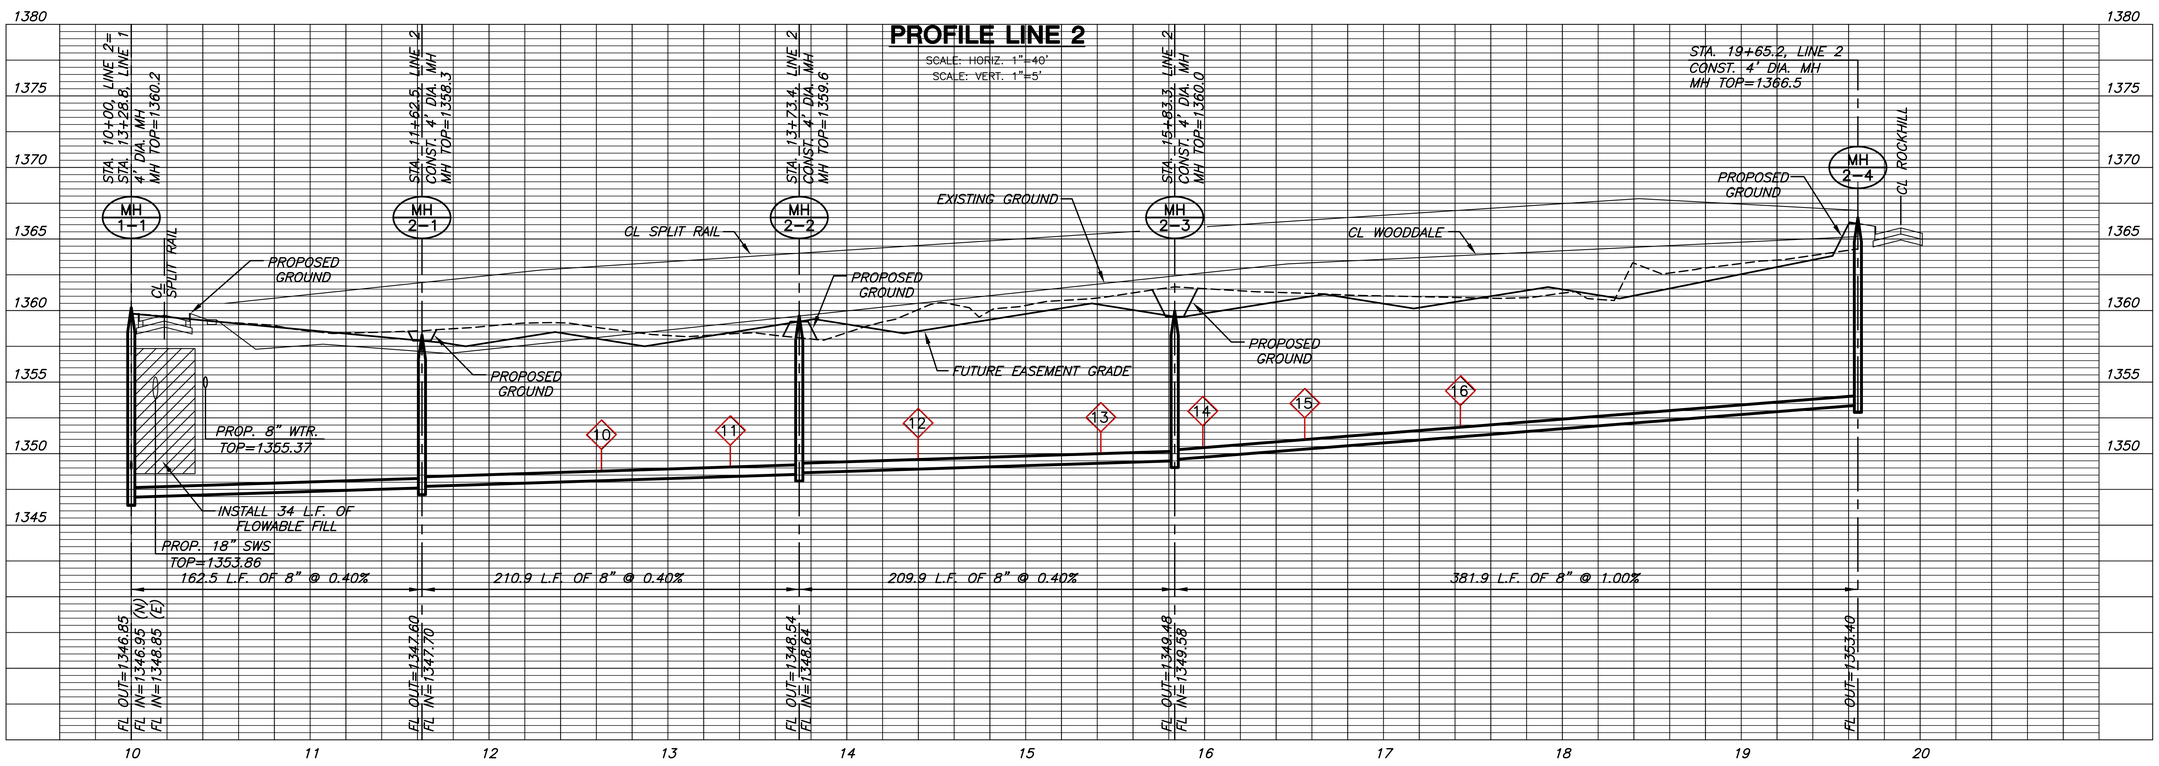

MKEC ENGINEERING CONSULTANTS, INC.
411 N. WEBB ROAD
WICHITA, KS. 67206
316 - 684 - 9600

SANITARY SEWER LATERAL 8, MAIN 14
KRUG SOUTH ADDITION
PHASE 2

LINE 2
SHEET TITLE

468-84322
PROJECT NUMBER

DFL / KKL / GJA
DESIGNED / DRAWN / CHECKED

ISSUED
May 2012

REVISED

SHEET NO.
7 of 16

J:\CIVIL\05291\DWG\SAN\PH2\05291_B3.DWG

PLOTTED: Tuesday, May 29, 2012 @ 10:03AM