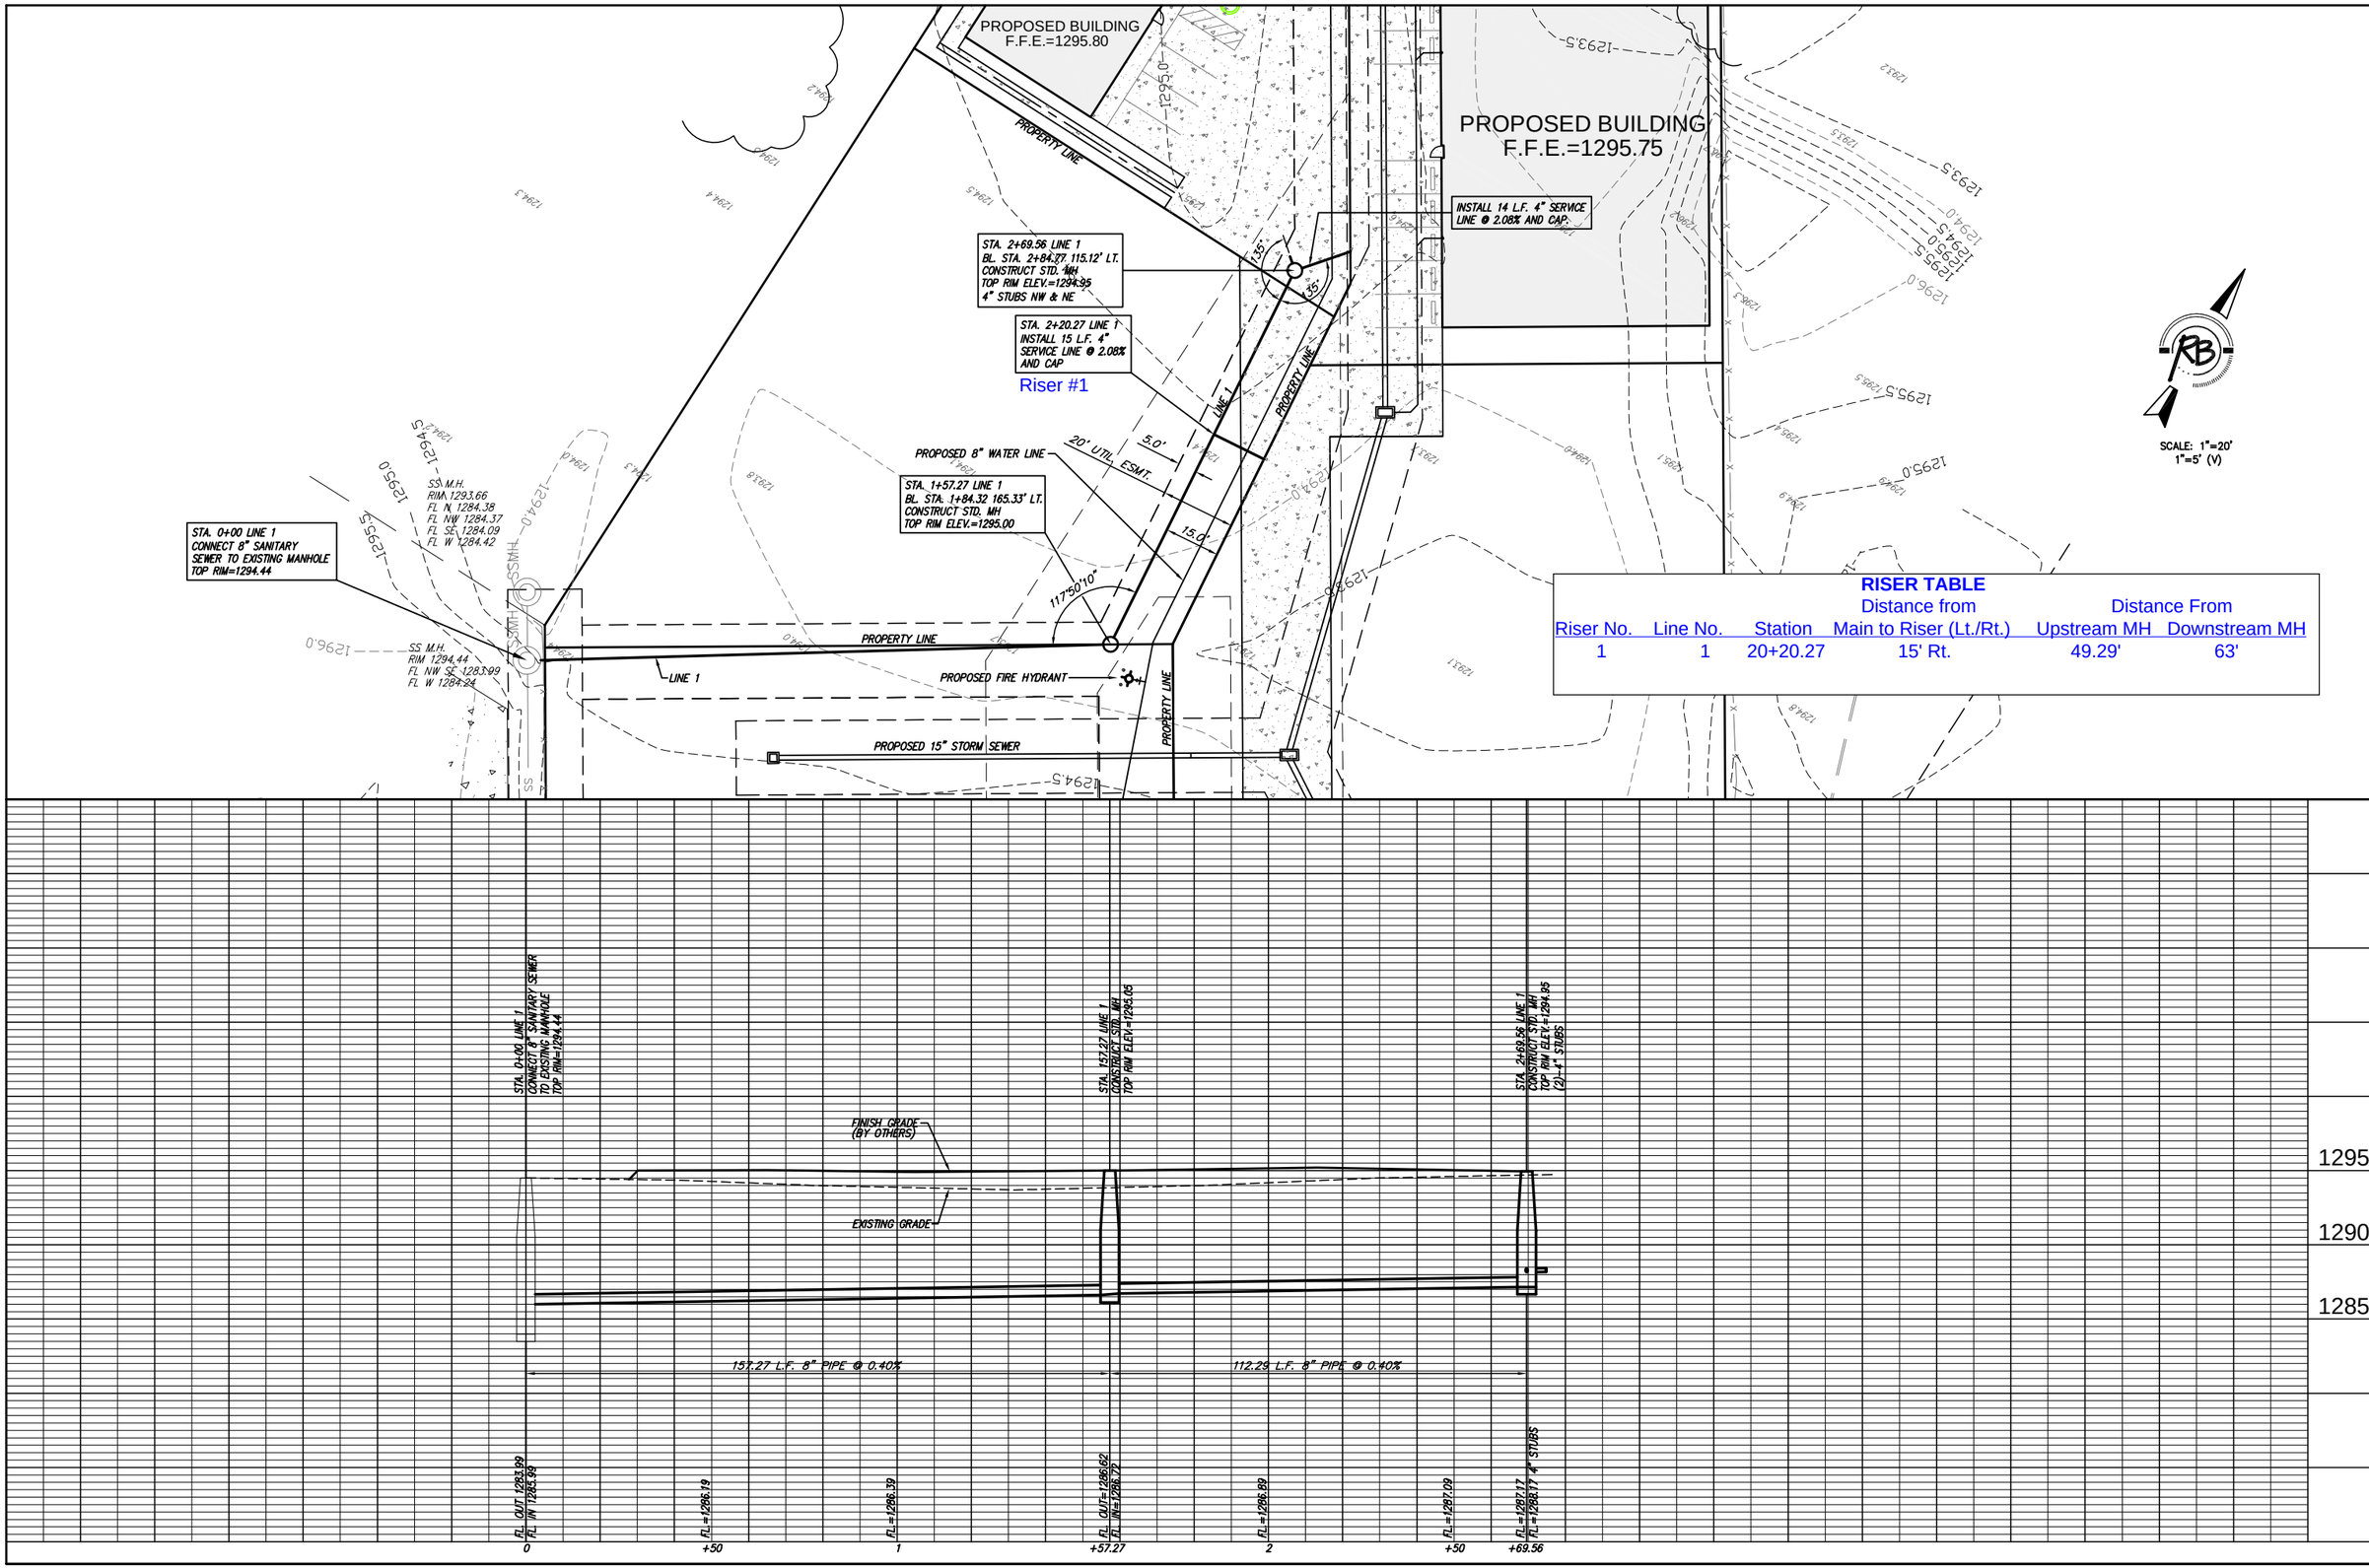

RISER TABLE

Riser No.	Line No.	Station	Distance from Main to Riser (Lt./Rt.)	Distance From Upstream MH	Distance From Downstream MH
1	1	20+20.27	15' Rt.	49.29'	63'

Ruggles & Bohm, P.A.
Engineering, Surveying, Land Planning
924 North Main
Wichita, Kansas 67203
www.ruggleslaw.com
(316) 264-8006
(316) 264-8080 fax
E-mail: info@ruggleslaw.com

DESIGN TCR
DRAWN EJB
DATE Jan. 2, 2007
UTILITY
REVISED
REVIEW

PROJECT NUMBER 468-84282
DRAWING FILE Engineering Base {Sanitary}

LOT 9 BLOCK A, SANTE FE ORIENT ADD.
SANITARY SEWER PLAN & PROFILE
WICHITA, KANSAS

RB JOB 2910E

SHEET 2 OF 6