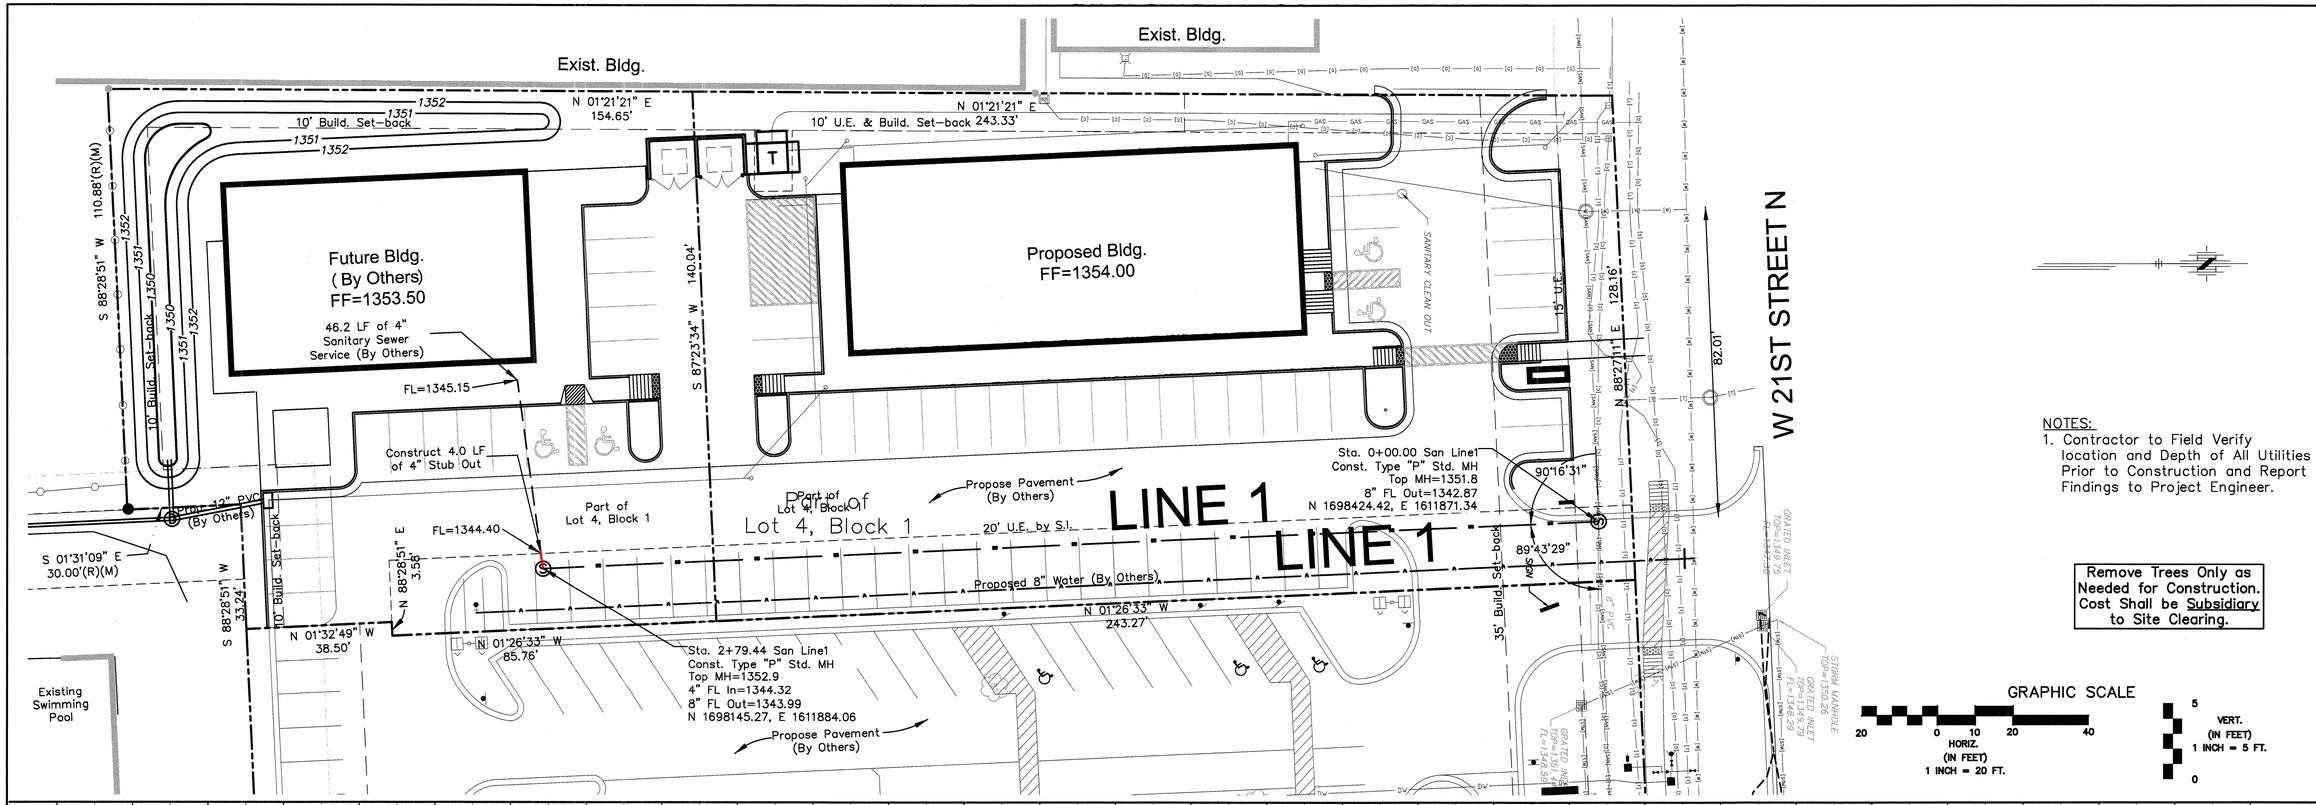

NOTES:

1. Contractor to Field Verify location and Depth of All Utilities Prior to Construction and Report Findings to Project Engineer.

Remove Trees Only as Needed for Construction. Cost Shall be Subsidiary to Site Clearing.

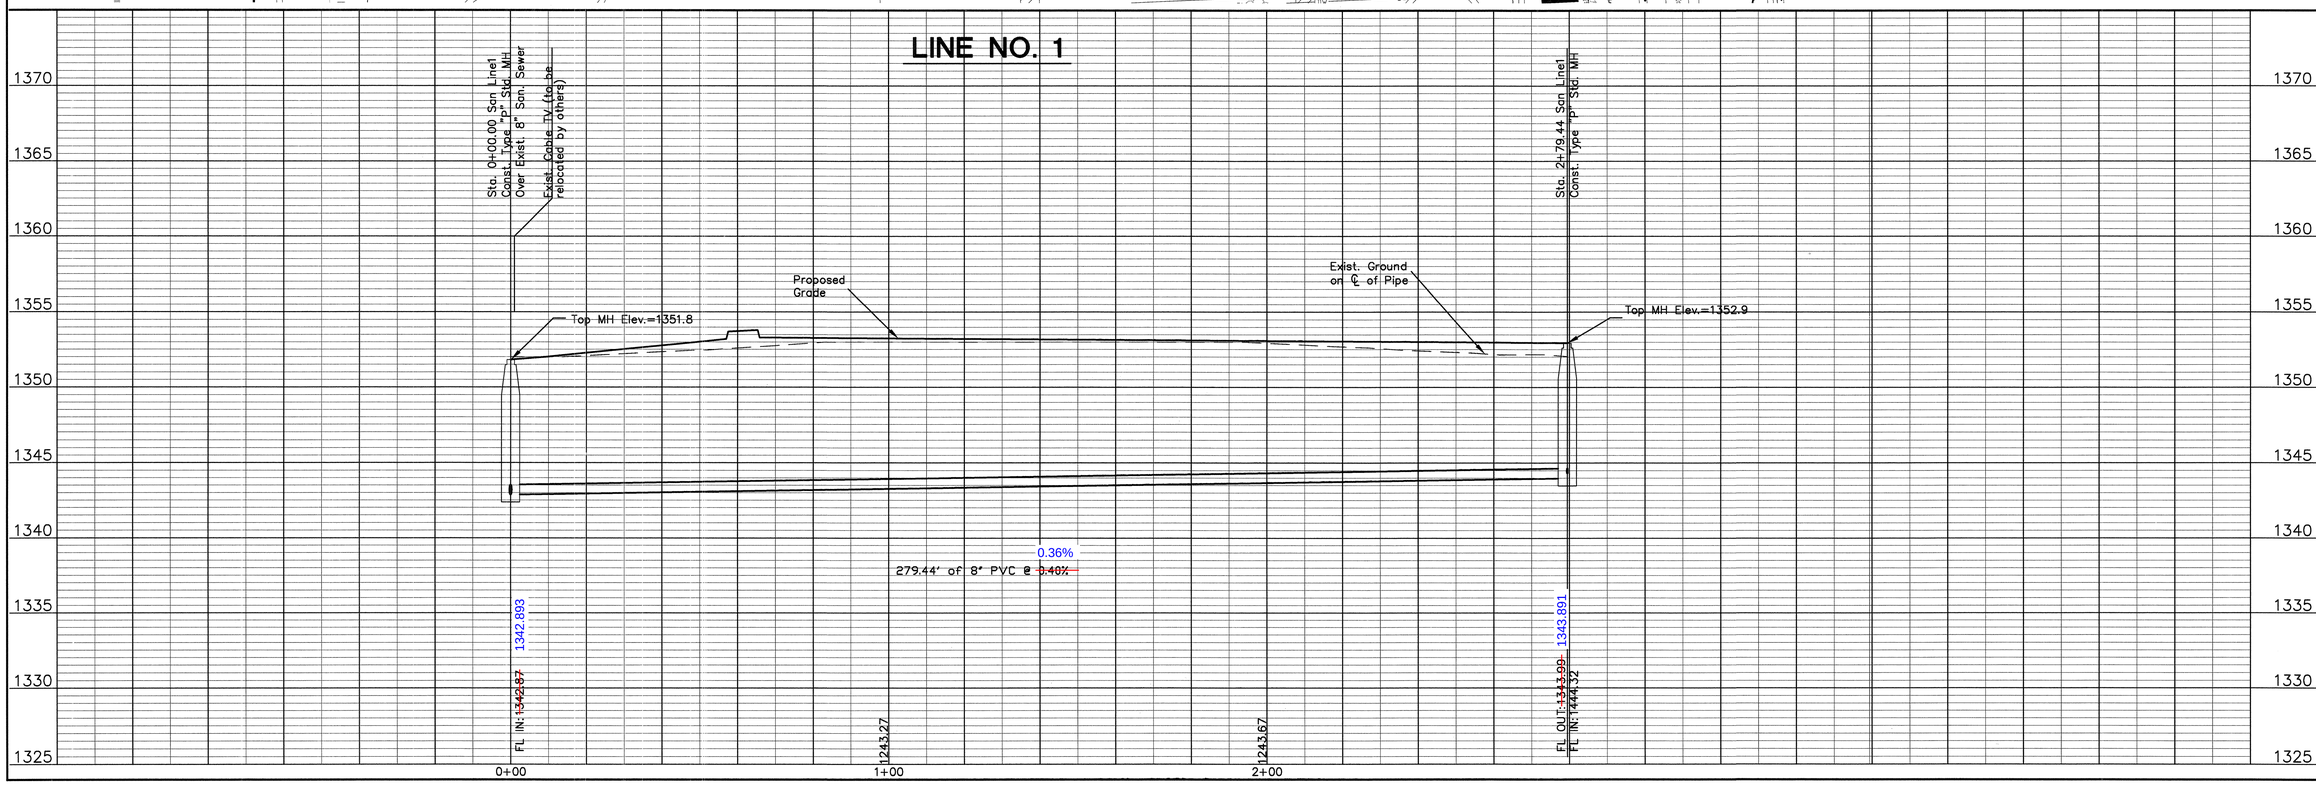

No.	Date	By	Approved	Revision

PEARSON FARMS 3RD ADDITION
LATERAL 538, SW INTERCEPTOR SEWER
LINE 1 PLAN AND PROFILE
CITY OF WICHITA, KANSAS
JAMES L. ARMOUR, P.E. - CITY ENGINEER
C.O.W. PROJ. NO. 468-84813 OCA 607861

POE & ASSOCIATES, INC.
CONSULTING ENGINEERS
5940 E. Central, Suite 200 □ Wichita, KS
67208-4242
Phone 316/685-4114 □ FAX 316/685-4444

SCOTT R. SERVIS
KANSAS
PROFESSIONAL ENGINEER
4/9/12

FINAL

Engineer: S. SERVIS
Designer: S. SERVIS
Drawing: P:\101994\101994grading.dwg
Date: 4/9/2012