SCALE:

PLAN: LAT. & LONG. 0 40 80

PROFILE: HORIZ. SAME AS ABOVE

VERT. 0 5

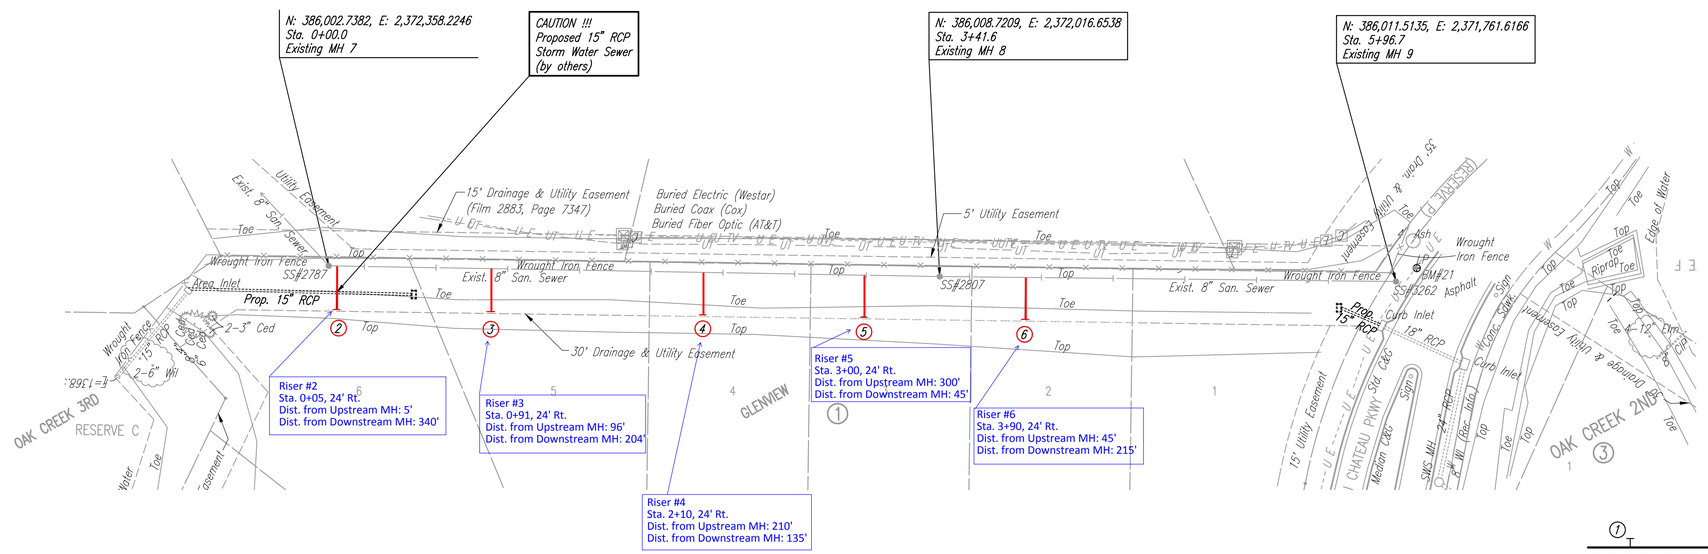

DENOTES SEWER SERVICE.
SEE SHEET NO. 9 FOR SEWER
SERVICE SCHEDULE AND DETAILS

EXISTING SANITARY SEWER LINE

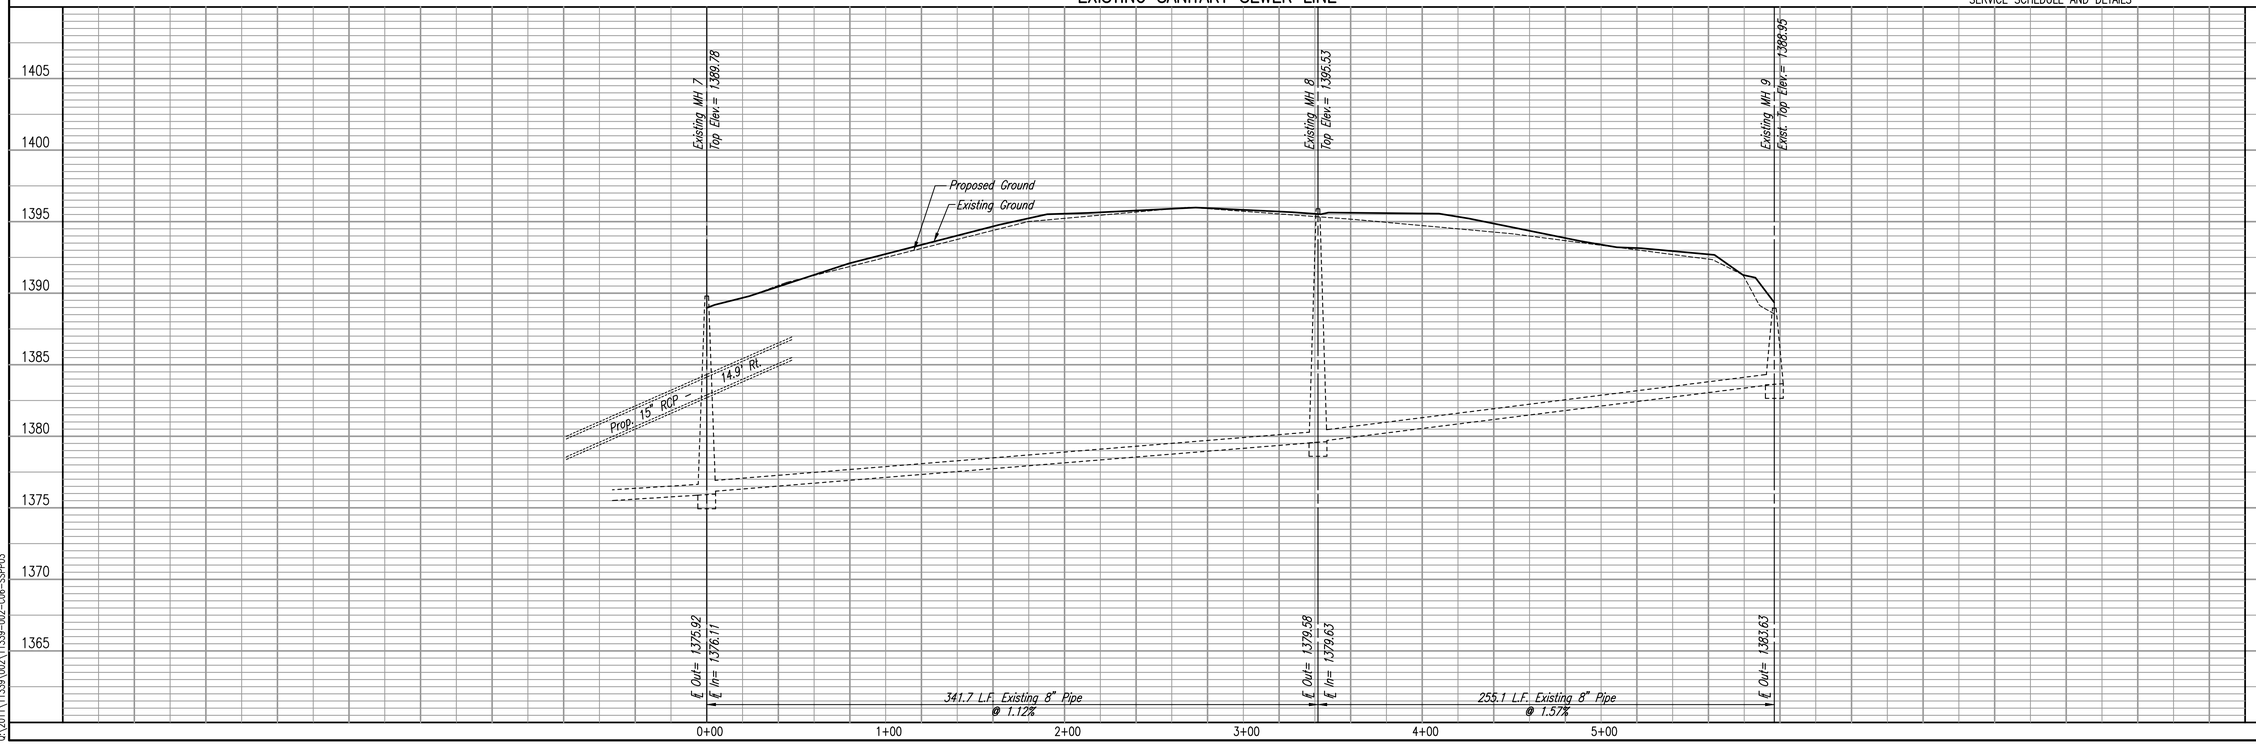

LATERAL 13, MAIN 16
OF THE FOUR MILE CREEK INTERCEPTOR

EXISTING SANITARY SEWER LINE

GARY JANZEN, P.E. – INTERIM CITY ENGINEER
CITY OF WICHITA PROJECT NO. 468-84818

PROFESSIONAL ENGINEERING CONSULTANTS, P.A.
303 SOUTH TOPEKA WICHITA, KS 67202
316-262-2691 www.pec1.com

Job No. 35-11339-001
Date August 2011

Designed By MDK
Drawn By JAN, CSL

Sheet 6 of 14

PLAN CHECKED CHECKED BY DATE

PROFILE CHECKED CHECKED BY DATE

Saved 05-30-2012 10:36:31 AM by RFJ
Plot Scale 1:40 06-01-2012 11:29:52 AM by ROB F. JOHNSON
Q:\2011\11339\002\11339-002-C06-SSPP03