

**SANITARY SEWER PLANS FOR
LAKESIDE ACRES FIRST
WICHITA, KS**

LINE 1
SHEET TITLE
468-84865
PROJECT NUMBER

GJA / BKS / GJA
DESIGNED / DRAWN / CHECKED

ISSUED
January 2013


REVISED

SHEET NO.
3 of 9


Plat Irons			
Point #	Raw Description	Northing	Easting
200	PI	1697753.4069	1691493.7317
201	PI	1697752.0621	1691393.7407
202	PI	1697453.4403	1691498.2142
203	PI	1697451.3237	1691340.8285
204	PI	1697328.0502	1691357.7523
205	PI	1697207.2537	1691359.5574
206	PI	1697209.1676	1691501.8645

Section Corners			
Point #	Raw Description	Northing	Easting
208	SC	1699865.8400	1691512.1700
207	SC	1697209.8400	1691551.8600

Sanitary Manholes			
Point #	Raw Description	Northing	Easting
209	SM	1697718.5729	1691454.2477
210	SM	1697318.6175	1691460.2245
211	SM	1697180.9410	1691476.1661
212	SM	1697160.3573	1691587.8059

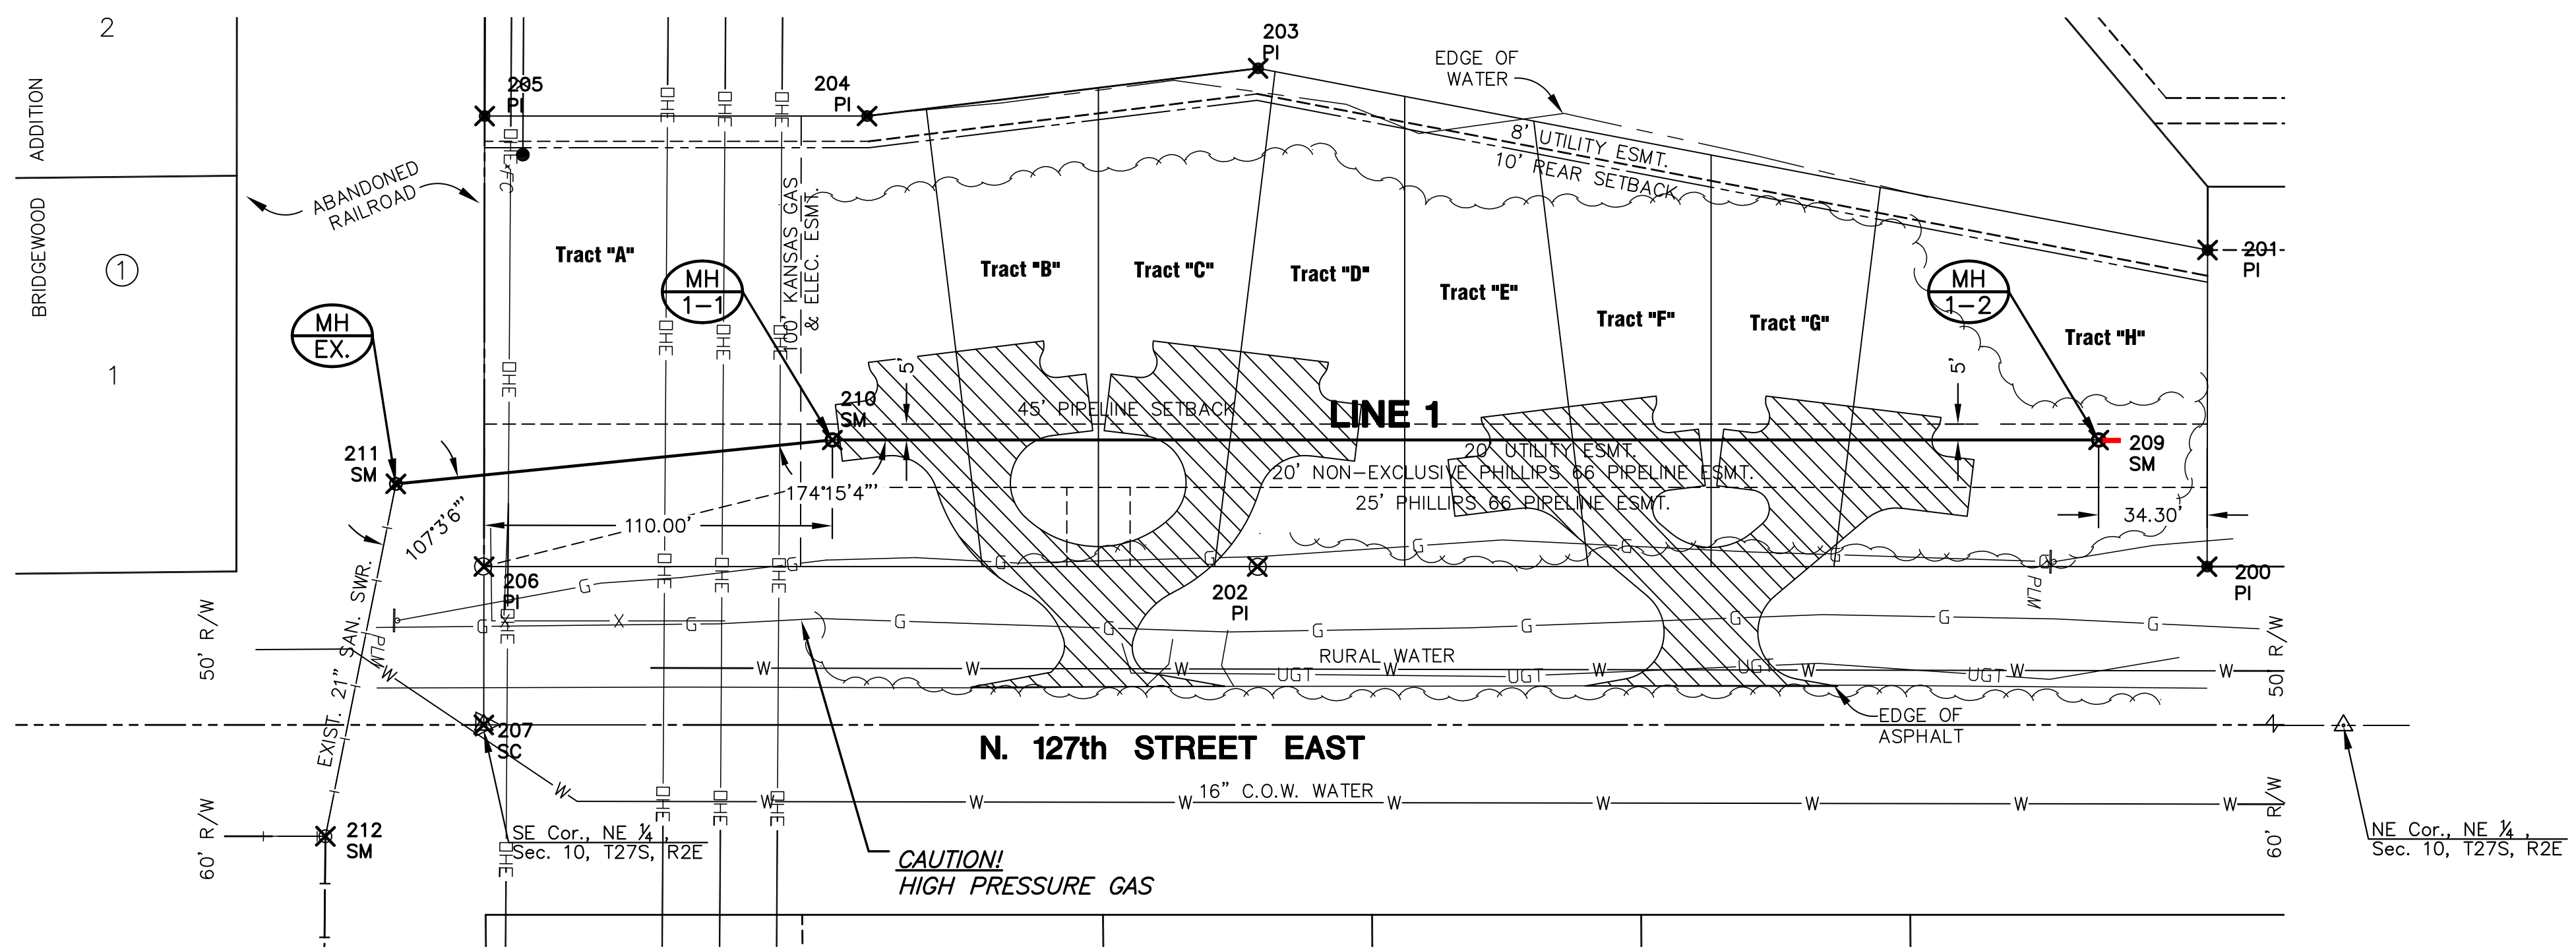

**PLAN LINE 1
PROFILE LINE 1**

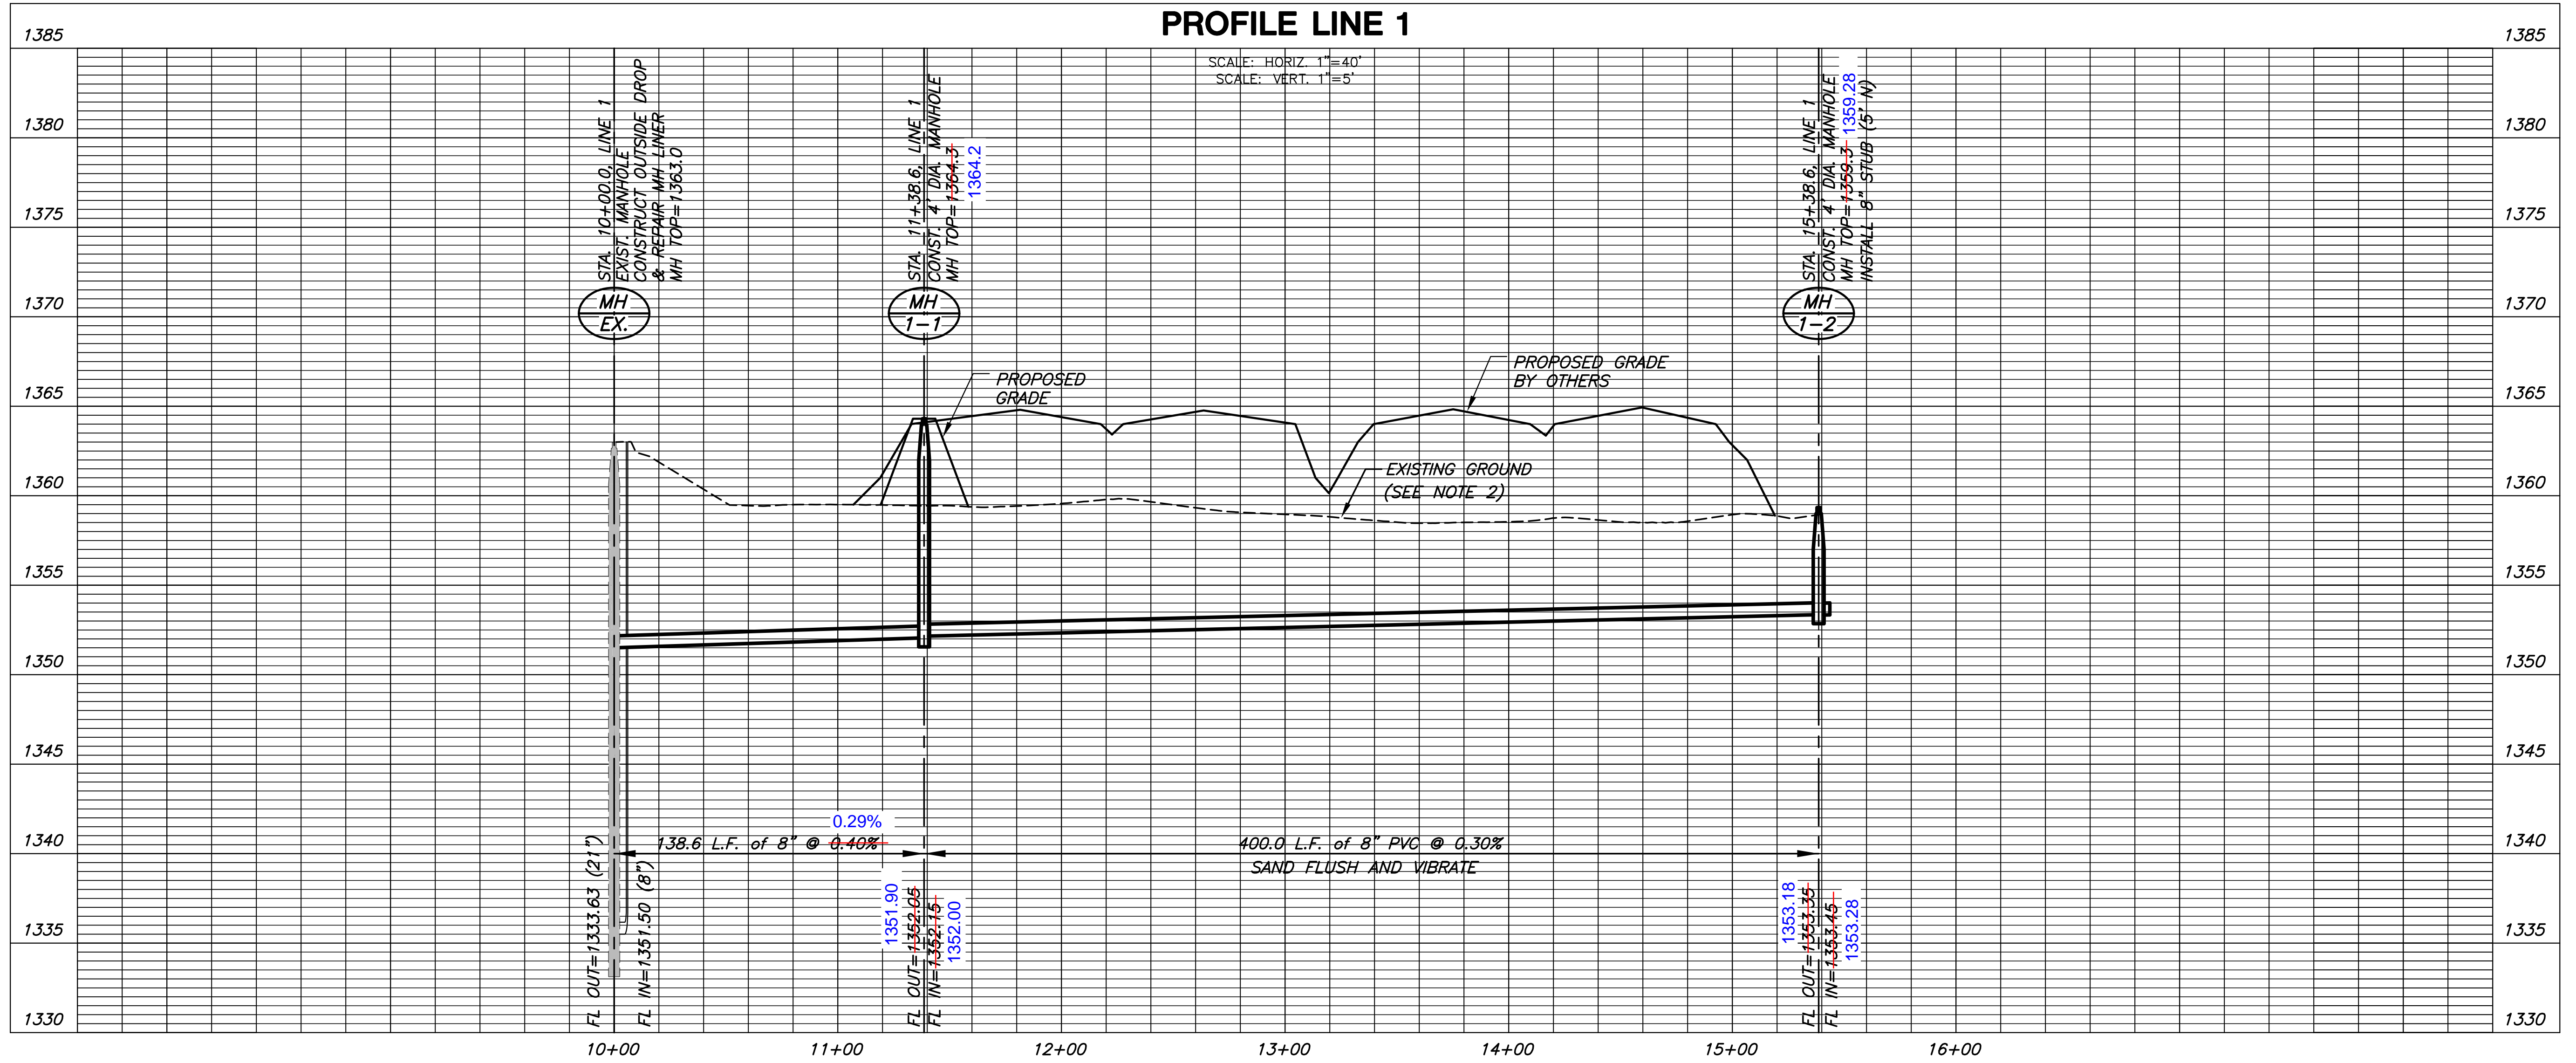

- NOTES:**
- Contractor to verify the depth and location of existing utilities prior to construction.
 - Existing ground profile may vary due to imported fill. Contractor to verify existing ground during bidding process.
 - Trenches to be backfilled with sand and flushed between MH 1-1 and MH 1-2.

