


Manhole Grading Detail  
(Typical)

SEWER SERVICE TABLE

NUMBER	TYPE	LOCATION			FOR INFORMATION ONLY		Distance from		
		LOT NO.	BLOCK NO.	LINE NO.	STATION \ DIRECTION	APPROXIMATE LENGTH 4" PIPE VERTICAL	HORIZONTAL	Upstream MH	Downstream MH
21	8" X 4" Tee	21	5	3	0+80/Rt. 0+81.5	10.0'	8.0'	68.5'	81.5'

NOTE: Vertical Riser Pipe shall be extended to 2' minimum above ground water elevation and 4' maximum below proposed ground elevation.

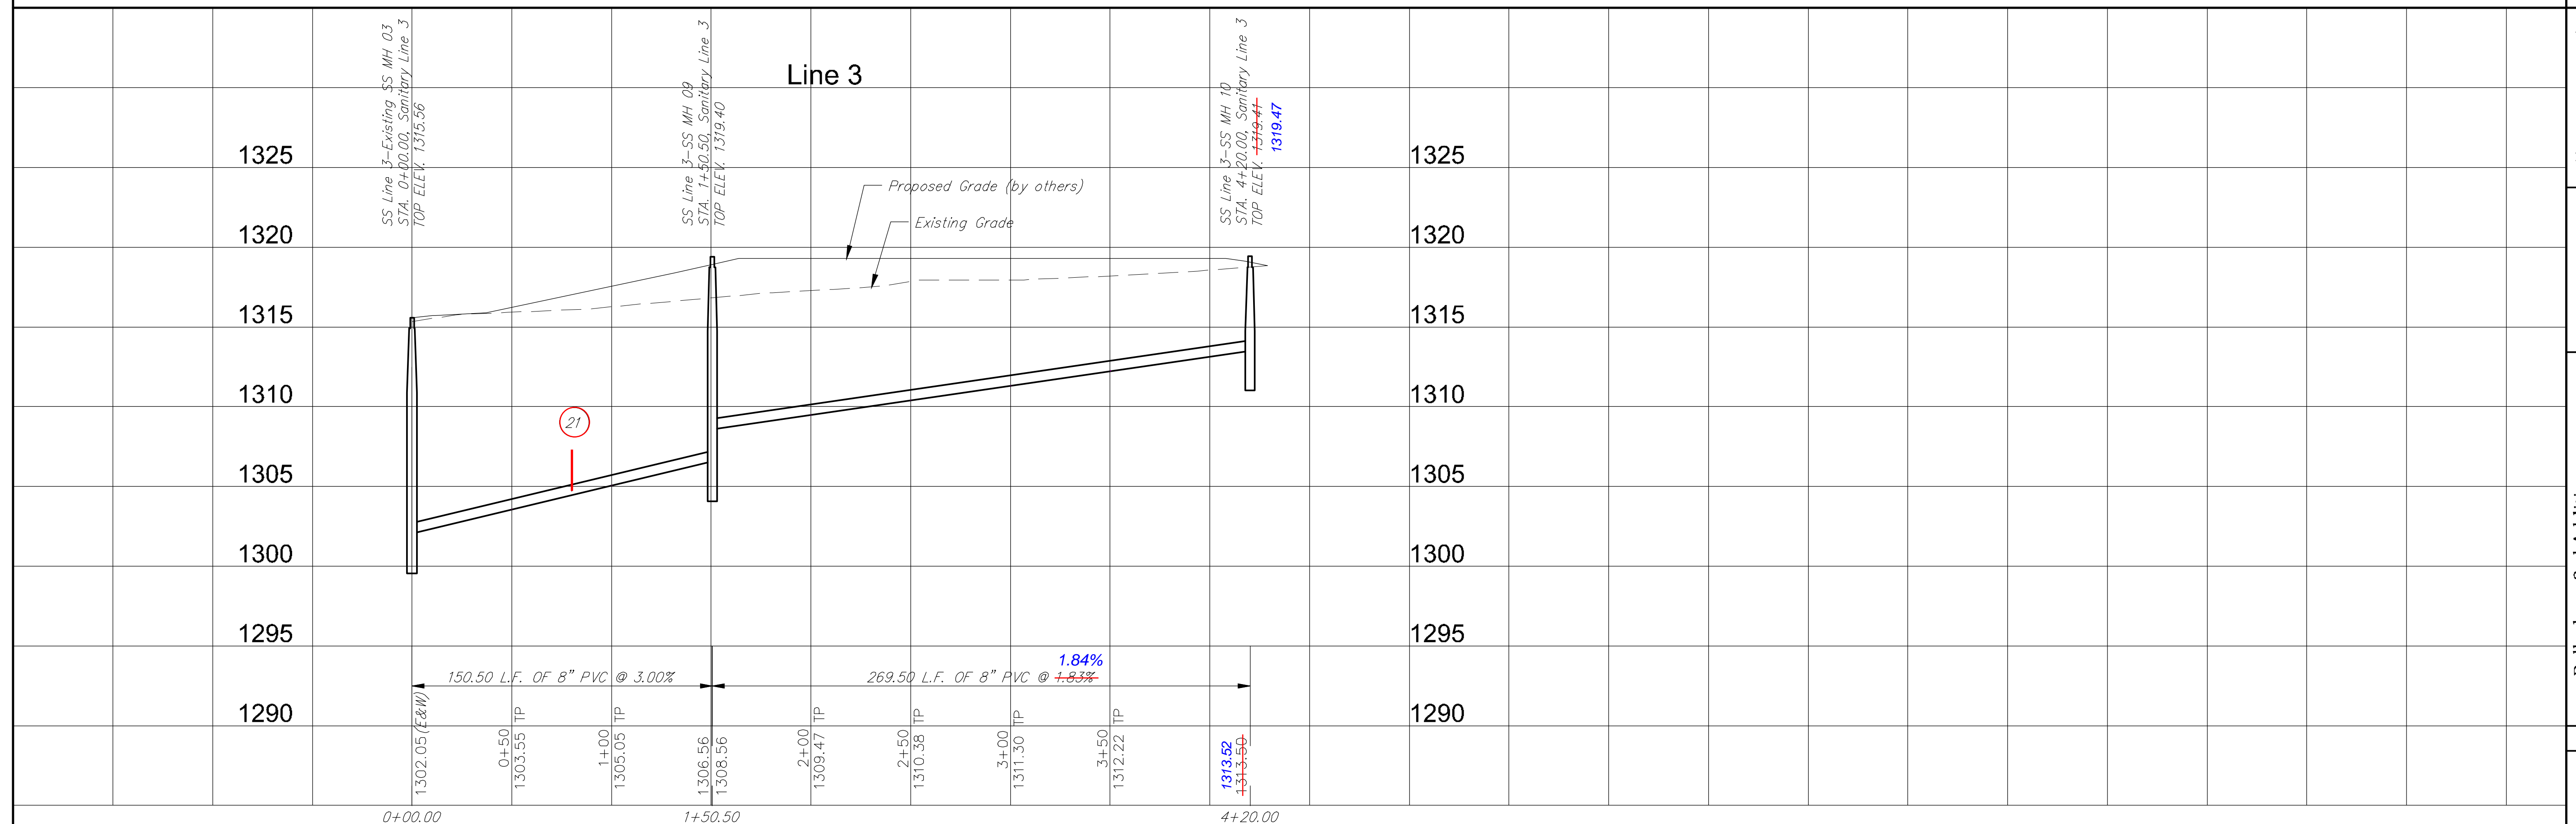

**RUGGLES BOHM**  
 PROFESSIONAL SURVEYING | LANDSCAPE ARCHITECTURE | CIVIL ENGINEERING  
 1001 W. 17th Street, Suite 100, Wichita, KS 67202  
 PH: 316.261.1111 | FAX: 316.261.1112 | WWW.RUGGLESBOHM.COM

PROJECT NUMBER: 468-64658  
 DRAWING FILE: Eng Base (SS Line 1 & 1A)

DESIGN EUG  
 UTILITY DATE: Feb. 5, 2013  
 REVIEW DATE:

BELLECHASE 3RD ADDITION  
 SS LINE 2A & 3  
 WICHITA, KANSAS

RB JOB: 4057E  
 SHEET: 4 OF 15